


CONSTRUCT APPROACHES		CONSTRUCT DOWNS		GUIDE POSTS		
LT	RT	LT	RT	Sta.	Lt.	Rt.
107+38		105+40	103+40	102+50	1	1
		107+35		108+13		
		108+04		110+60	1	1

NON-GOVT PARTICIPATION  
INSTALLING WATER PIPE SLEEVE  
STA. 110+00 TO 117  
Install sleeve for water pipe across roadway from 103 Non Govt  
Sleeve to be furnished by property owner

CABLE GUARD RAIL  
Sta. Sta. Pos. Lt. Rt.  
108+60 111+40 Rt. 280  
109+65 112+65 Lt. 240

PERMITS  
DATE  
GRANTOR  
GRATIFEE  
RECORDED  
BOOK  
PAGE  
DATE  
LETTERS

#17  
W.D.O.E.  
11-18-50  
WARD J. & DOROTHY B. JONES  
Sr. of Vr.  
JOHNSON  
35  
281  
1-16-51

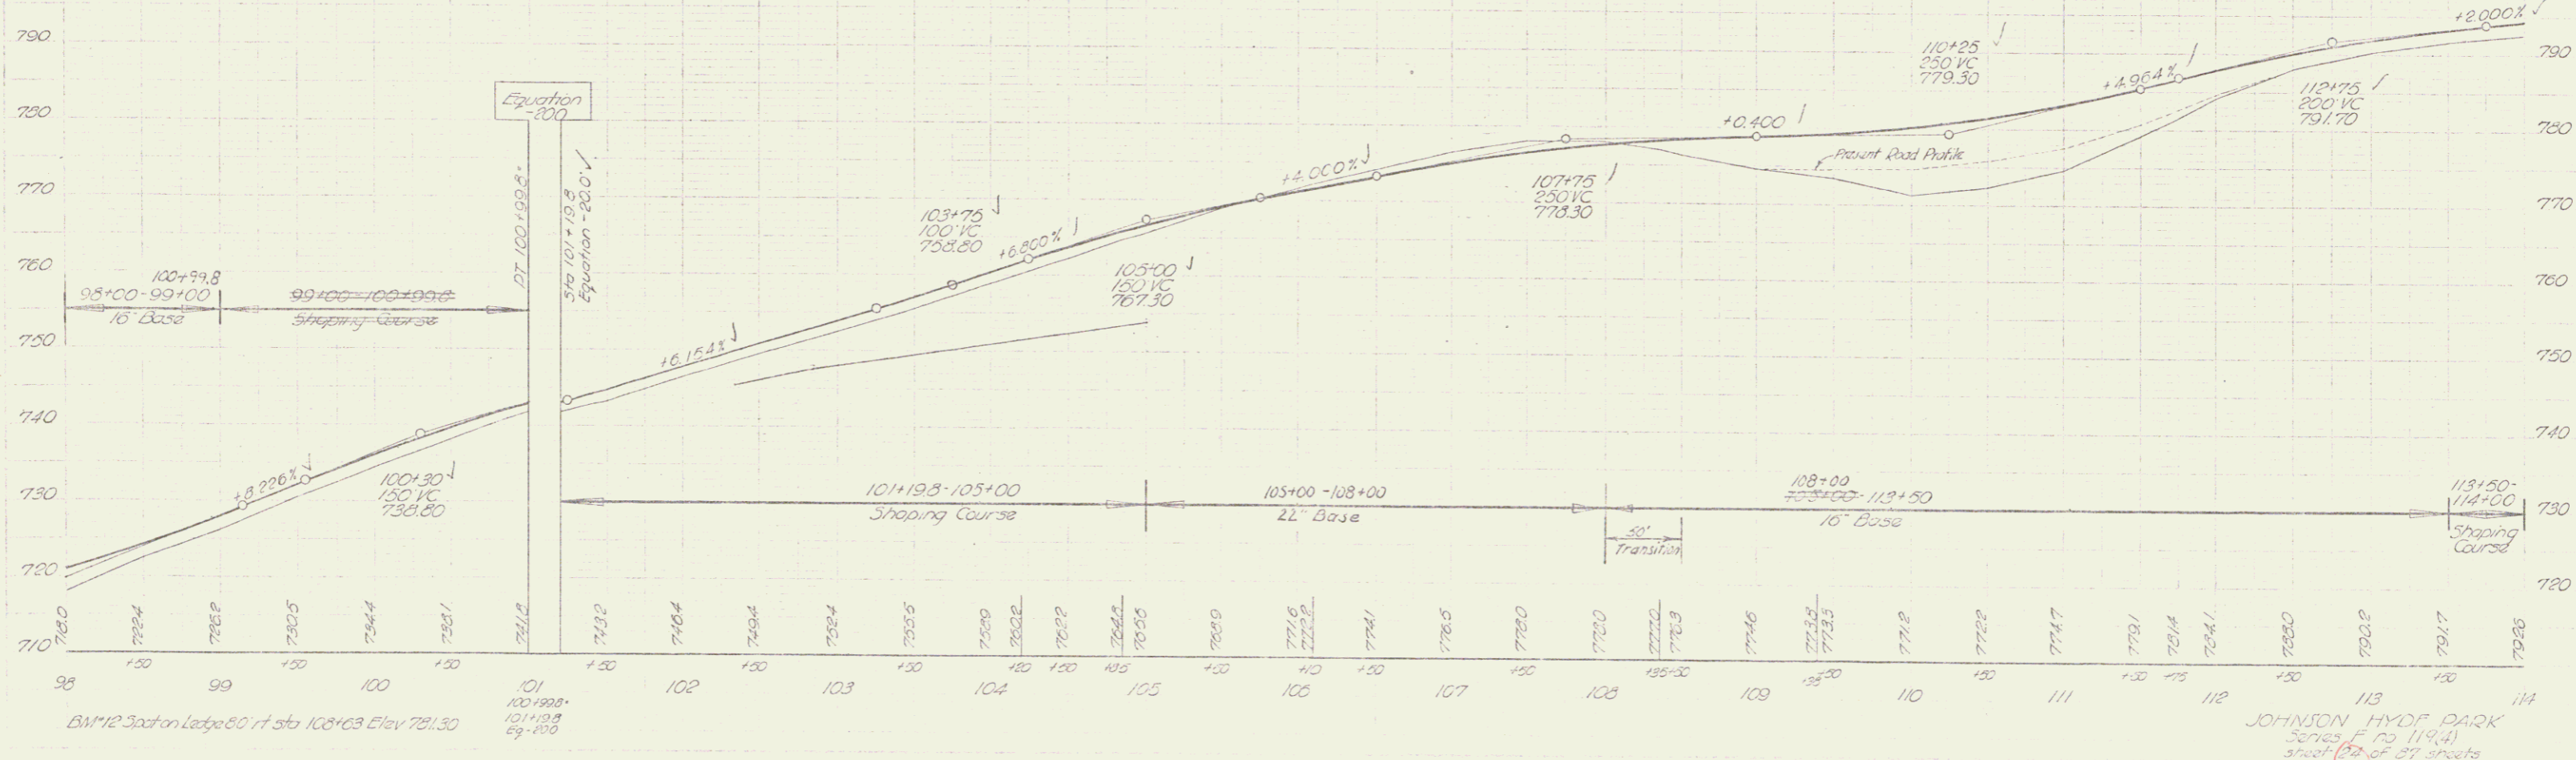

JOHNSON HYOF PARK  
Series F 72 1194  
Sheet 19 of 27 sheets