

CABLE GUARD RAIL

Sta	Sta	FCs	LF
160+45	161+28	LT	80
160+80	161+44	RT	64



GUIDE POSTS

Sta	Ln	Rt
157+70	1	1
162+40	1	1
165+58	1	1
165+83	1	1

CONSTRUCT APPROACH
161+30 LT V

CONSTRUCT DRIVES
LT RT
157+2270 162+0000
153+33
163+70-166+50
160+70

NON GOVT PARTICIPATION
INSTALLING WATER PIPE SLEEVE
Sta 165+70-166+50
Install sleeve across roadway. Item 103 Non-Govt
Sleeve to be furnished by property owner.

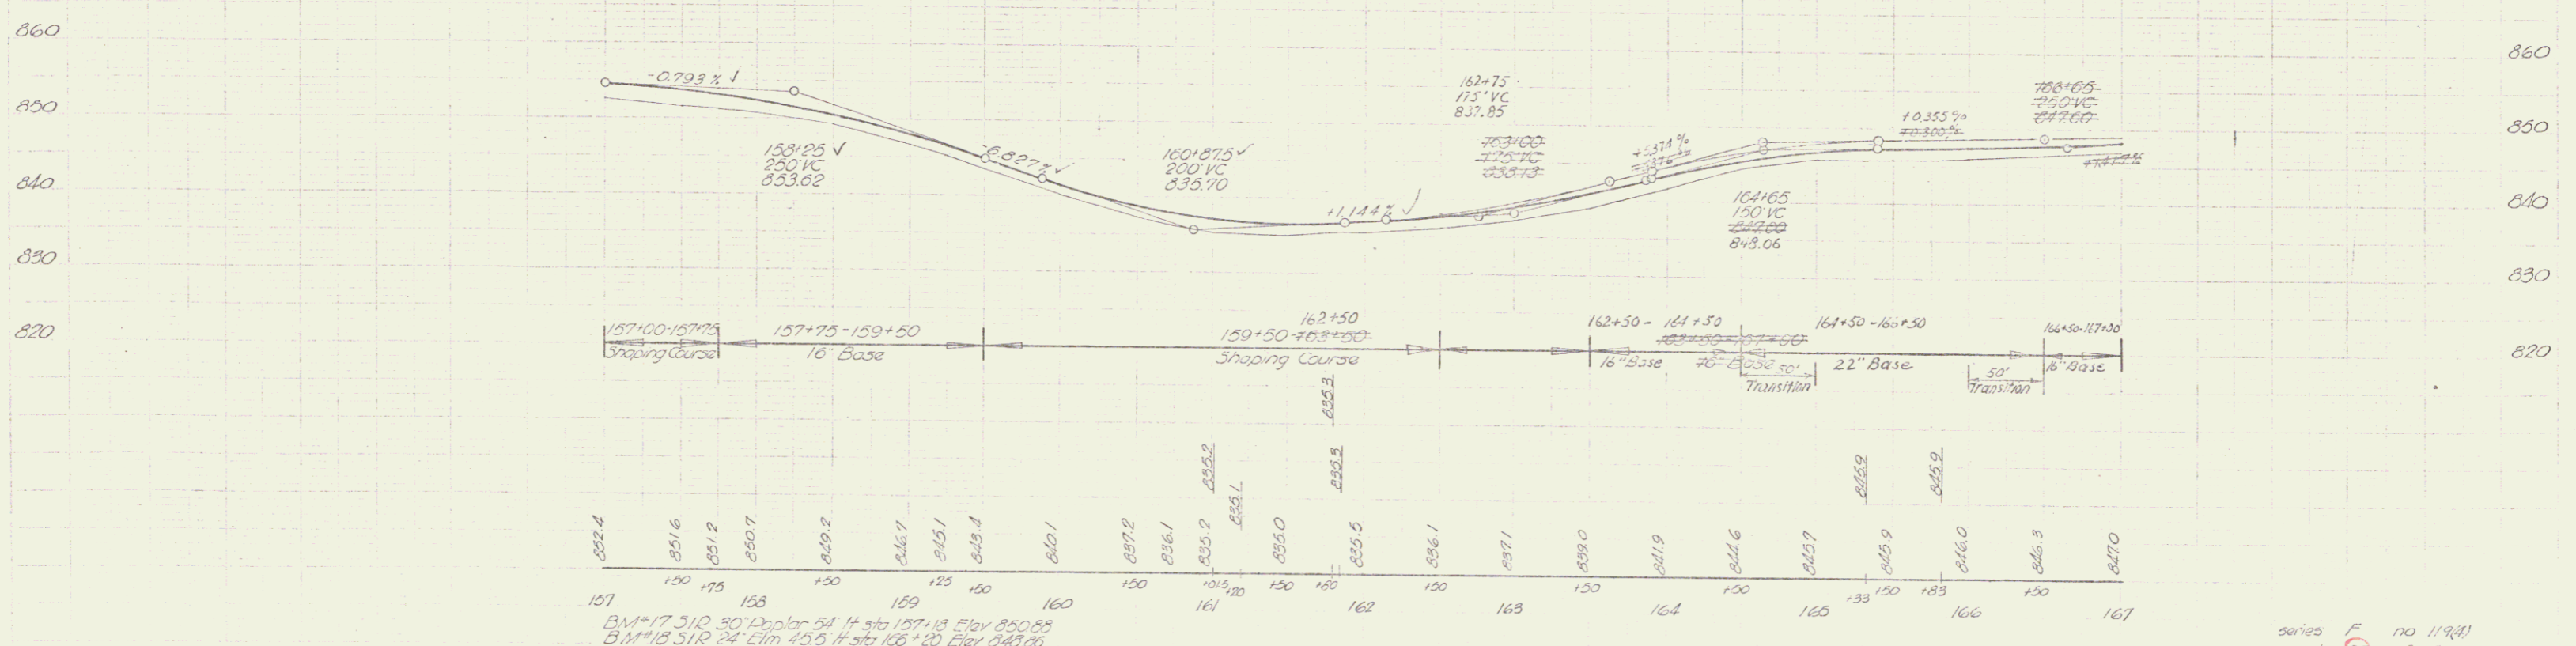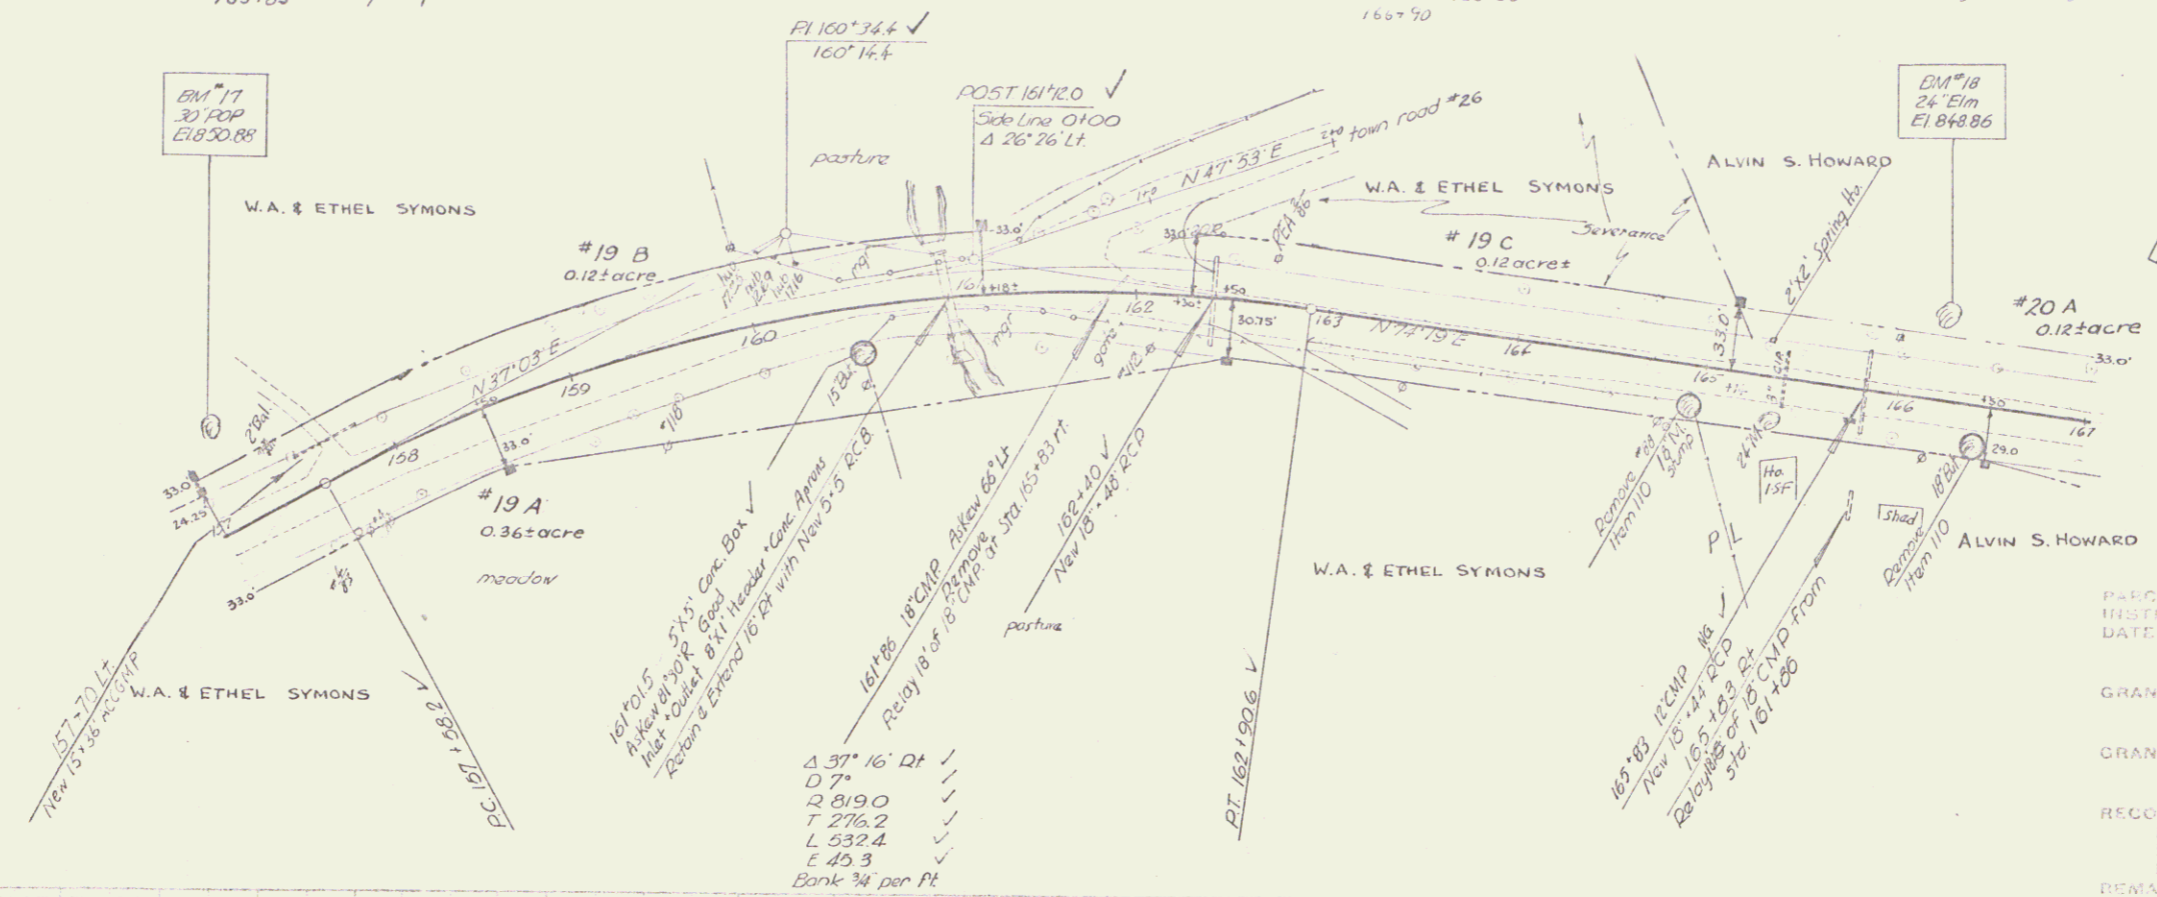

BM #17 310 30' Poplar 54 ft Sta 157+18 Elev 850.85
BM #18 24' Elm 45.5 ft Sta 166+20 Elev 848.66

series F no 11931
sheet 29 of 37
JOHNSON - HYDE PARK