


PROPERTY LINE FENCE  
31+00-47+00 L.F.  
31+00-45+50 R.F.

JUTE MATTING, ITEM 625 \*  
42+00-44+50 D.F.  
42+00-44+50 U.F.

CHAIN LINK FENCE  
45+50-47+00 D.F. (50 L.F. x 6' high)


CONTROL OF ACCESS IS COMPLETE ON THIS SHEET.

PLAN	NO. 1	DATE	1/15/71
DESIGNED BY	W. J. HARRIS	CHECKED BY	L. J. HARRIS
DRAWN BY	W. J. HARRIS	DATE	1/15/71
SCALE	AS SHOWN	PROJECT NO.	154

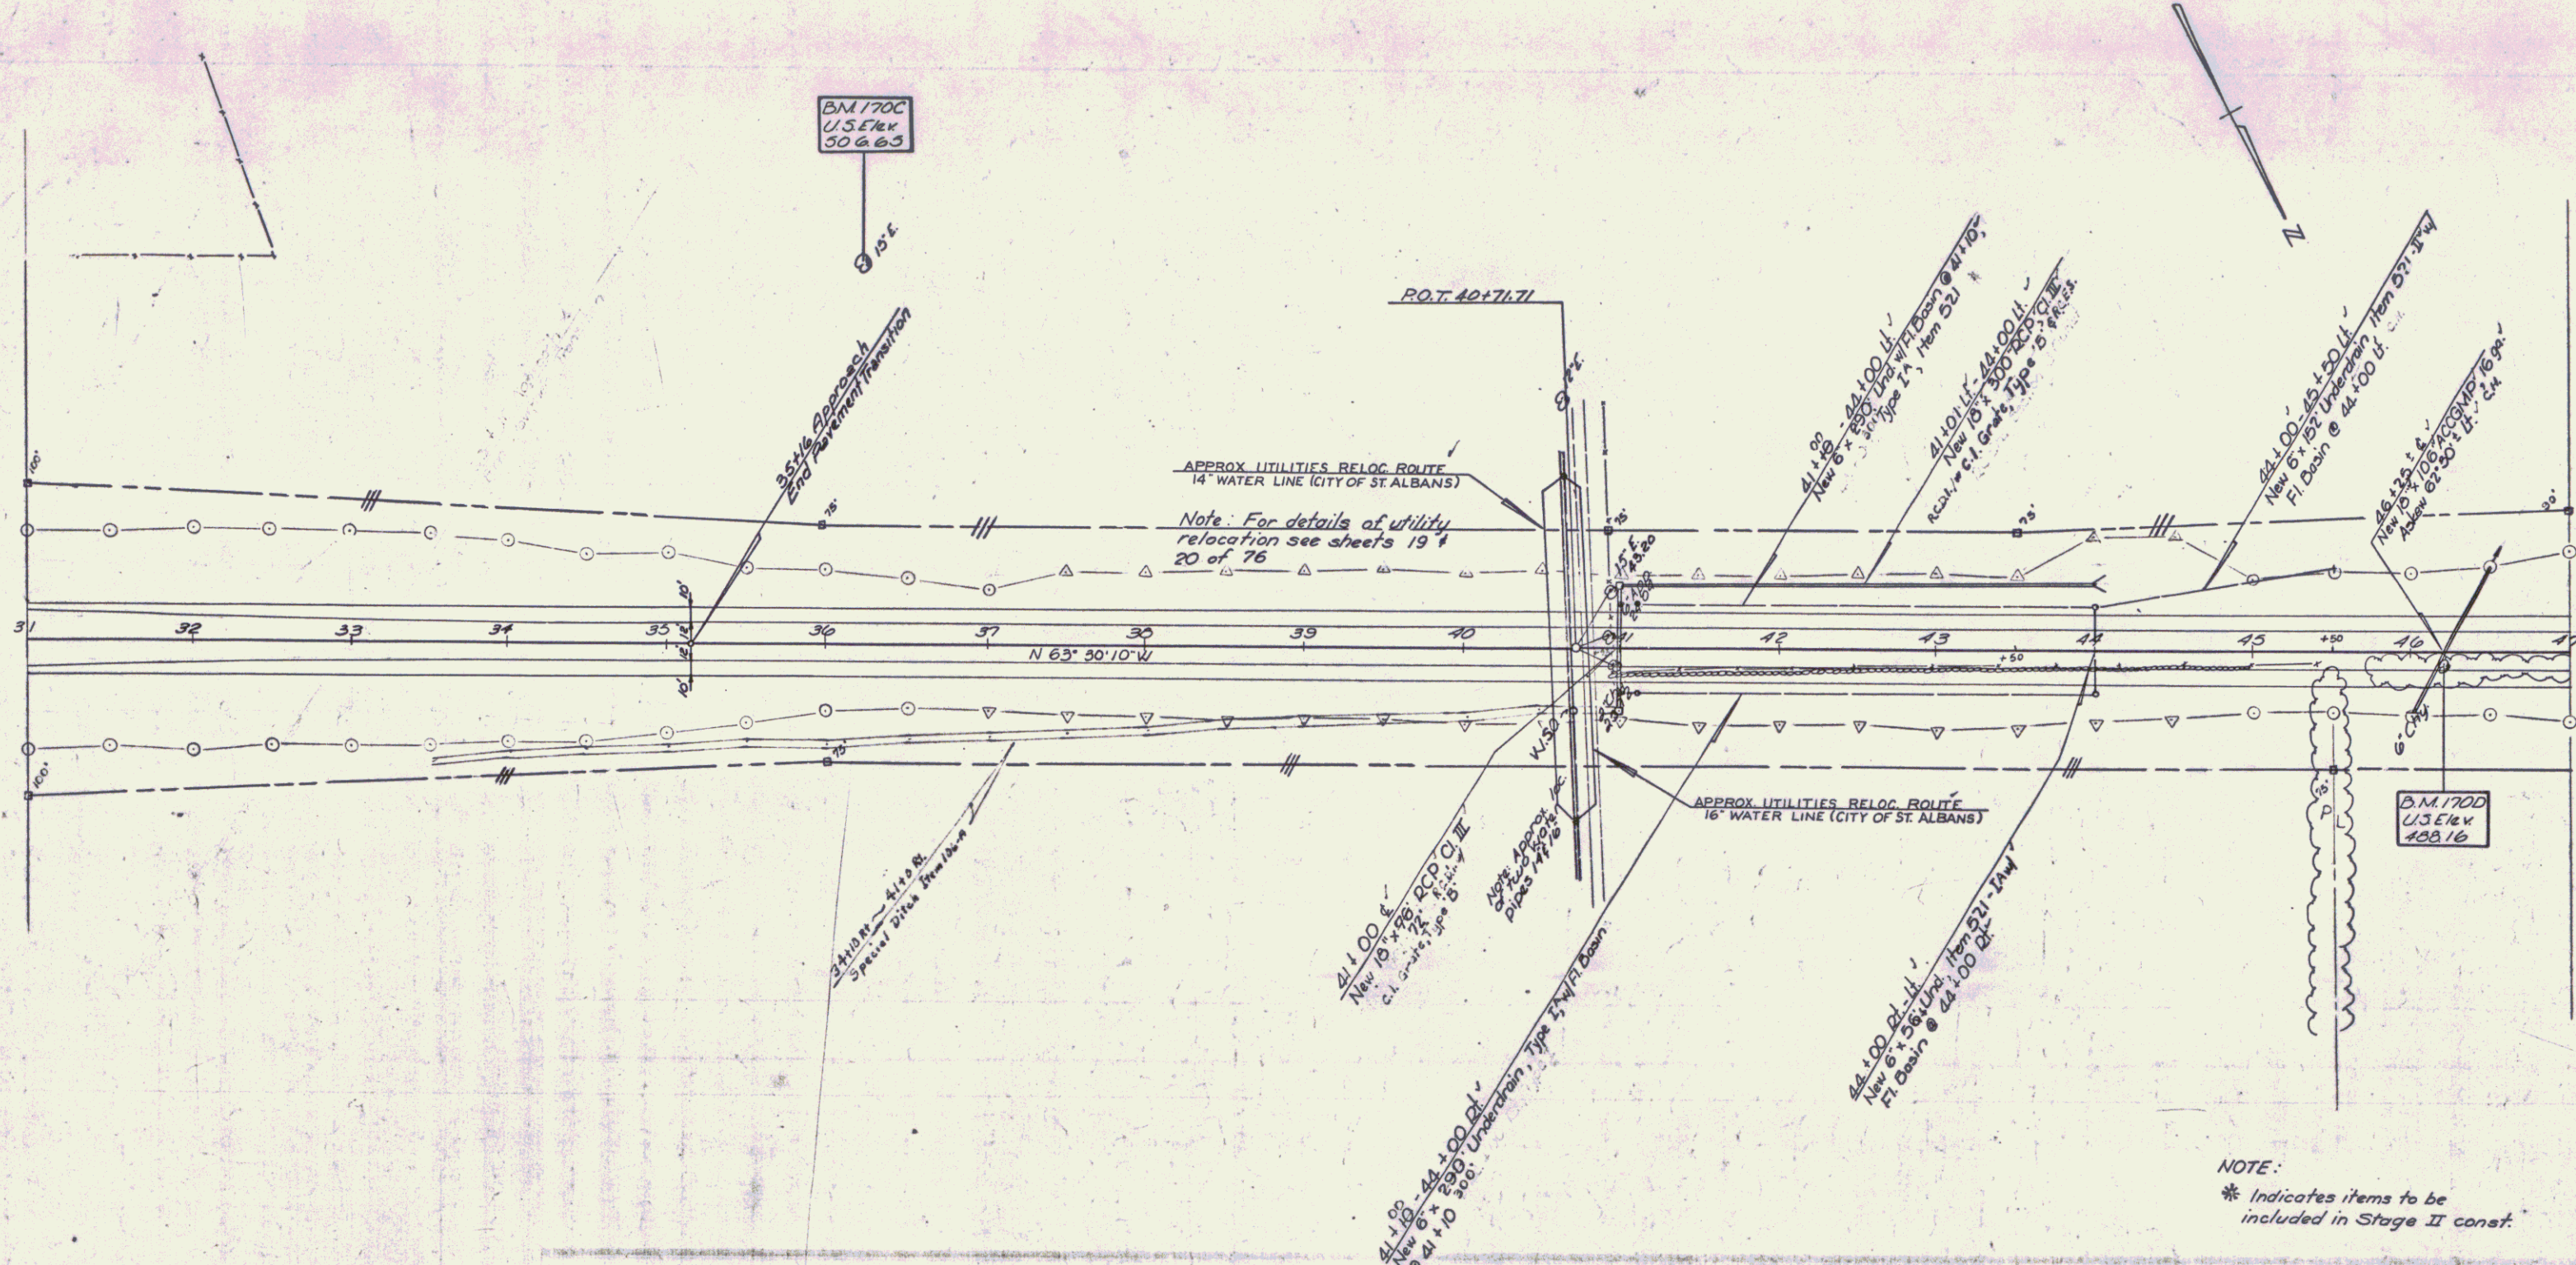

Note: For details of utility relocation see sheets 19 & 20 of 76

NOTE:  
\* Indicates items to be included in Stage II const.

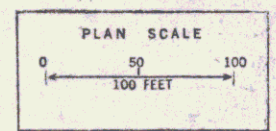

Stage I Construction  
ST ALBANS  
E 119-511 (3)  
Sheet 154 of 213