


PROPERTY LINE BOUNDARY
3/1/00-45-20-21

DATE: MAY 11, 1998
BY: J. D. [unclear]
3/1/00-45-20-21

SCALE: 1" = 40' (PLAN)
1" = 10' (VERTICAL)

POOR ORIGINAL COPY

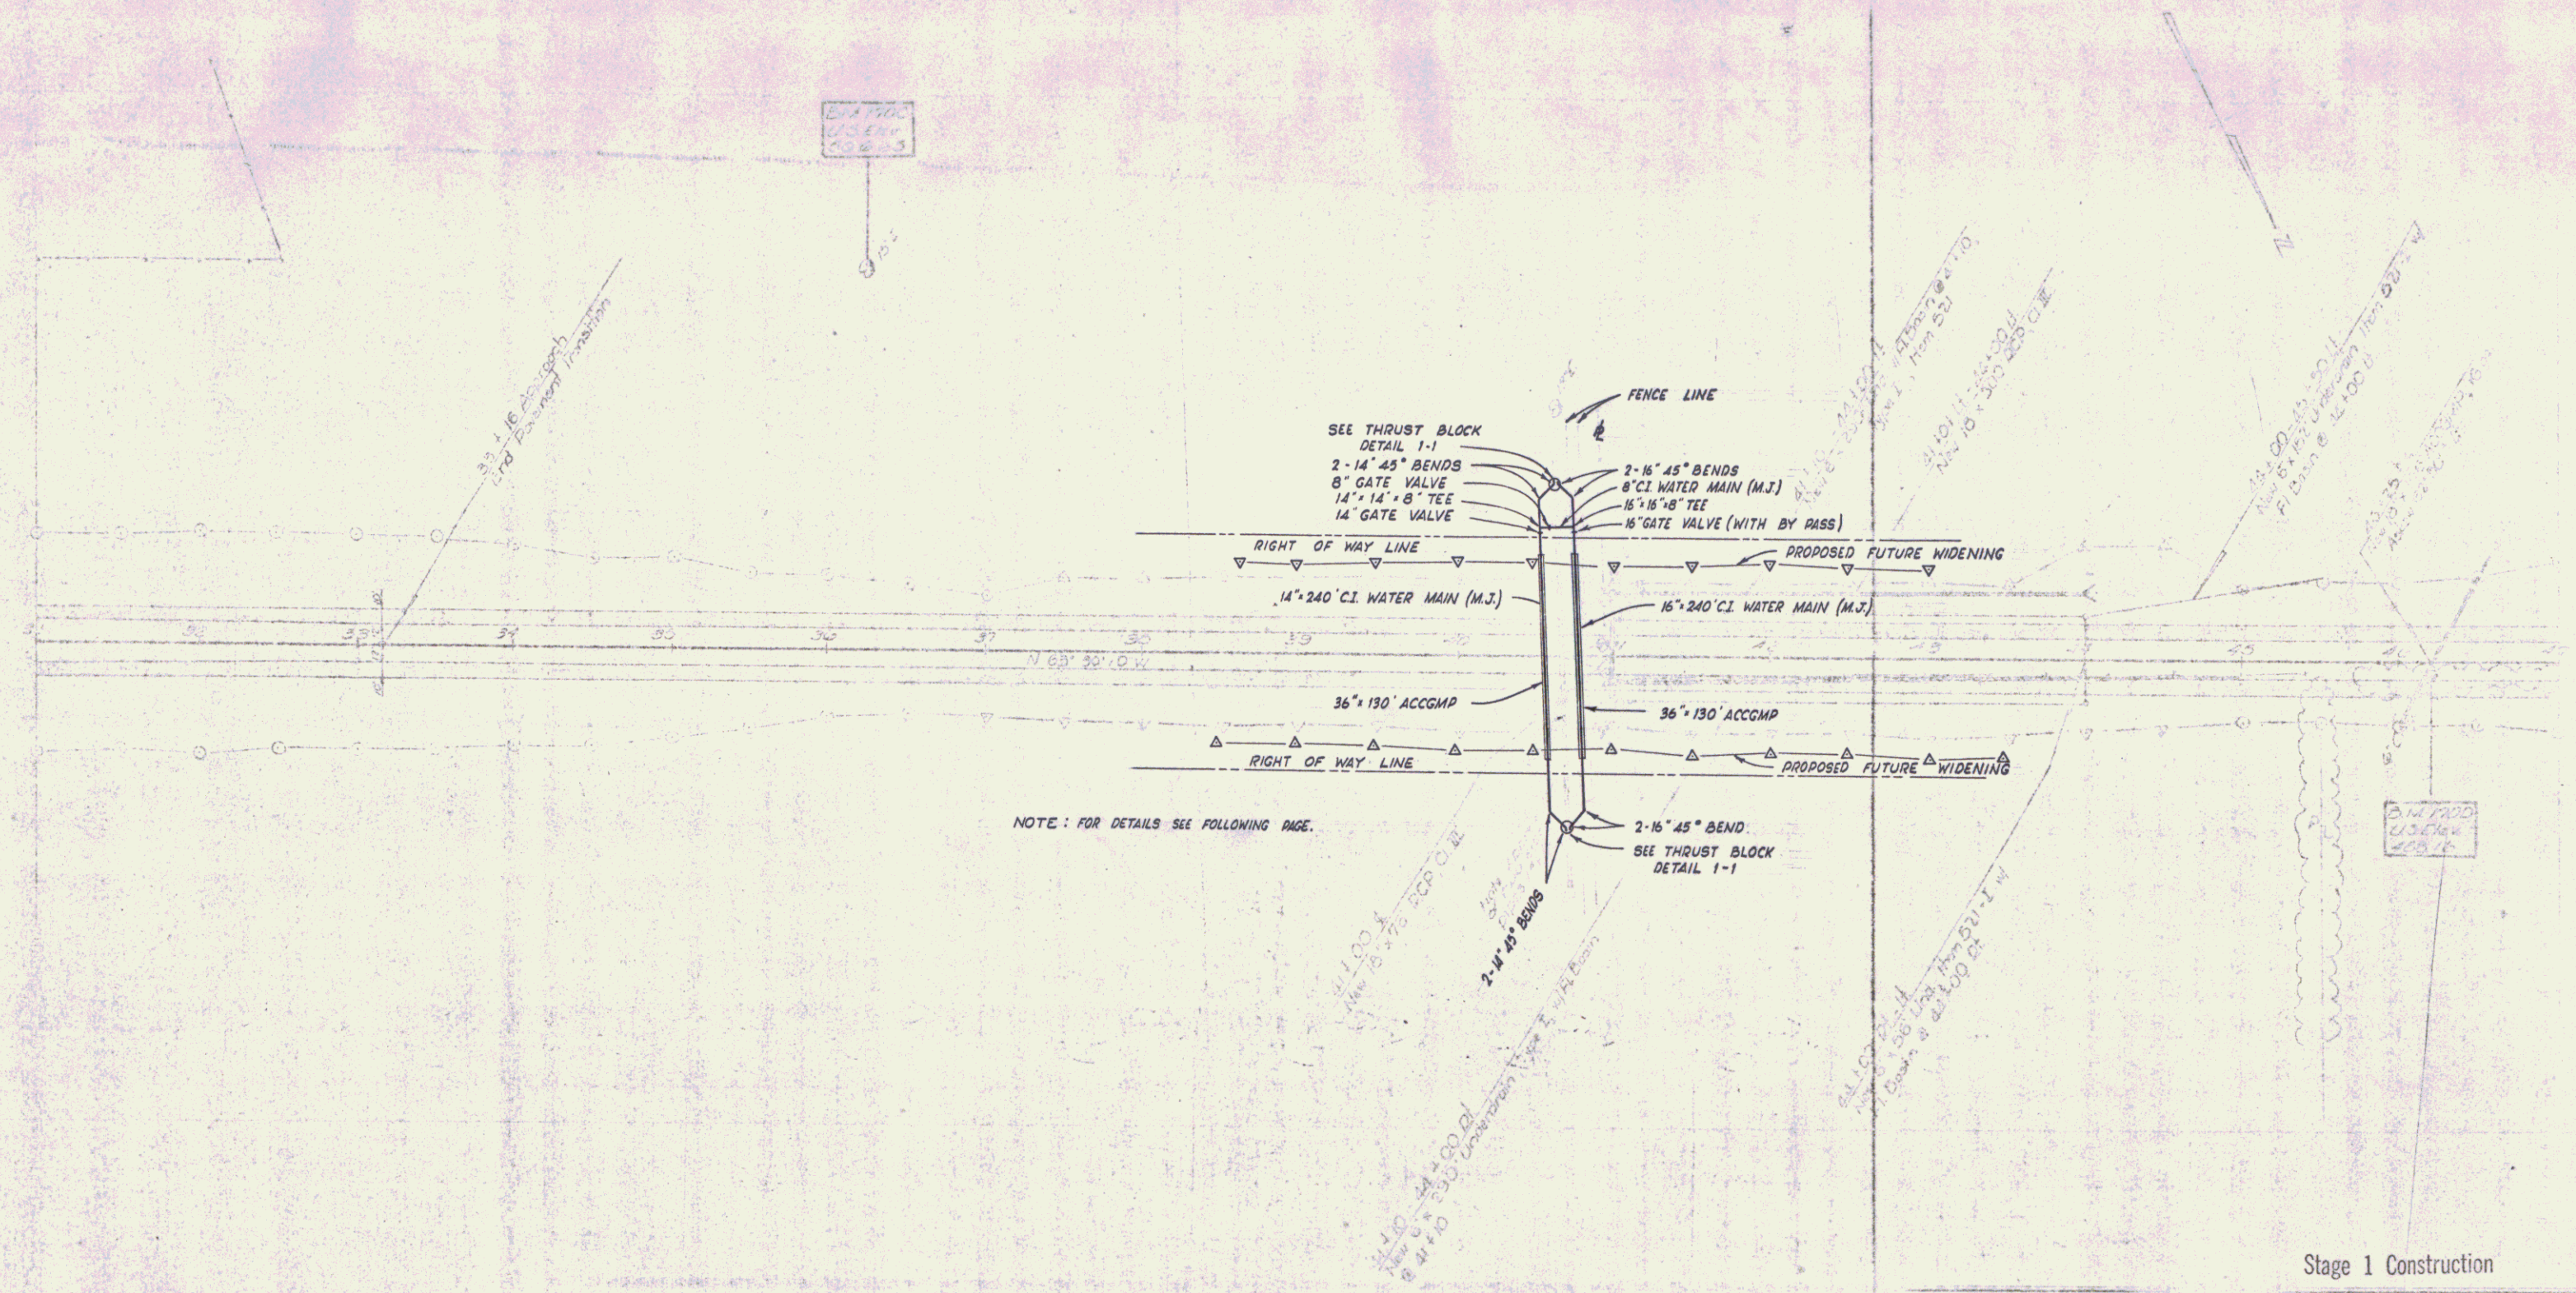

NOTE: FOR DETAILS SEE FOLLOWING PAGE.

Stage 1 Construction