

DATE	
BY	
CHECKED	
APPROVED	
PROJECT	
NO.	
SCALE	

DRILLING & BLASTING of SOLID ROCK
 SUBGRADE, ITEM 115
 64+00 - 68+00
 63+25 - 67+92

* Seeding, Item 611
 Fertilizer, Item 615
 Topsoil, Item 621
 63+00 - 65+00 Island

* VERTICAL CURB
 67+50 - 68+05 Lt. Rd.
 *SLOPE EDGING
 63+00 - 67+63

* JUTE MATTING, ITEM 625
 63+00 - 63+75 Lt.
 63+00 - 64+75 Lt.

DEMOLITION / DISPOSAL of BLDGS, IT 506
 66+55 Lt. ✓
 67+00 Lt. ✓
 67+20 Lt. ✓
 67+50 Lt. ✓
 67+70 Lt. ✓
 67+75 Lt. ✓
 68+50 Lt. ✓
 67+15 Lt. ✓
 67+50 Lt. ✓


* Bituminous Concrete Surface for Buffers
 and Traffic Islands, Item 334 Mod.
 65+00 - 67+50 Island

CHAIN LINK FENCE
 63+00 - 67+30 Lt. (450 LF x 6' High)
 63+00 - 67+30 Lt. (450 LF x 6' High)

* Standard Steel Beam Guard Rail, Item 545-A (6'3" c/c)
 39+05 - 40+15 Lt. Rd.
 * Install Overhead Traffic Sign Support, Item 703
 40+00 US 7

CONTROL OF ACCESS IS COMPLETE
 ON THIS SHEET, EXCEPT AT STA. 68+05.00

* 5" One Course Cement Concrete
 Sidewalk, Item 550
 67+50 Appr Lt - 30+42 US 7 Rt.
 67+50 Appr Rt - 40+00 US 7 Rt.

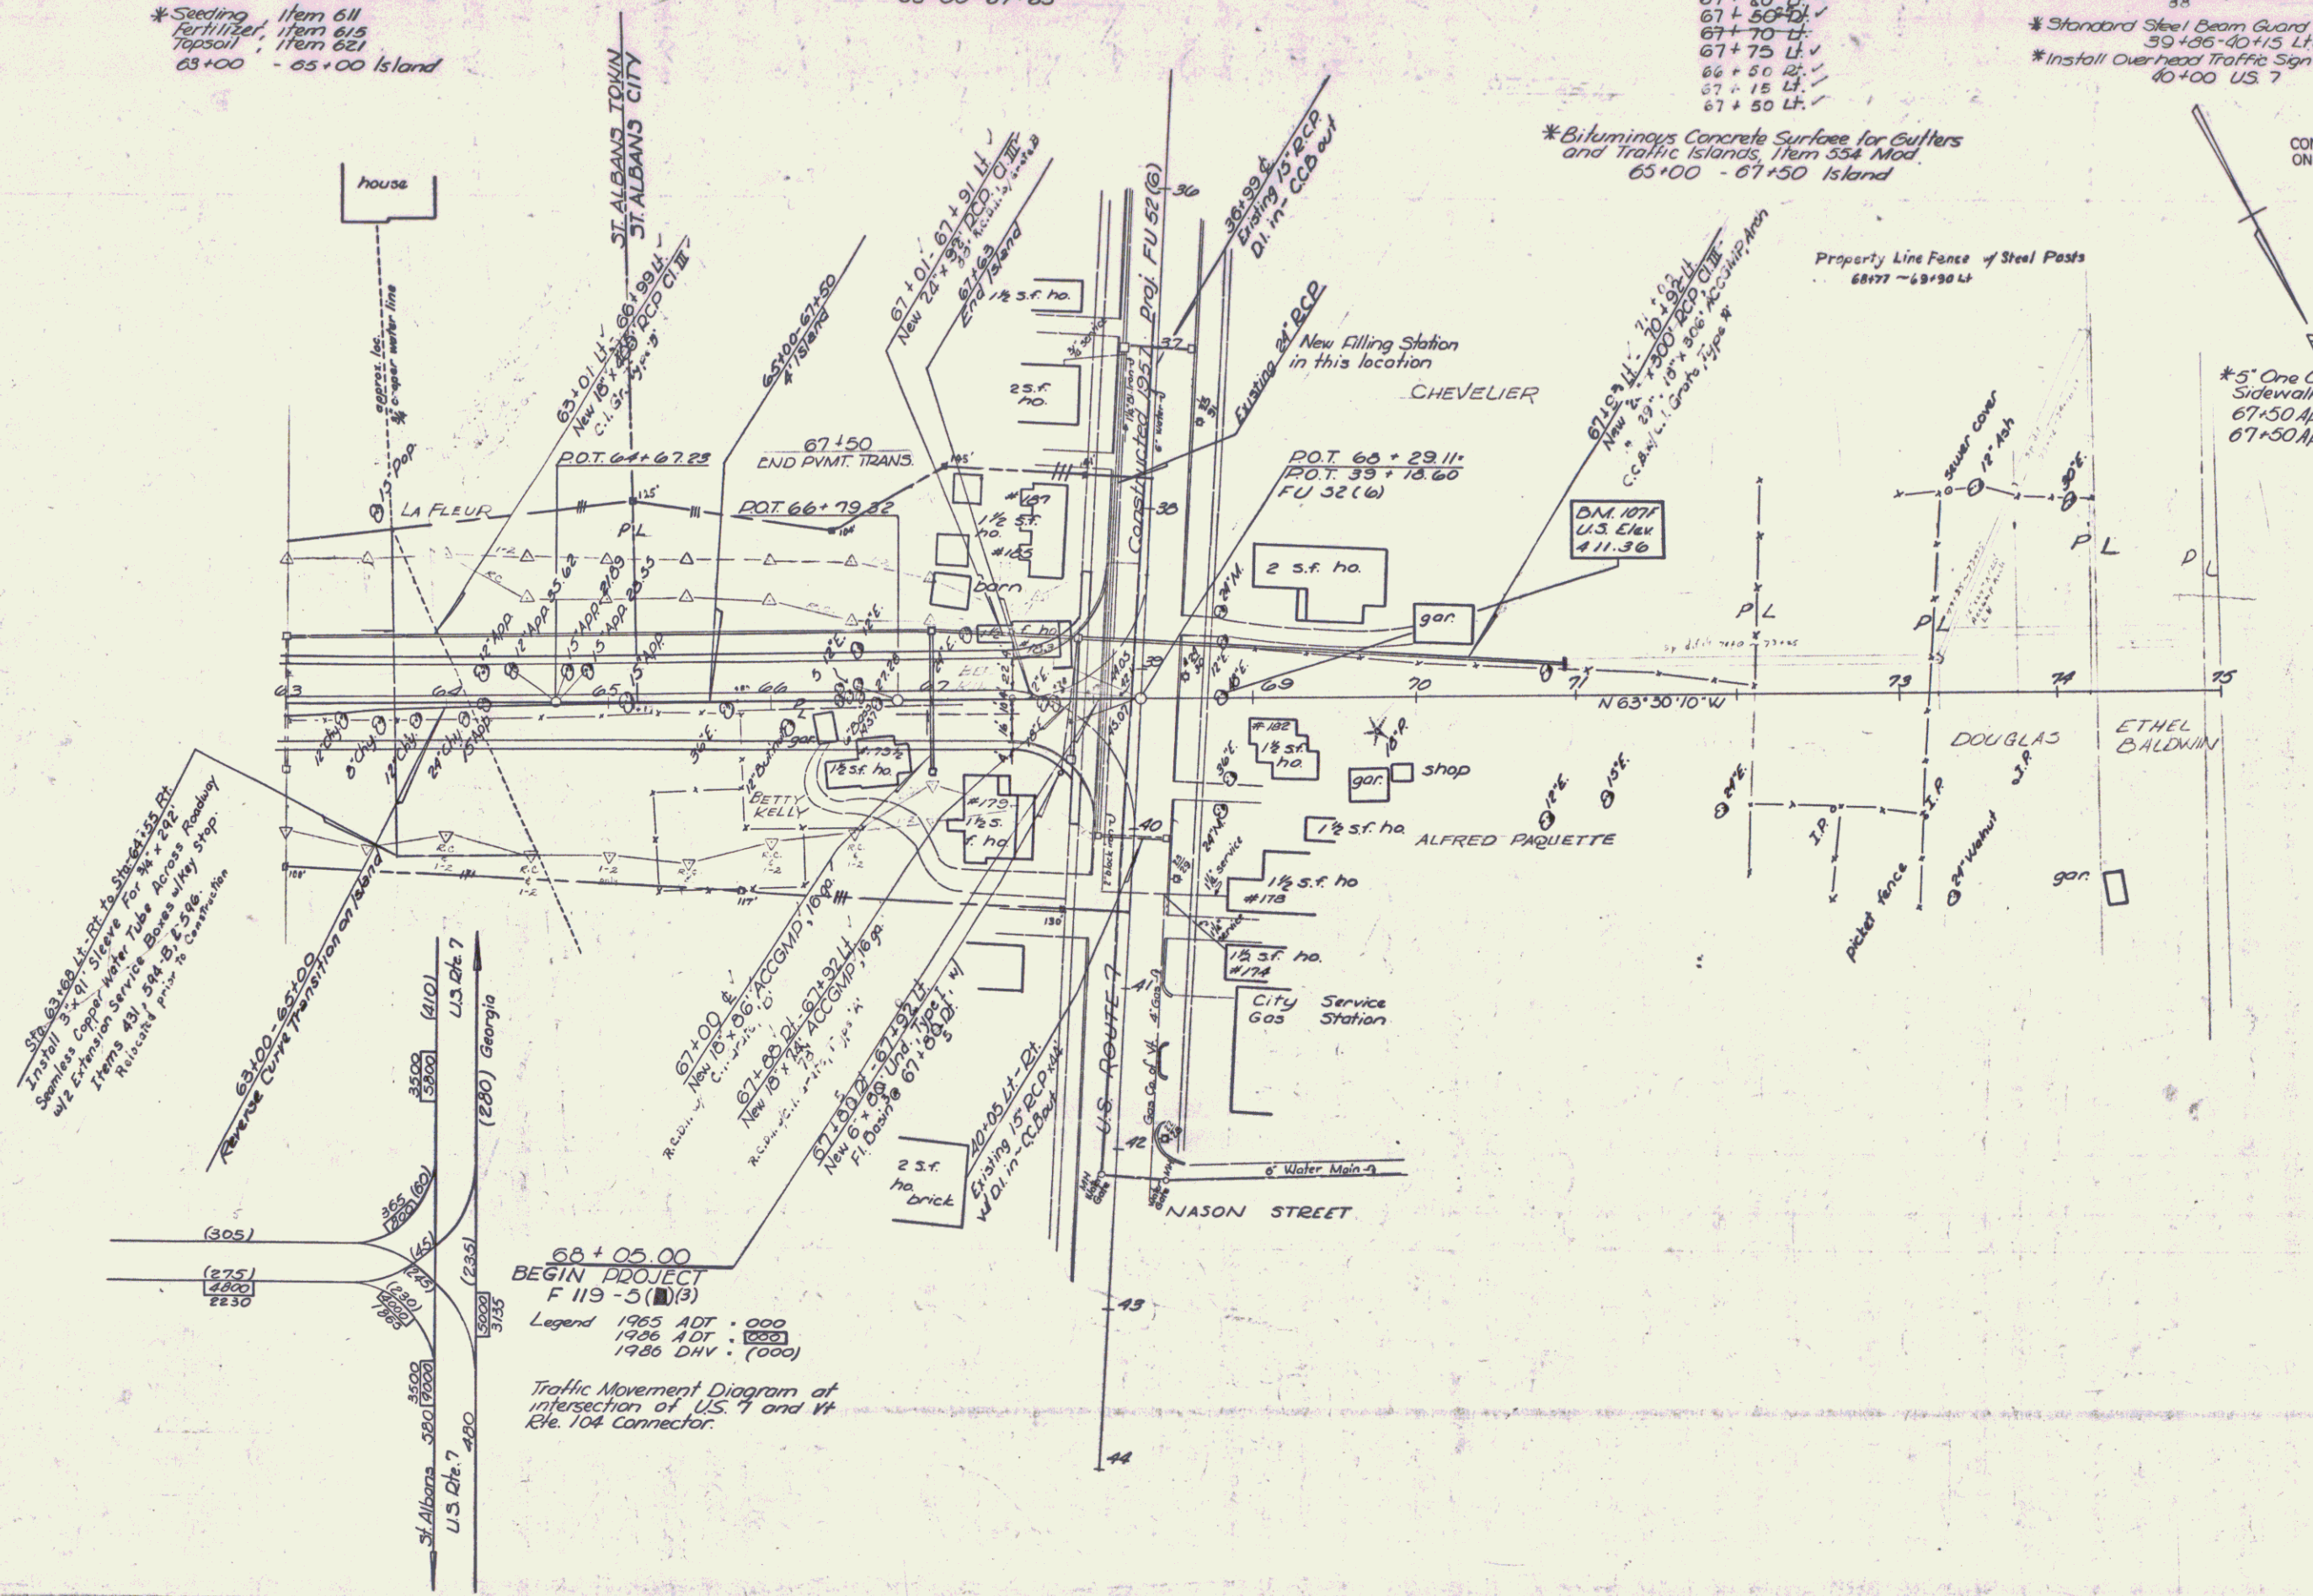


Site 63+00 Lt. Rd. to Streeting Pt.
 Install 9" x 41" Slaves for 12" x 12" x 12"
 Swales as Cooper Water Tube Across Roadway
 w/ Expansion Service Above Utility Stop.
 Items 611, 615, 621, 625, 626, 627, 999, 1000

68+05.00
 BEGIN PROJECT
 F 119-5(1)(3)

Legend
 1965 ADT - (000)
 1966 ADT - (000)
 1986 DHV - (000)

Traffic Movement Diagram at
 intersection of US 7 and Wt
 Ele. 104 Connector.

NOTE:
 * - Indicates items to be
 included in Stage II const.

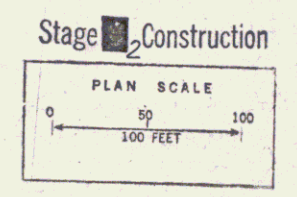

ST. ALBANS
 F 119-5(1)(3)
 Sheet 28 of 31