


PROPERTY LINE FENCE  
ALONG LIMITED ACCESS  
RIGHT OF WAY LINES



VERMONT DEPARTMENT OF HIGHWAYS  
RIGHT-OF-WAY PLANS  
PROJECT: ST ALBANS  
NO. F 118-5(1)  
SHEET 7 OF 13  
Revised 8/64

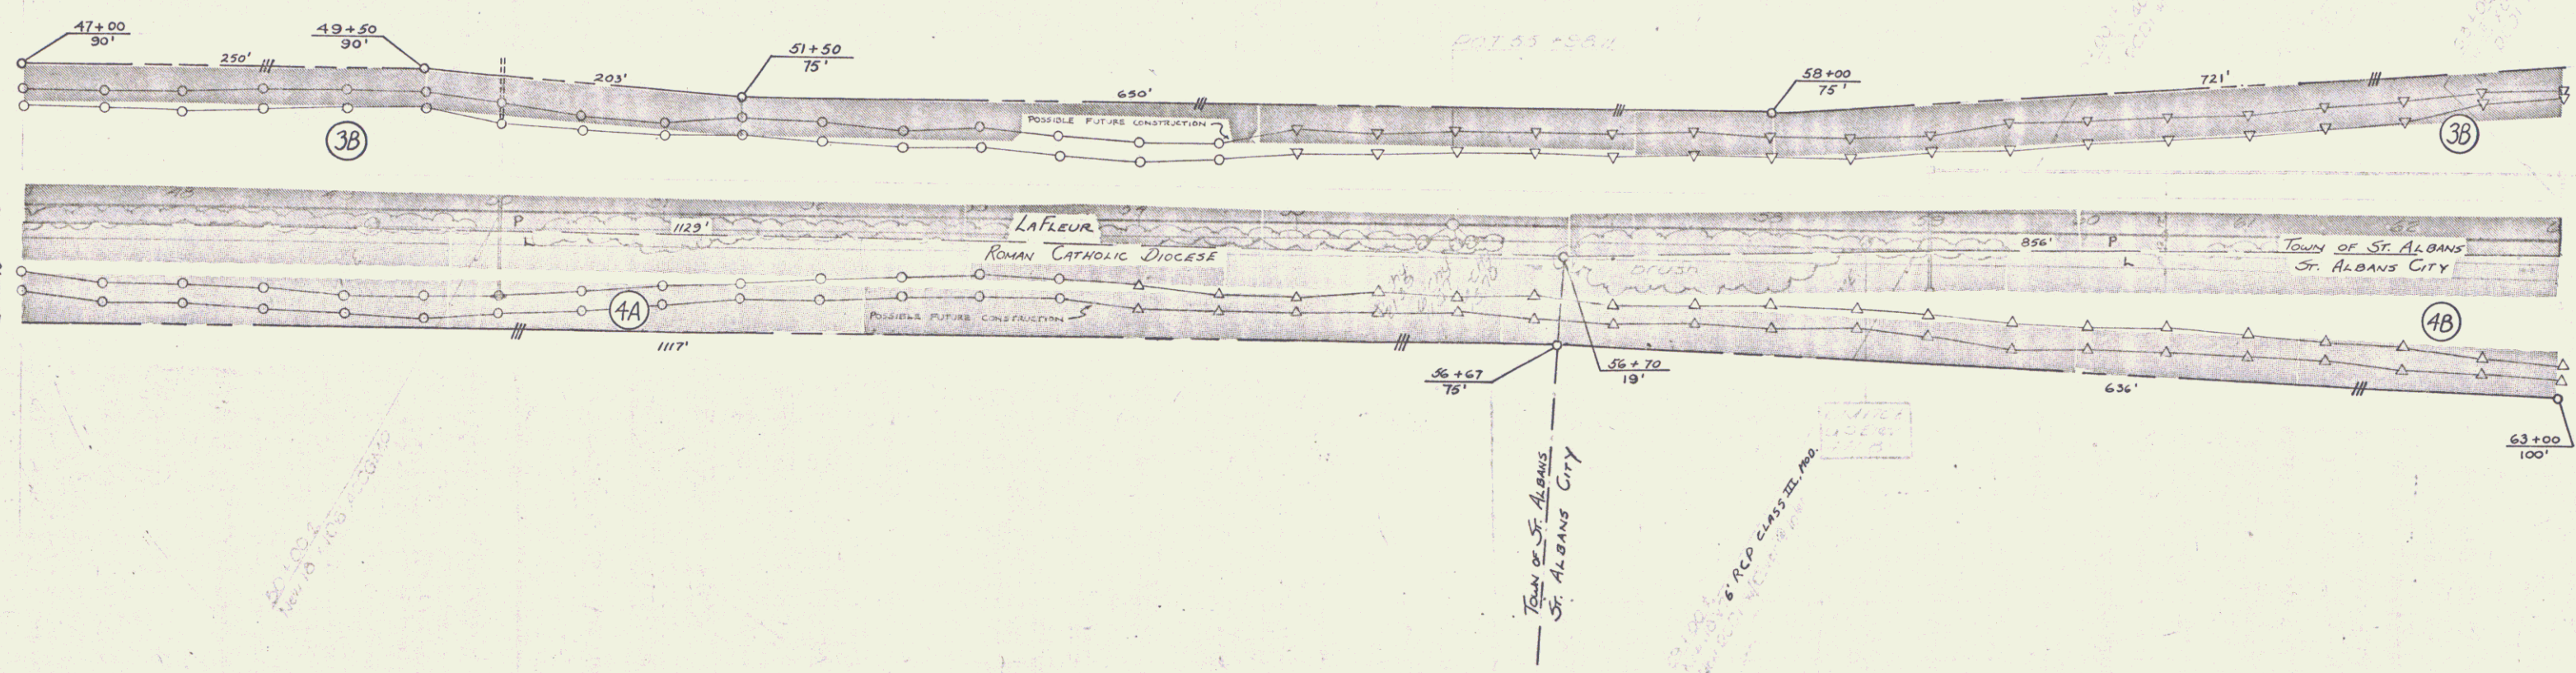