


BRIDGE WIDENING PROJECT
 VT Rt. 100 OVER WEST BRANCH TWEED RIVER
 Beginning 1.10 miles from Pittsfield- Stockbridge
 town line and extending southerly 0.057 miles.

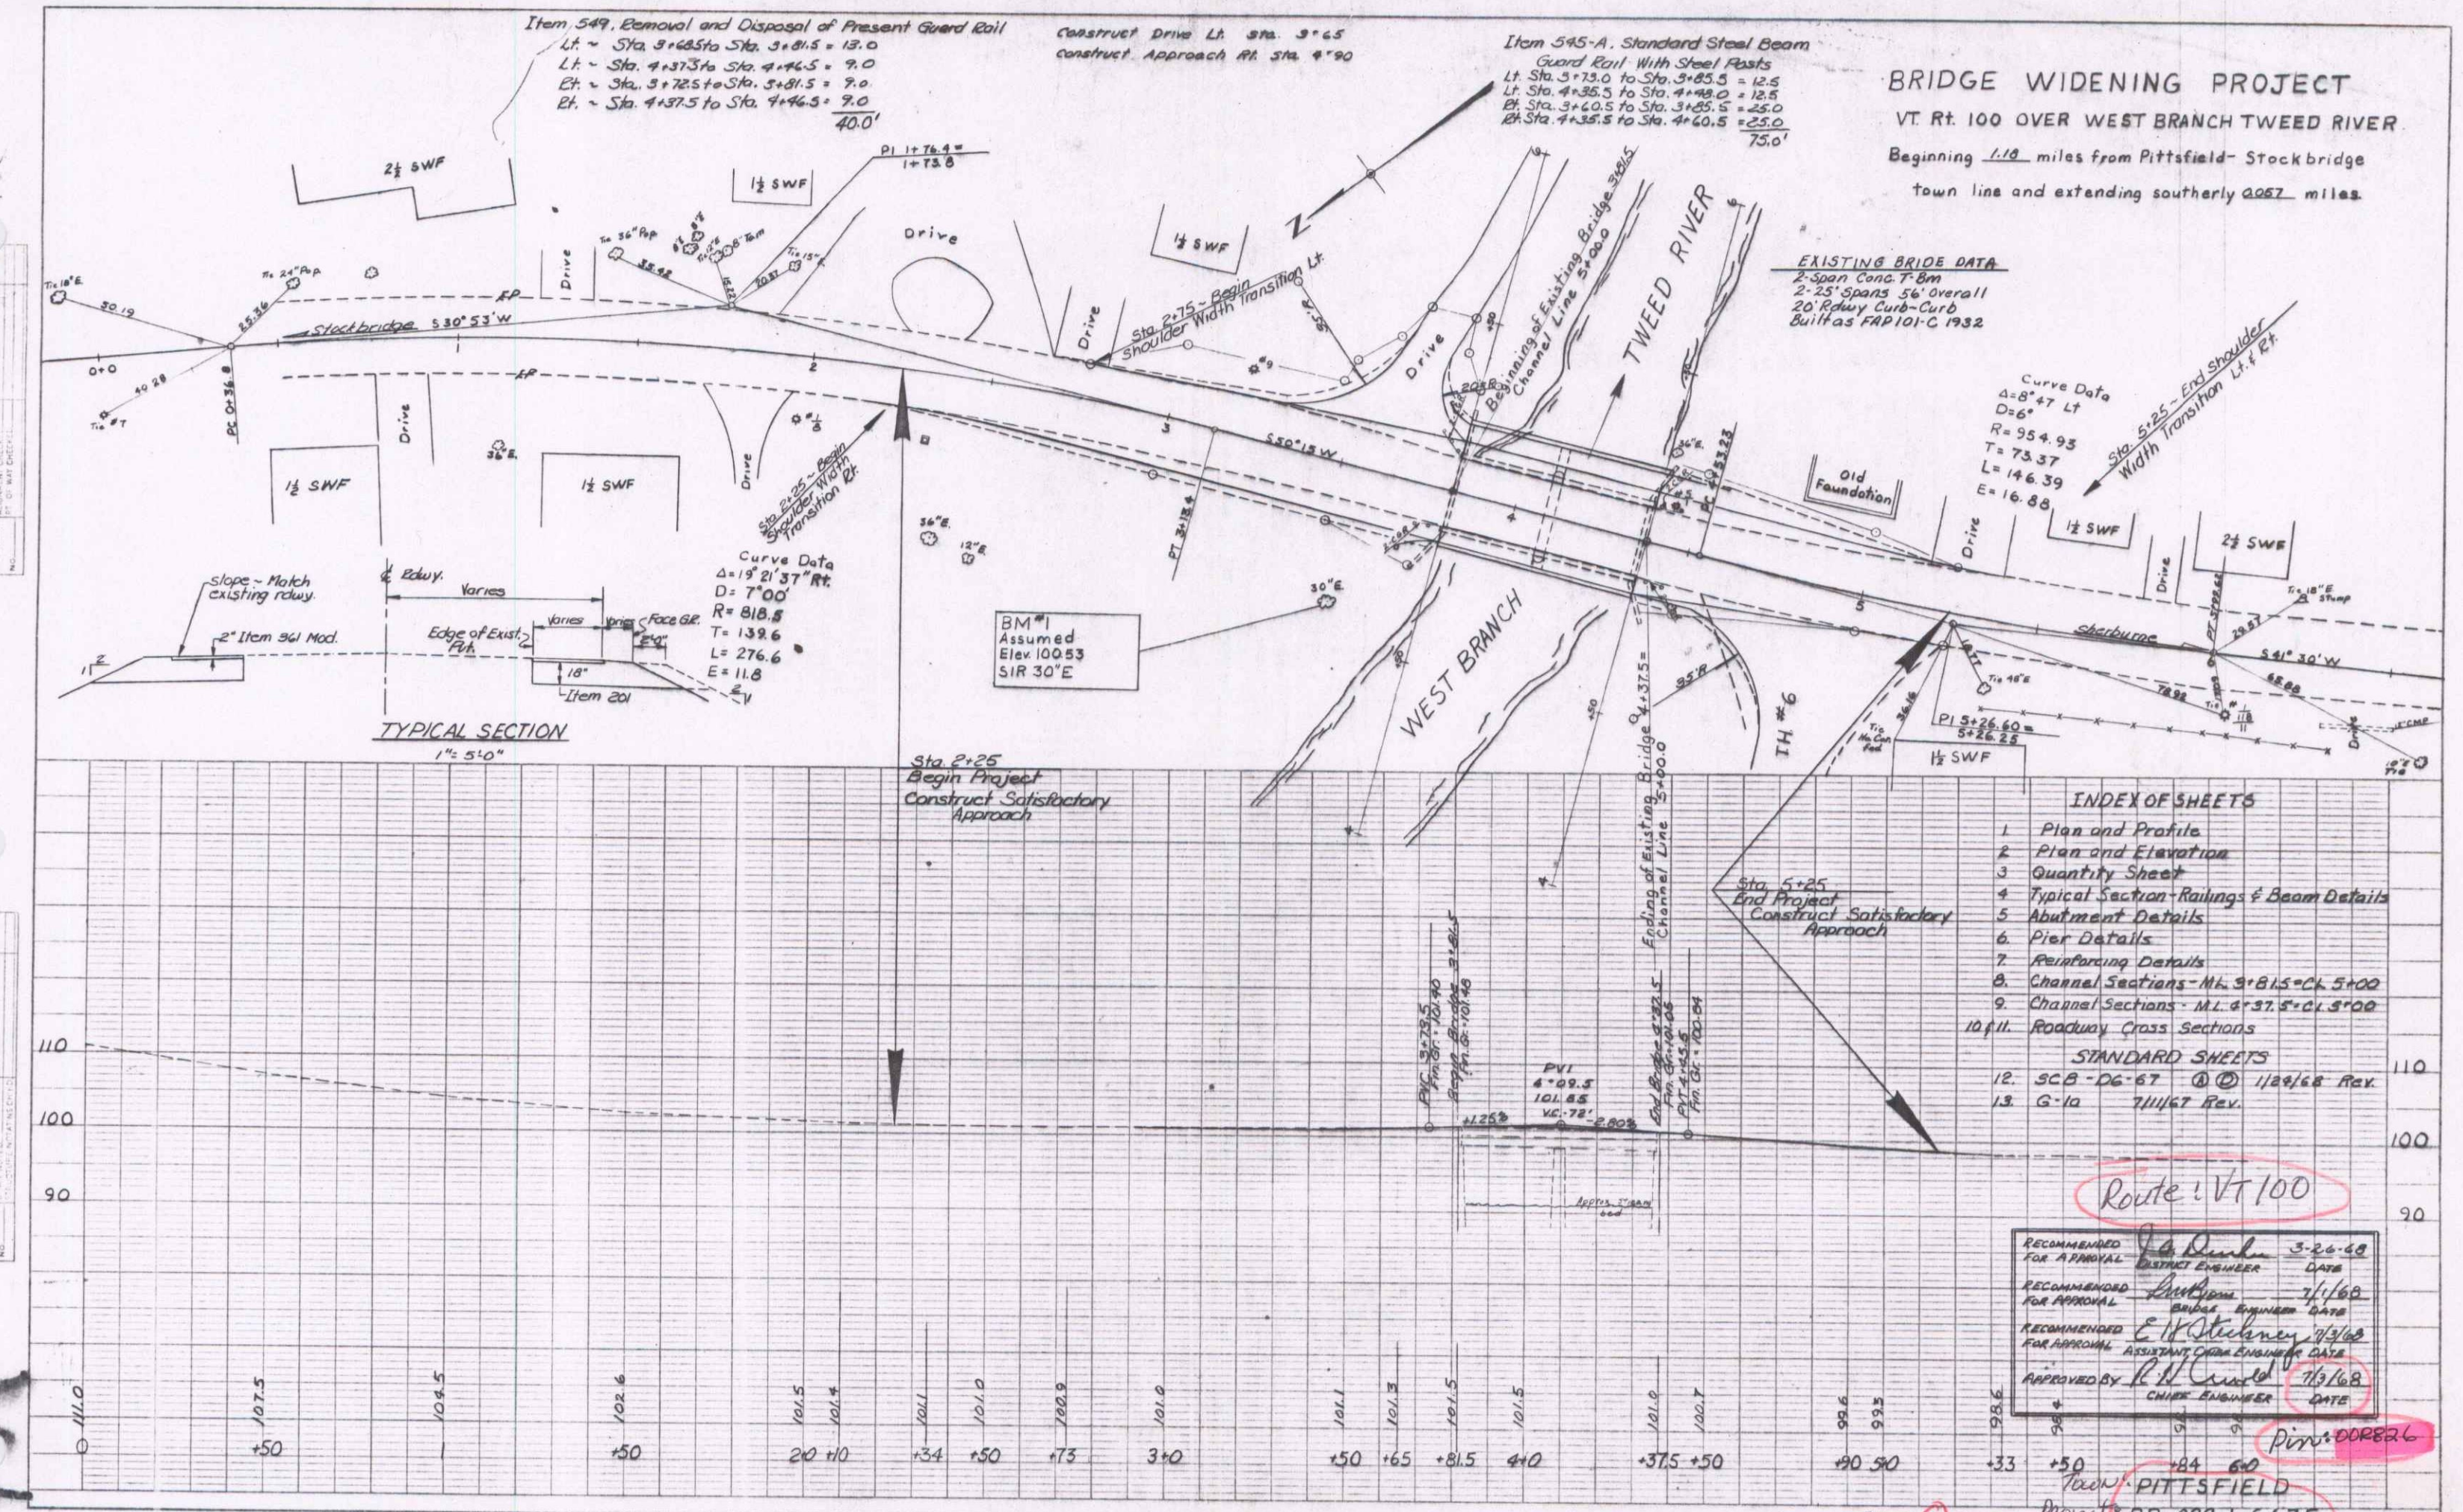

INDEX OF SHEETS

1. Plan and Profile
2. Plan and Elevation
3. Quantity Sheet
4. Typical Section - Railings & Beam Details
5. Abutment Details
6. Pier Details
7. Reinforcing Details
8. Channel Sections - M.L. 9+81.5 = Ch. 5+00
9. Channel Sections - M.L. 9+37.5 = Ch. 1.5+00
- 10/11. Roadway Cross Sections

STANDARD SHEETS

12. SCB-D6-67 ① ② 1/29/68 Rev.
13. G-1a 7/11/67 Rev.

RECOMMENDED FOR APPROVAL
 DISTRICT ENGINEER DATE
 RECOMMENDED FOR APPROVAL
 ENGINEER DATE
 RECOMMENDED FOR APPROVAL
 ASSISTANT CHIEF ENGINEER DATE
 APPROVED BY
 CHIEF ENGINEER DATE

Route: Vt 100
 Pittsfield
 Project: BB-022-1-6.6.35

PLAN
 SCALE: 1" = 40'
 DATE: 11/20/68

PROFILE
 SCALE: 1" = 10'
 DATE: 11/20/68