


WOOD GUIDE POST
 10 24-47-25.9 24-34-05.00 10

NOTE: STA 76+00-87+00 IS DUPLICATED

PLAN	DATE	BY	CHKD
1955	1955	W. J.
1956	1956
1957	1957
1958	1958
1959	1959
1960	1960
1961	1961
1962	1962
1963	1963
1964	1964
1965	1965

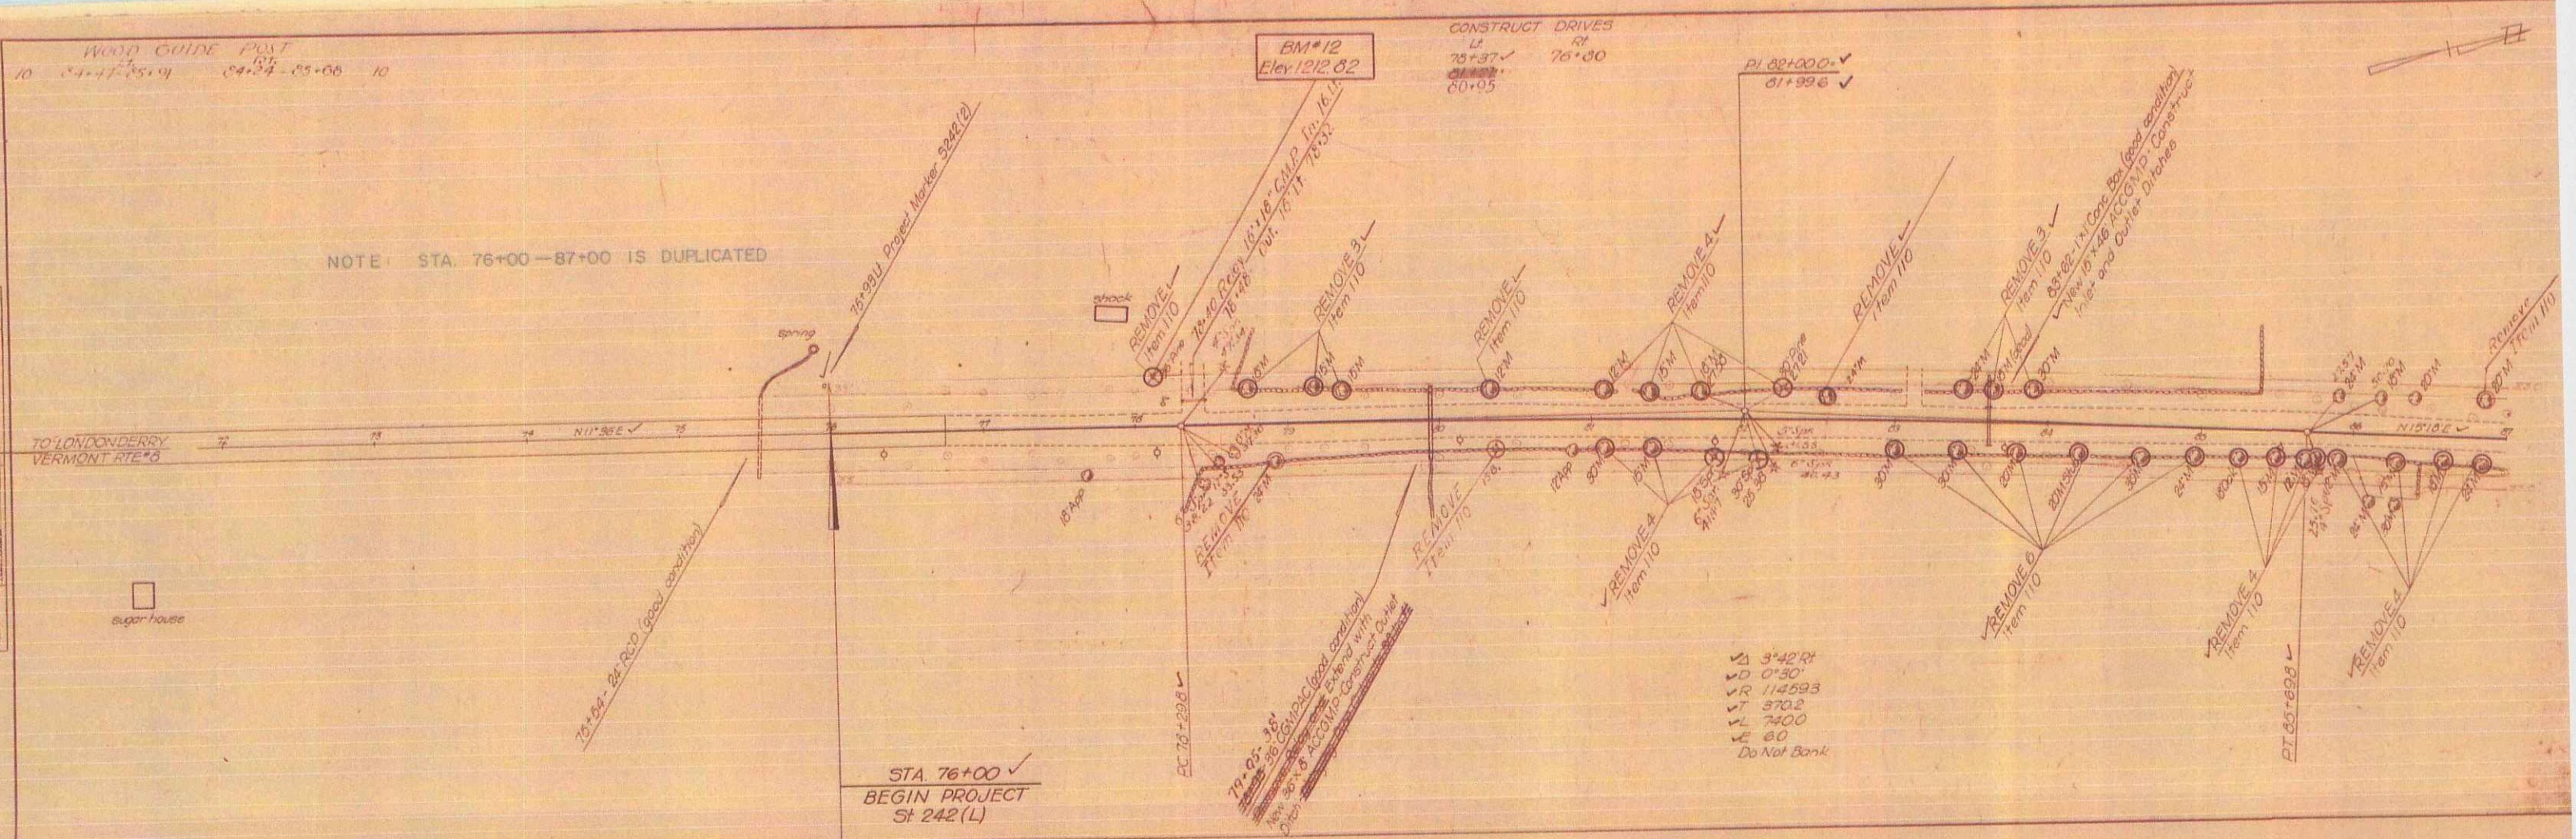


WOOD GUIDE POSTS

1	90-38-00	91+50	87+00	89+48	16
2	97-35-00	90+03	95-02	98+48	17
3			99-30	-103+00	18

CONSTRUCT DRIVES

12	88+80	95-15
13	89+85	99+00
14		95+40

PLAN	DATE	BY	CHKD
1955	1955	W. J.
1956	1956
1957	1957
1958	1958
1959	1959
1960	1960
1961	1961
1962	1962
1963	1963
1964	1964
1965	1965

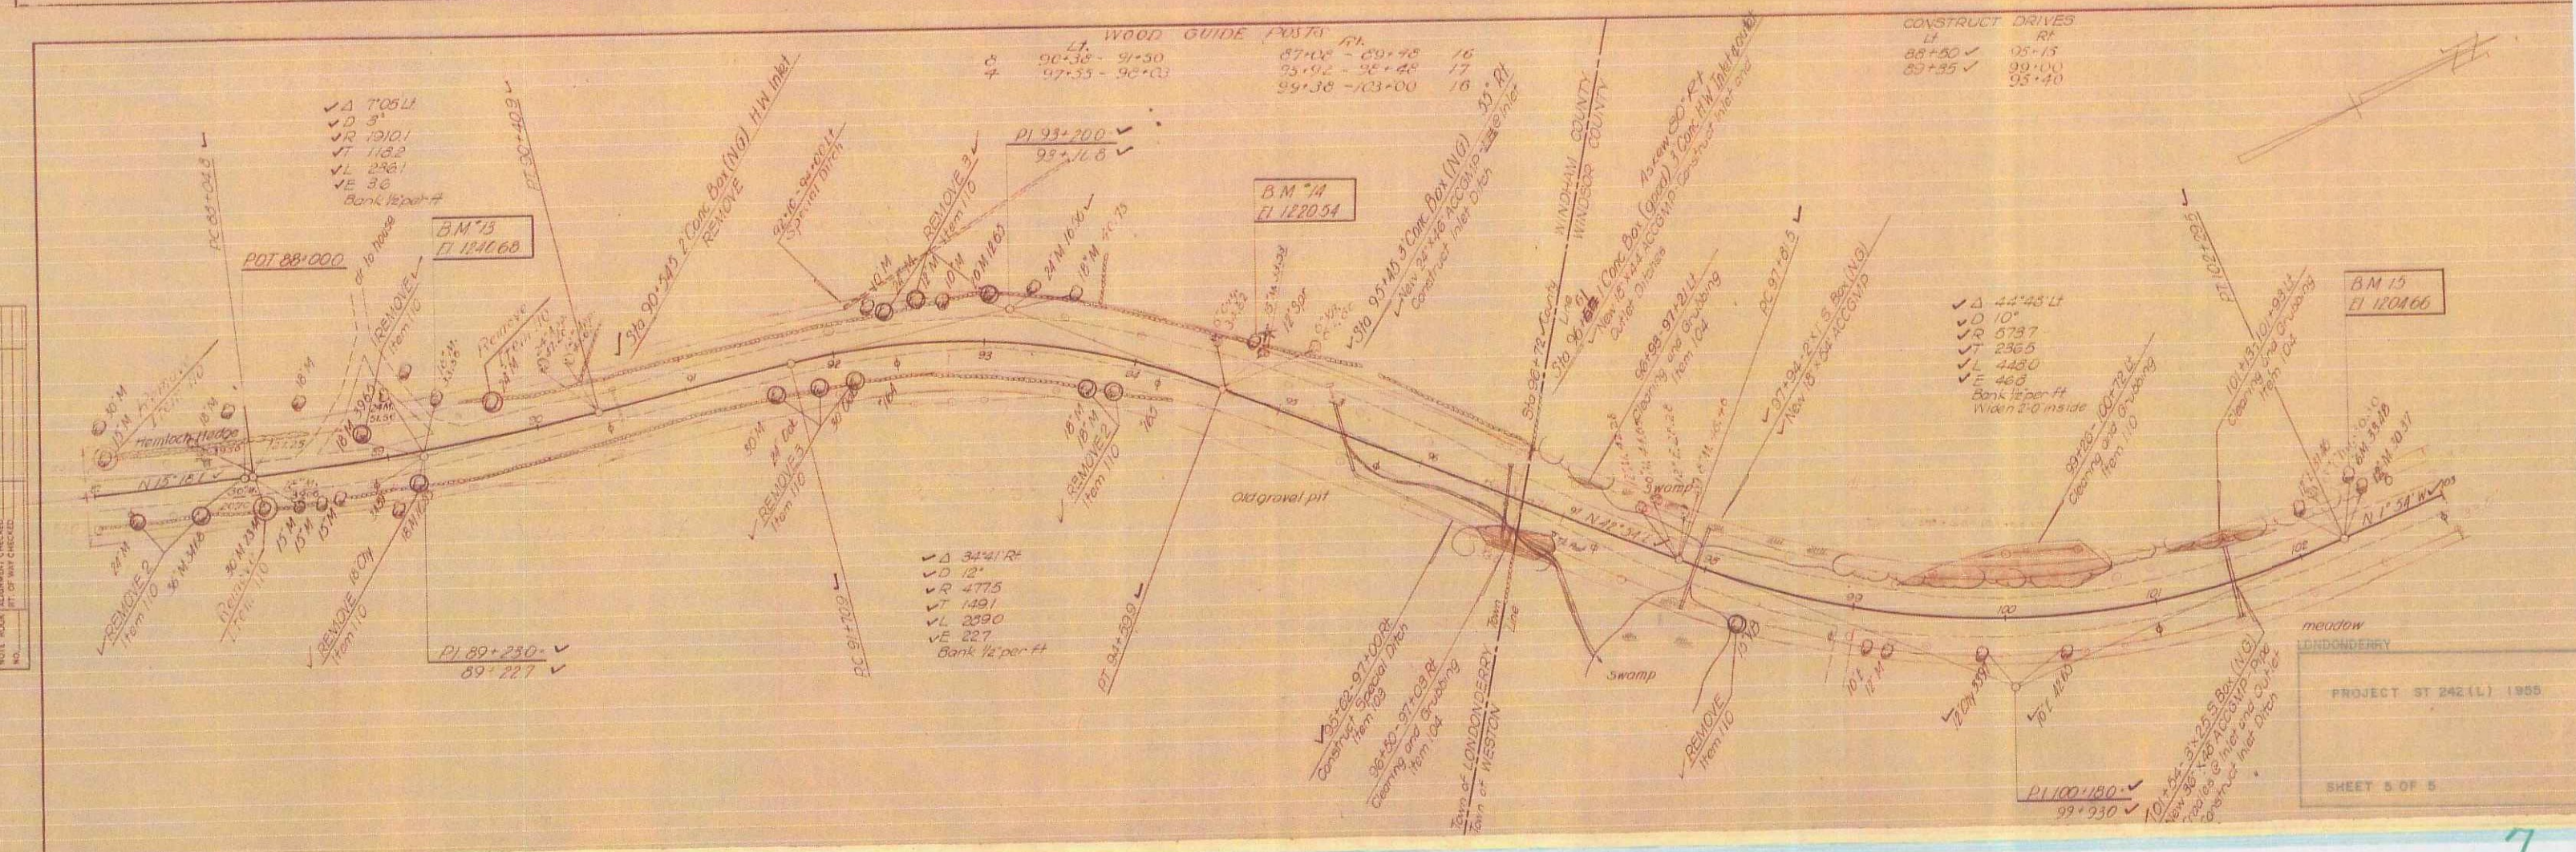

WOOD GUIDE POSTS

1	94-41-00	97+00	91+00	92+75	16
2	97-35-00	90+03	95-02	98+48	17
3			99-30	-103+00	18

CONSTRUCT DRIVES

12	88+80	95-15
13	89+85	99+00
14		95+40

PROJECT ST 242 (L) 1965
 SHEET 5 OF 5