
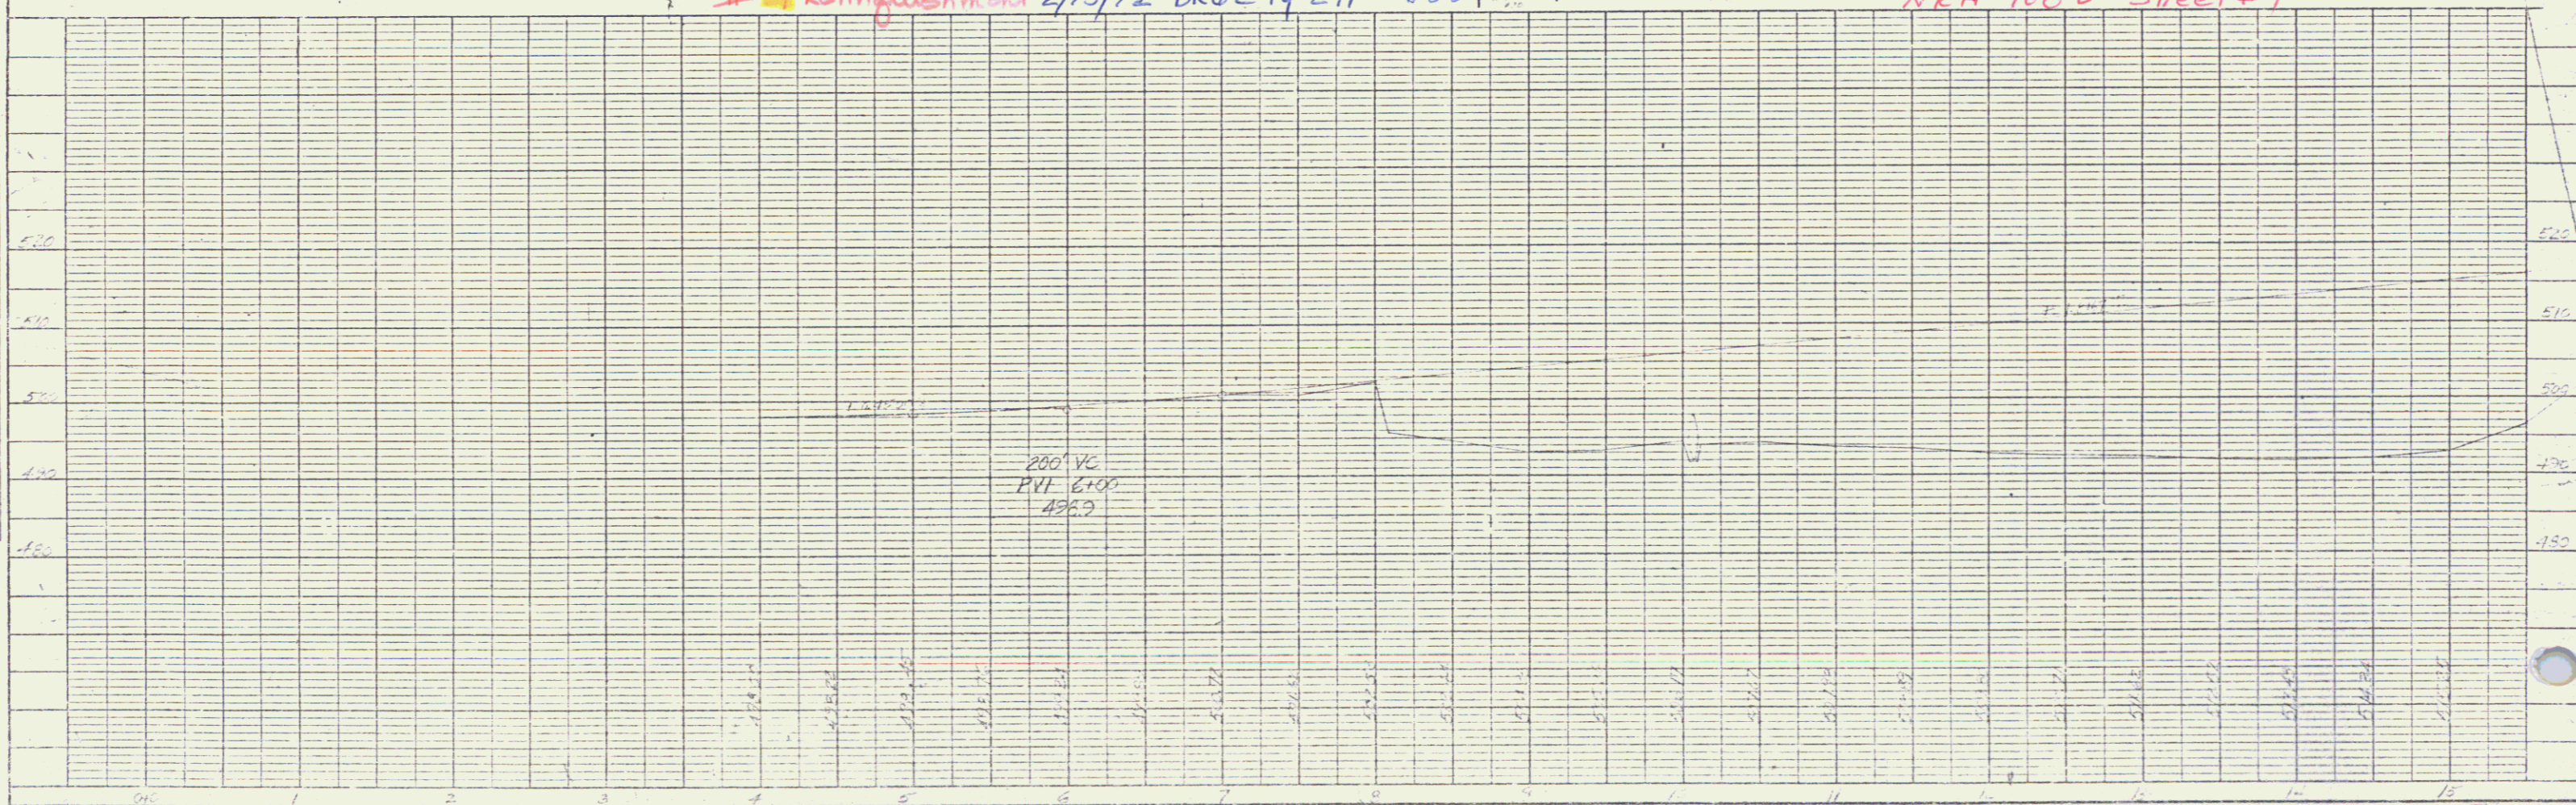


8 1245

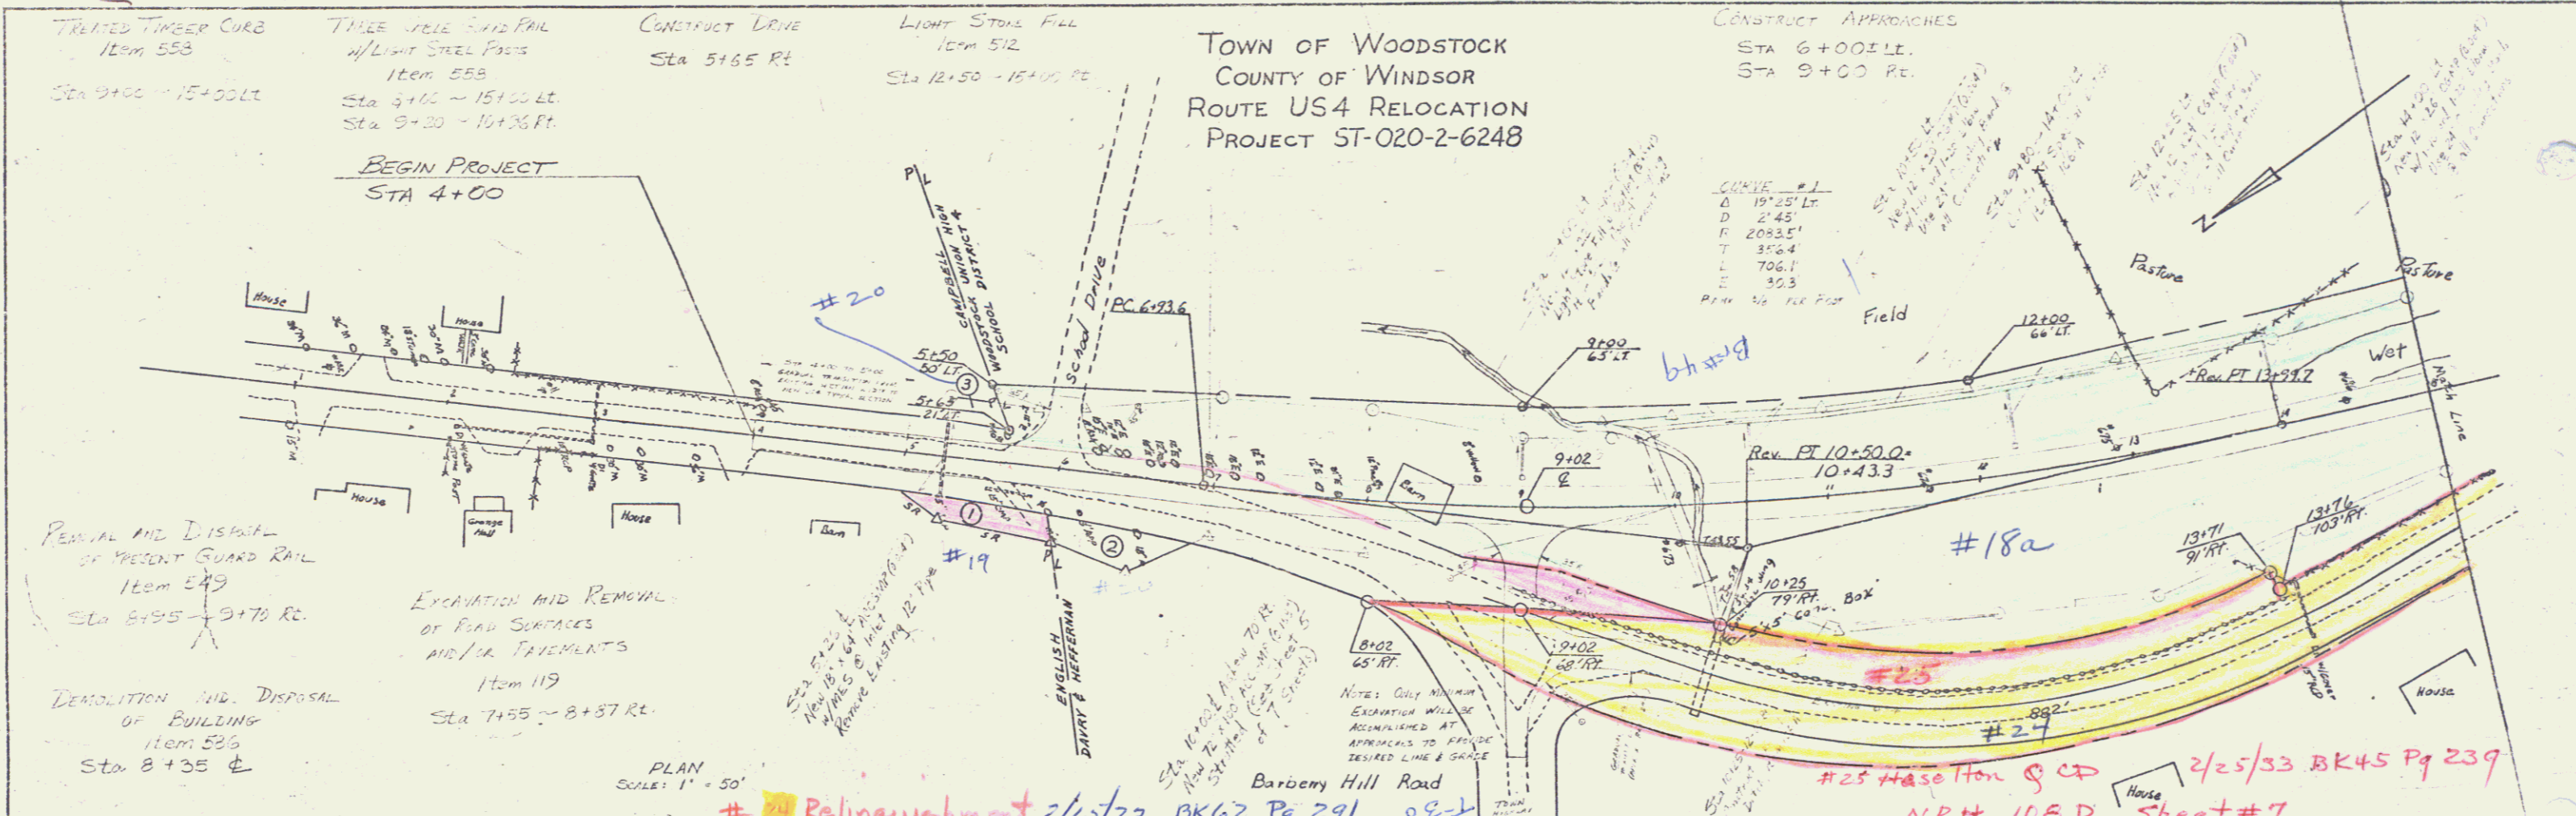

SCALE 1" = 50'

Sheet 18 of 7

3