

TREATISE TIMBER CURVE
Item 553
Sta 15+00 ~ 16+50 LT

THREE CABLE GUARD RAIL
W/Lt. Steel Posts
Item 533
Sta 15+00 ~ 16+56 LT

CONSTRUCT DRIVES
Sta 17+05 LT
Sta 18+50 LT


Light Stone Fill
Item 512
Sta 15+00 ~ 15+75 RL

CONSTRUCT APPROACH
Sta 17+20 RL

CURVE # 2
Δ 6° 25' R
D 3+00'
P 190.23'
T 102.11'
L 213.9'
E 3.0'
Sta. 94' PER FOOT

END PROJECT
STA 20+00

PLAN	DATE
DATE	BY
DATE	BY
DATE	BY
DATE	BY

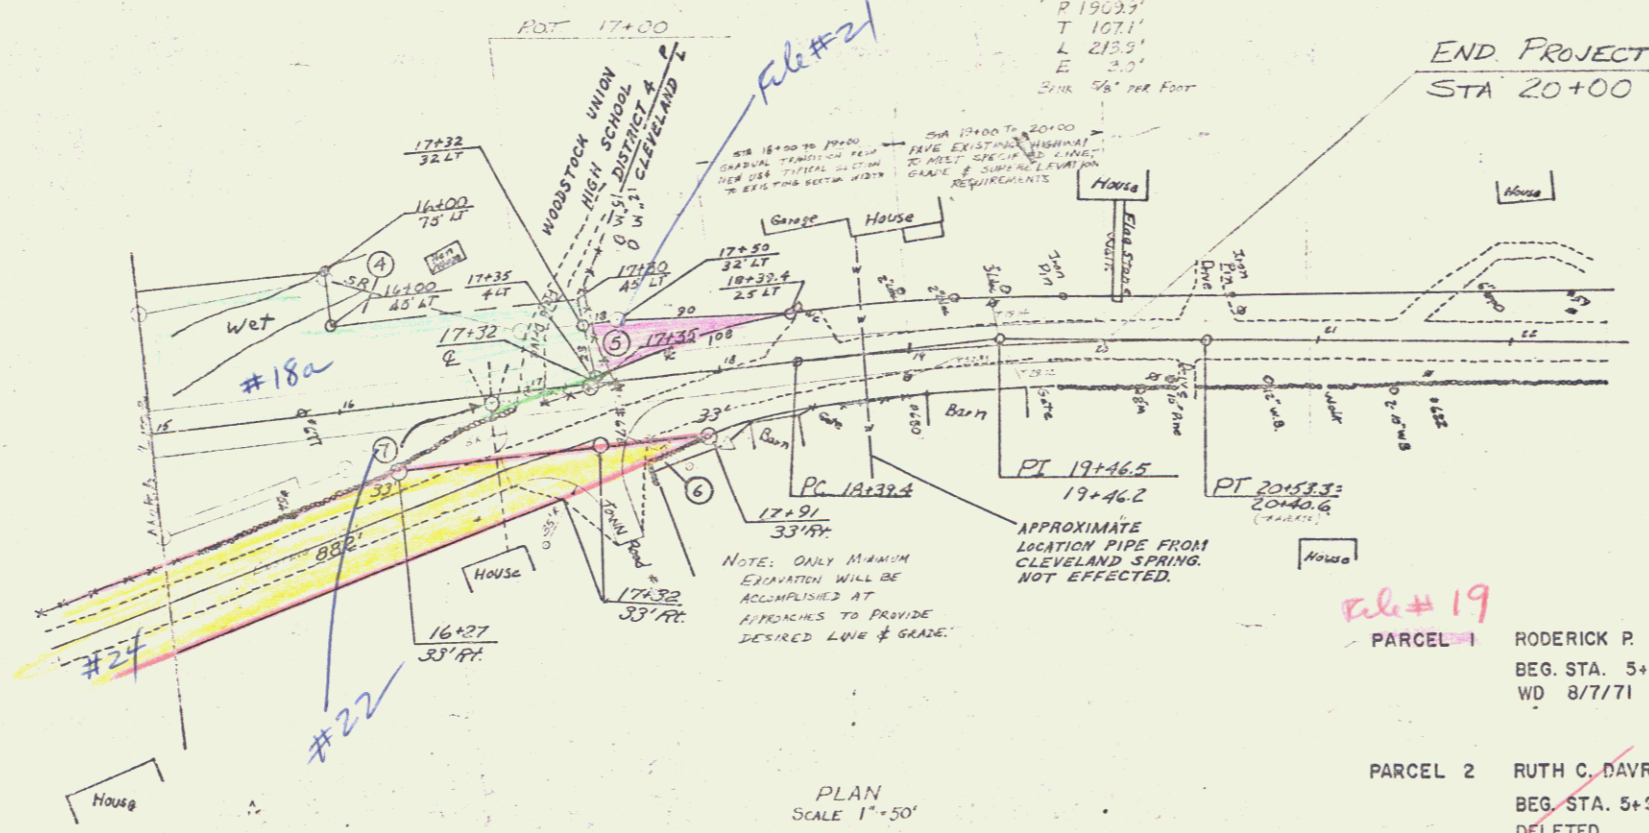

PLAN
SCALE 1"=50'


- #20
PARCEL 3 FREEMAN E. & RUTH G. CAMPBELL.
BEG. STA. 5+20 LT. END STA. 5+65 LT.
CULVERT & DRAINAGE (P)
WD 2/10/71 BK.60 PG.407
- #18a
PARCEL 4 WOODSTOCK UNION HIGH SCHOOL DISTRICT NO. 4
BEG. STA. 16+00 LT. END STA. 16+65 LT. SLOPE (T) 800 S.F.±
WD 12/2/71 BK.62 PG. 217
- #21
PARCEL 5 GUY H. & EVELYN H. CLEVELAND
BEG. STA. 17+32 LT. END STA. 18+39.4 LT.
TAKE 1500 S.F.± REM. 1.3 ACRES±
WD 3/3/71 BK.60 PG. 415
- PARCEL 6 HOWARD G. NICHOLS
BEG. STA. 17+60 RT. END STA. 18+15 RT. SLOPE 400 S.F.± (*)
~~DELETED PLANS CHANGED IN FIELD~~
- #22
PARCEL 7 WILLIAM BEEBE
16+78 RT. SEPTIC TANK & DRYWELL
REMOVAL BY AGREEMENT
AGREEMENT 8/24/71 BK.62 PG. 151

File # 19
PARCEL 1 RODERICK P. & EVALYN B. ENGLISH
BEG. STA. 5+00 RT. END STA. 6+00 RT. SLOPE (T) 1200 S.F.±
WD 8/7/71 BK.62 PG.125

PARCEL 2 RUTH C. DAVRY & CELESTE HEFFERNAN
BEG. STA. 5+95 RT. END STA. 6+90 RT. SLOPE (T) 1500 S.F.±
~~DELETED PLANS CHANGED IN FIELD~~

File # 18a Union High School Dist 4
Comp. Deed 8/20/50 BK 54 Pg 26

PROFILE	DATE
DATE	BY
DATE	BY
DATE	BY
DATE	BY

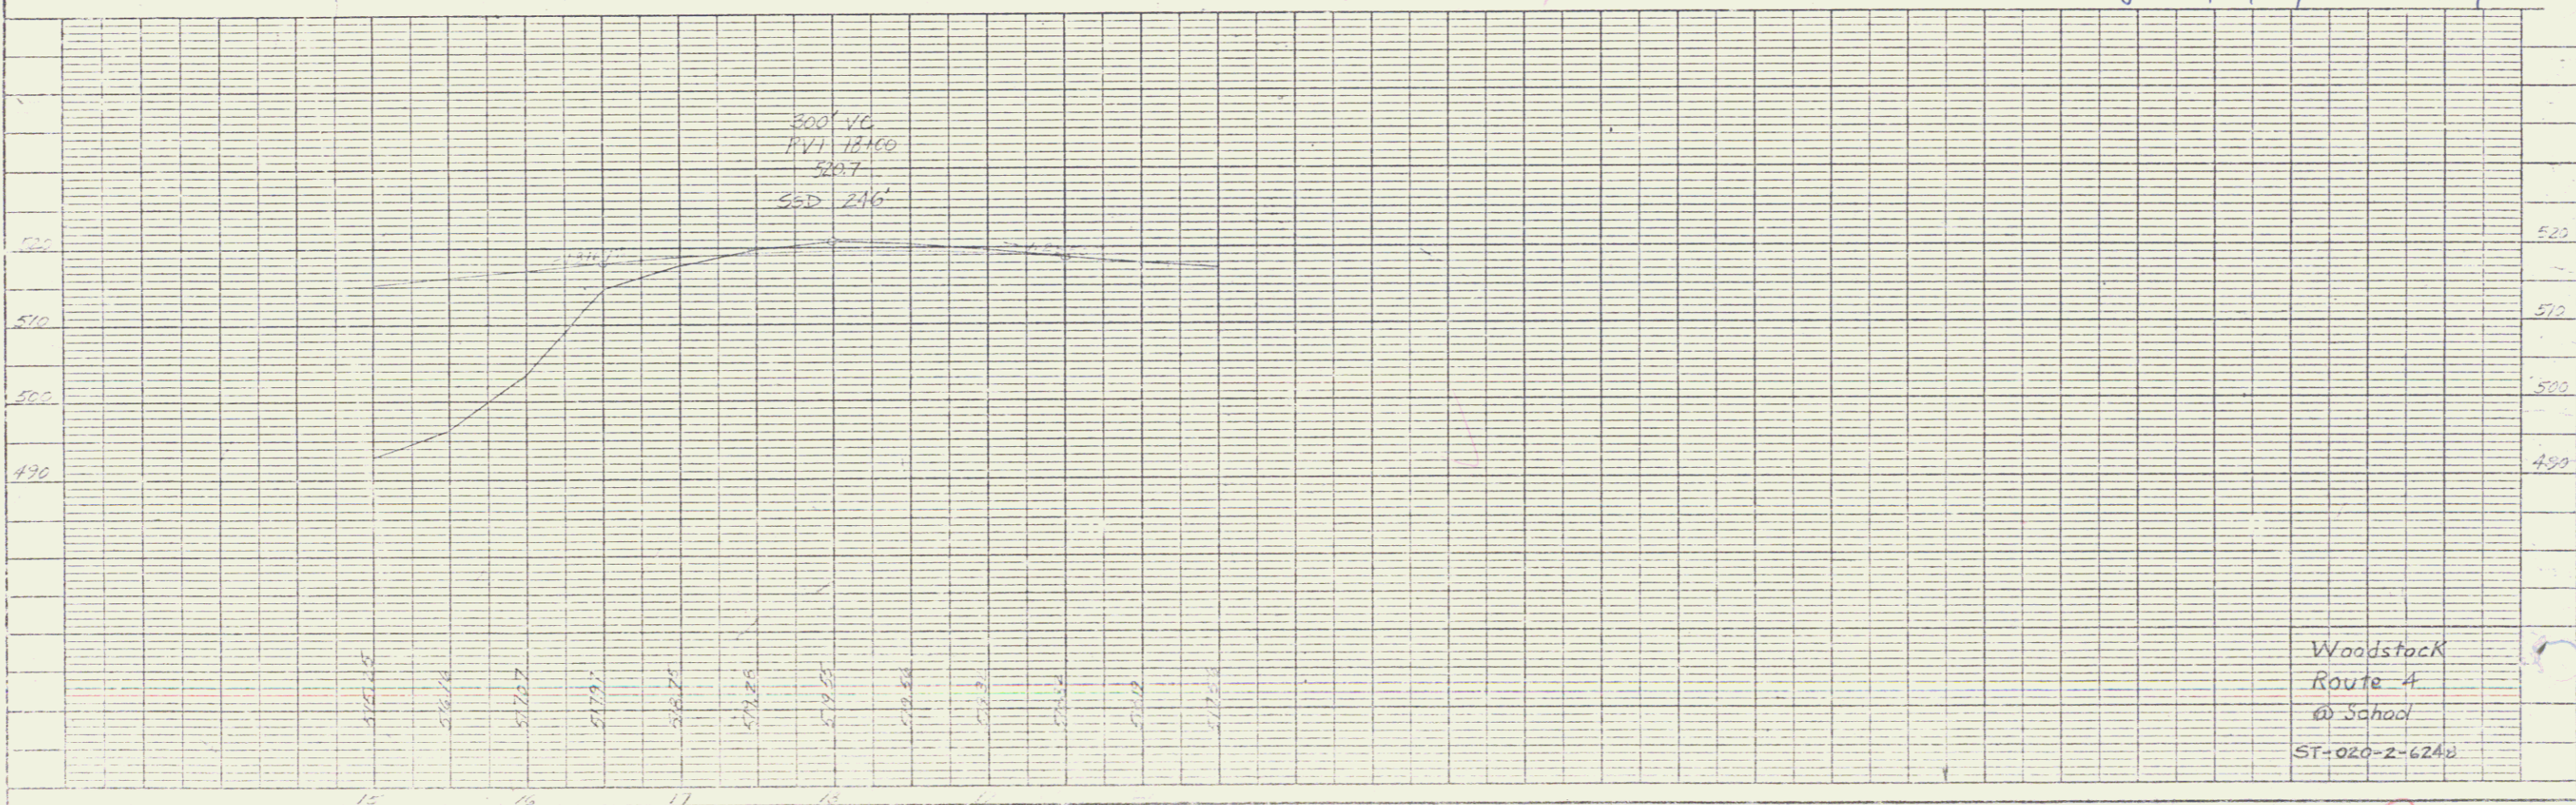

K&E PLATE 1, PLAN/PROFILE
K&E ENGINEERS & ARCHITECTS

Woodstock
Route 4
@ School
ST-020-2-624a

Sheet 2A of 7