


Sta 1031+00
 End of Project
 F.A.P. 15A
 Contract #2



Sta 1026+00 to 1030+25
 Shaping Course of Gravel

Sta 1030+25 to 1032+00
 12" Sub Base

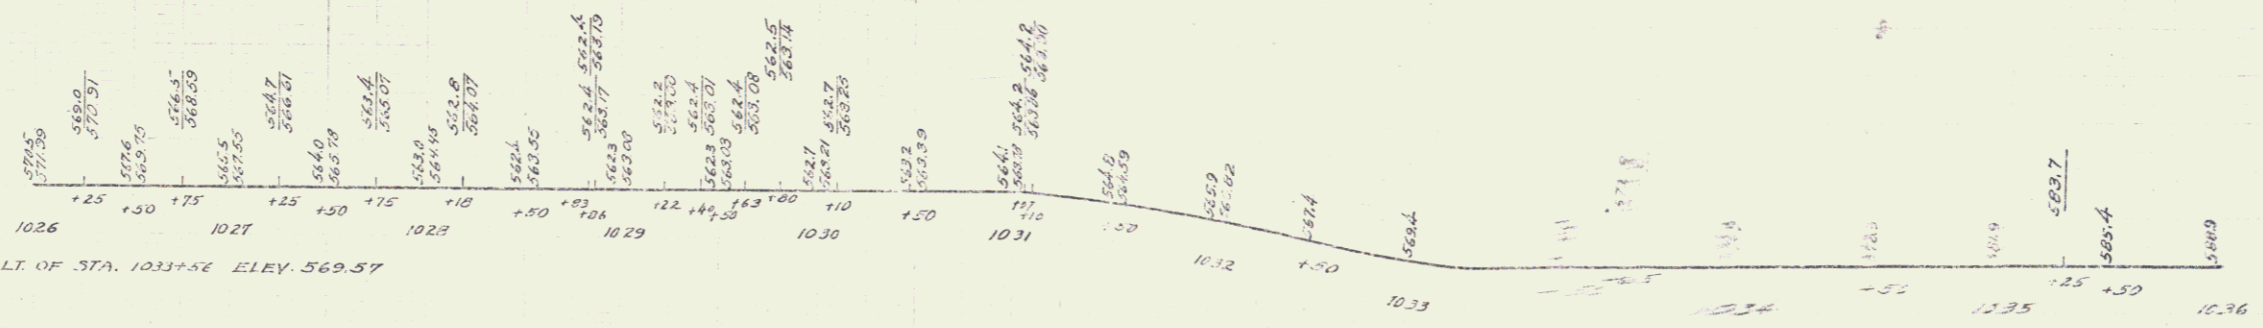

1/4" #52 SPIKE IN ROOT OF 24" MAPLE 25.5 FT. LT. OF STA. 1031+54 ELEV. 569.57

5
 Streets
 Sheet
 3