

INDEX OF SHEETS

SHEET NO.	TITLE PAGE
1	TITLE PAGE
2-5	TYPICAL CROSS-SECTION OF IMPROVEMENT ONE COURSE CEMENT CONCRETE PAVEMENT
4	BANKING AND WIDENING TABLES
5-15	PLAN AND PROFILE STA 935+94.7 TO 144+00
16	STANDARD STRUCTURE SHEET S-28
17	S-30
18	S-30A
19	S-33
20	SC-2-4
21	SCW-4
22	SCW-4-5
23	S-40
24	S-41
25-75	CROSS SECTIONS

STANDARD STRUCTURE SHEETS
 APPROVED BY THE CHIEF ENGINEER
 S-28 JULY 11, 1933
 S-30 AUG. 15, 1934

STATE OF VERMONT
 STATE HIGHWAY DEPARTMENT


PLAN AND PROFILE OF PROPOSED
 STATE HIGHWAY

TOWN OF LEICESTER


BRANDON-MIDDLEBURY ROAD

BEGINNING AT A POINT 8.7 FEET NORTH OF
 THE BRANDON-LEICESTER TOWN LINE AND
 EXTENDING NORTHERLY 2.732 MILES ON
 ROUTE U.S. 7 INCLUDING F.A. PROJECT 109D(2)
 LENGTH OF PROJECT 14327.6 FEET = 2.713 MILES

FED. ROAD DIST. NO.	STATE	FED. AID PROJ. NO.	FISCAL YEAR	SHEET NO.	TOTAL SHEETS
9	Vt.	10910	1940	1	25

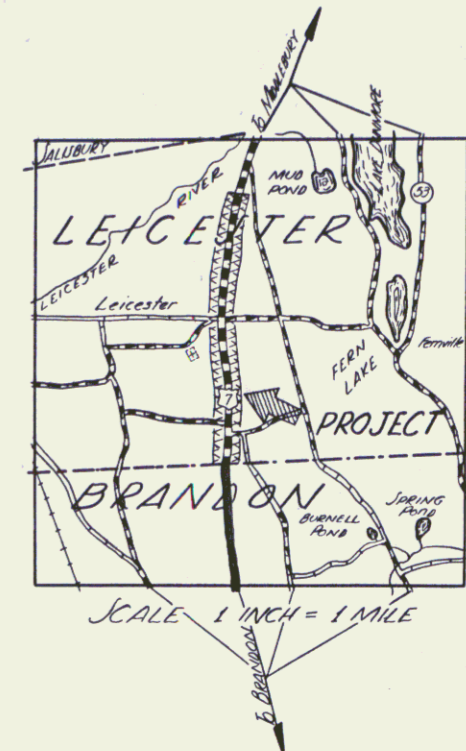

Pin # 008857

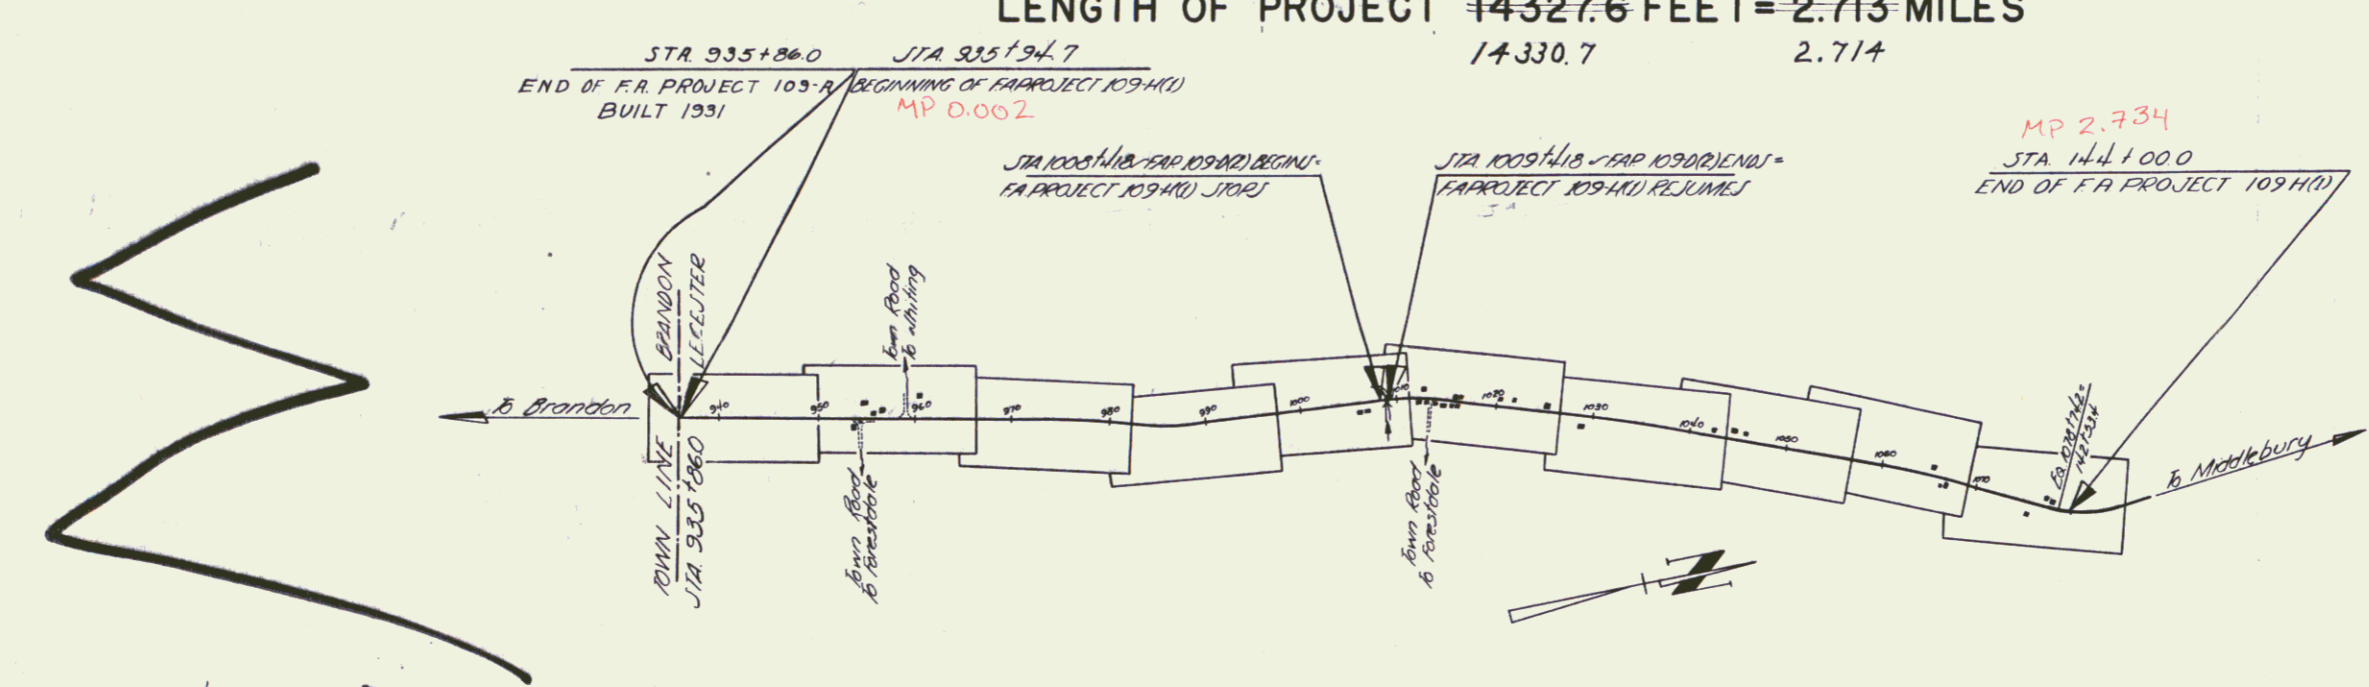

RECORD PLANS
 By: William H. Chase

APPROVED: June 13, 1940
 H. Sturgis
 COMMISSIONER OF HIGHWAYS
 SUBMITTED BY ORDER OF THE STATE HIGHWAY BOARD

COUNTY LINE	---
TOWN LINE	----
FENCE LINE
STONE WALL	-----
UNFENCED PROPERTY
GUARD RAIL
TRAVELED WAY
RAILROAD	-----
RETAINING WALL	-----
CENTER LINE	-----
SURVEY LINE	-----
CULVERT	-----
DROP INLET	-----
TROLLEY POLE	-----
POWER POLE	-----
TELEPHONE POLE	-----
TREES	-----
HEDGE	-----

GROUND ELEVATION	DATUM	LINE
GRADE ELEVATION	DATUM	LINE

CURVE DATA

DEFLECTION ANGLE	Δ
DEGREE OF CURVE	D
RADIUS OF CURVE	R
TANGENT DISTANCE	T
LENGTH OF CURVE	L
EXTERNAL DISTANCE	E
POINT OF INTERSECTION	P. I.
POINT OF CURVE	P. C.
POINT OF TANGENT	P. T.
POINT ON TANGENT	P. O. T.

SCALES

TITLE	1" = 1000 FT
TYPICAL	1" = 2 "
PLAN	1" = 50 "
PROFILE HORIZONTAL	1" = 50 "
PROFILE VERTICAL	1" = 10 "
CROSS SECTIONS	1" = 5 "

U.S. Rte #7

RIGHT-OF-WAY DIVISION
 TOWN FILE
 PERPETUAL
 Town of LEICESTER
 (To Be Returned To R.O.W. Division)

THESE PLANS ARE SUBJECT TO SUCH REVISIONS AS MAY BE
 REQUIRED BY THE PUBLIC ROADS ADMINISTRATION OR THE COM-
 MISSIONER OF HIGHWAYS.
 CONSTRUCTION IS TO BE CARRIED ON IN ACCORDANCE WITH
 THE PLANS AND THE STANDARD ROAD AND BRIDGE SPECIFICATIONS
 OF 1936, AS APPROVED DECEMBER 29TH, 1936 BY THE PUBLIC
 ROADS ADMINISTRATION, INCLUDING ALL SUBSEQUENT APPROVED
 REVISIONS AND SUCH REVISED SPECIFICATIONS AND SPECIAL
 PROVISIONS AS ARE SUBMITTED WITH THE PLANS.

RECOMMENDED FOR APPROVAL

DISTRICT ENGINEER PUBLIC ROADS ADMINISTRATION FEDERAL WORKS AGENCY
APPROVED
COMMISSIONER PUBLIC ROADS ADMINISTRATION FEDERAL WORKS AGENCY

APPROVED: June 1, 1940 C. W. Wainwright ROAD ENGINEER	APPROVED: June 1, 1940 H. Sturgis DISTRICT HIGHWAY COMMISSIONER	SERIES F.A.P. NO. 109-H(1) FILED SHEET (1) OF 25
---	---	---