
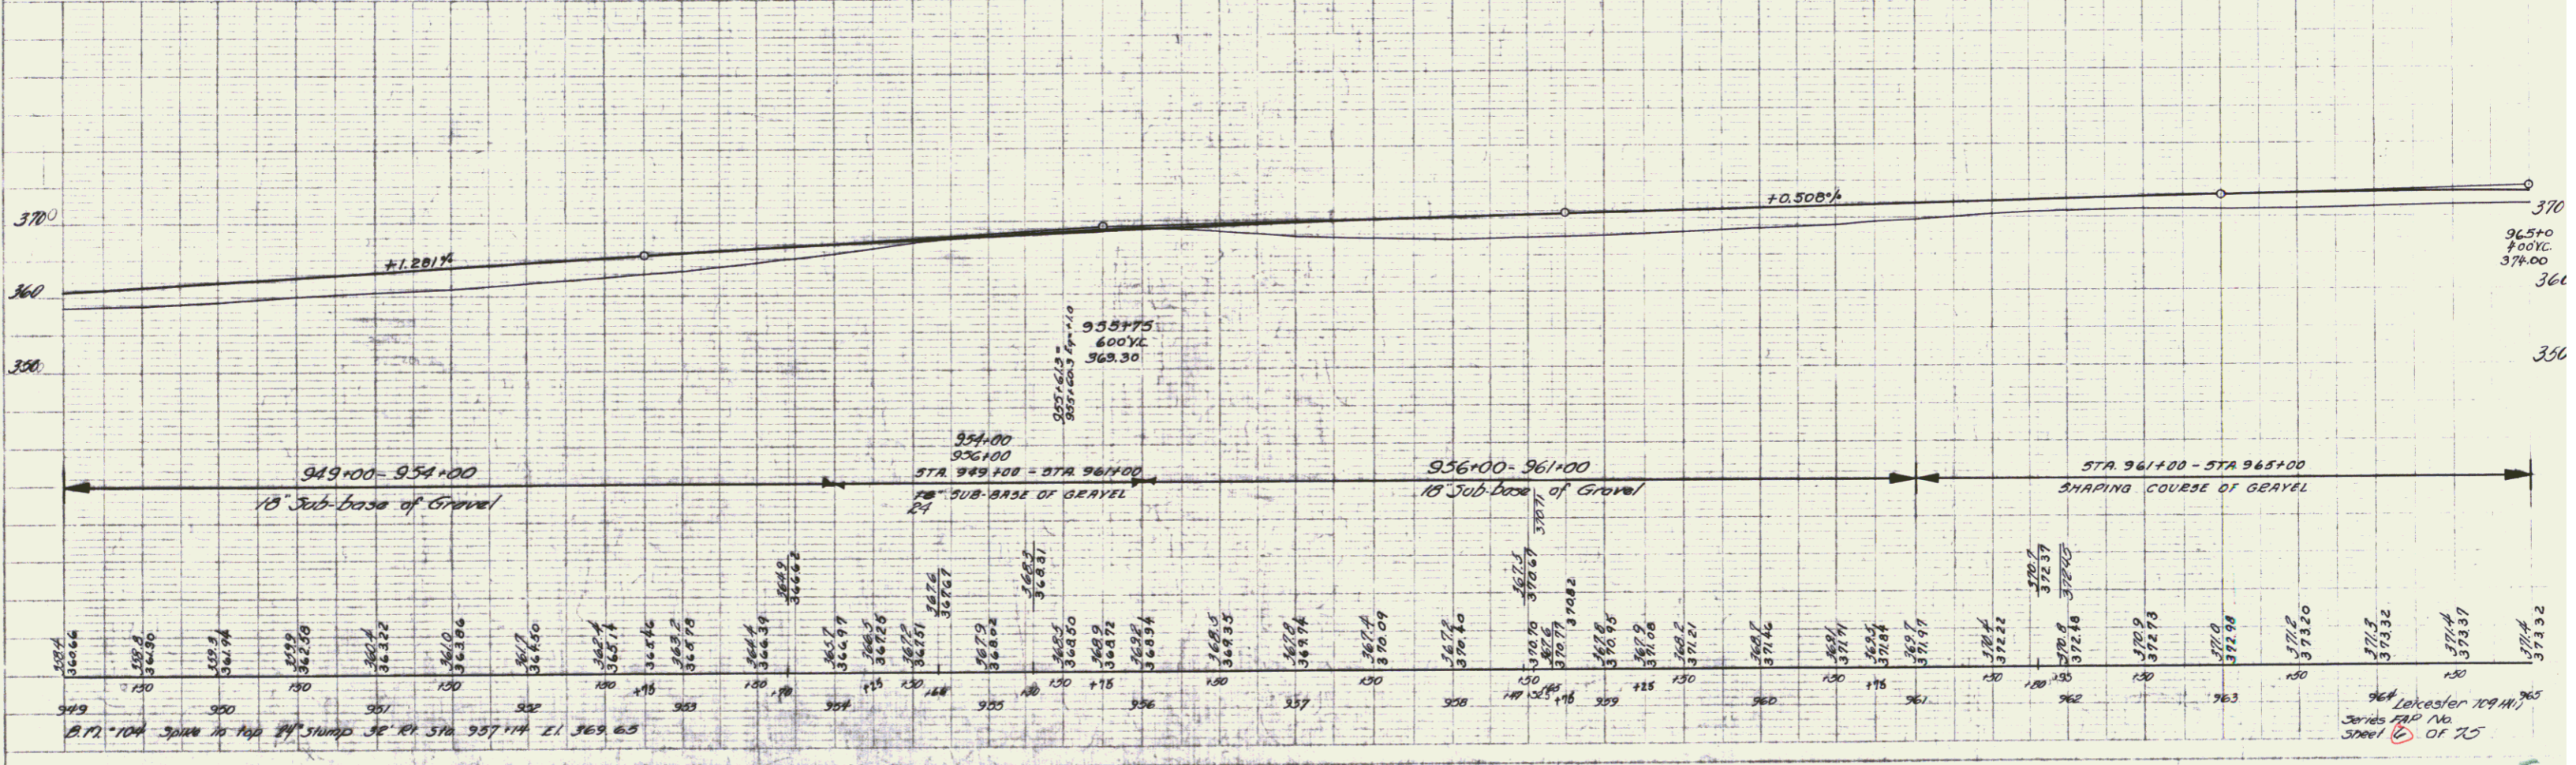


PARCEL	INSTRUMENT	DATE	GRANTOR	GRANTEE	RECORDED	REMARKS
A, B	W002	7-23-40	LEO H FLETCHER	ST OF VT	122-25	7-30-40
B	W002	7-23-40	FRANK & DORIS TYLER	ST OF VT	122-25	7-30-40

FED. ROAD DIST. NO.	STATE	FED. AID PROJ. NO.	FISCAL YEAR	SHEET NO.	TOTAL SHEETS
9	VT	109(RL)	1941	6	25

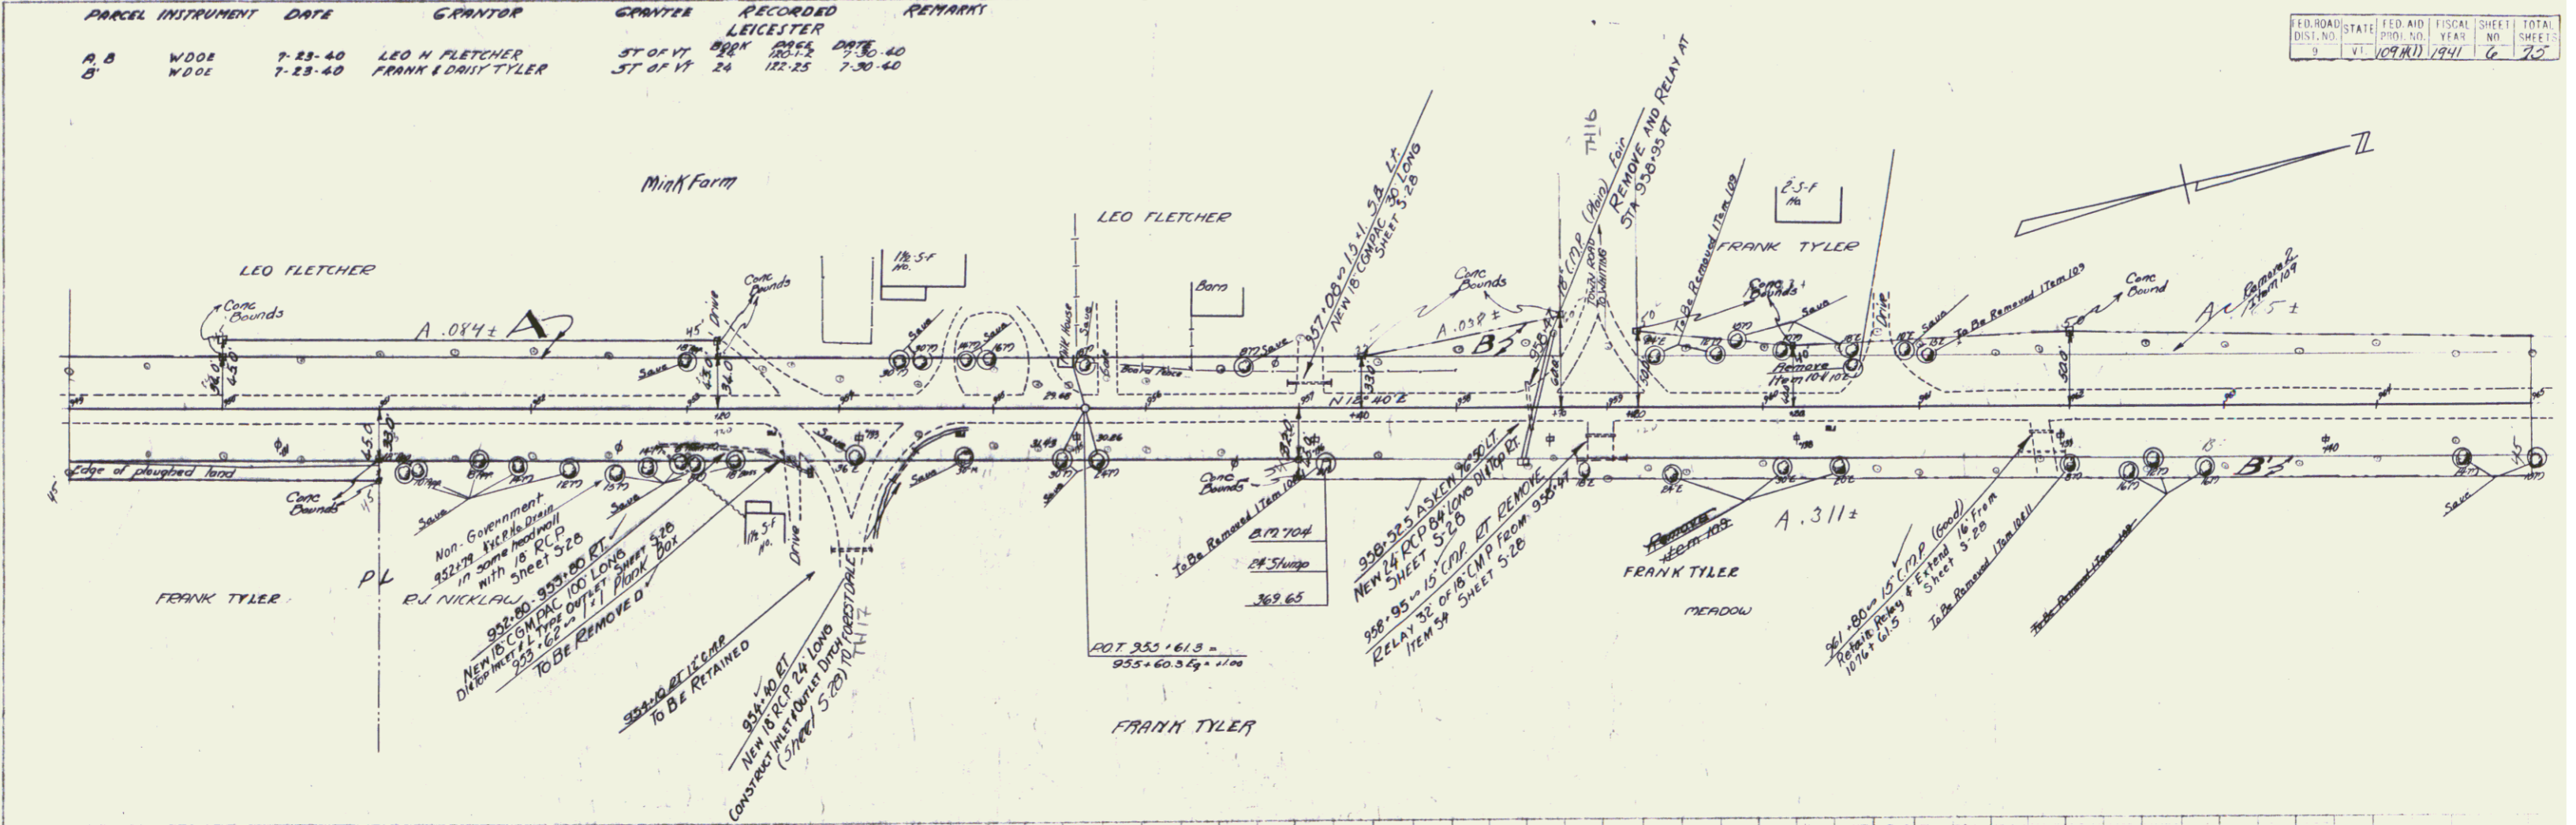

APPROVED  
 BY  
 DATE

APPROVED  
 BY  
 DATE

1st of 25  
 2nd of 25  
 3rd of 25  
 4th of 25  
 5th of 25  
 6th of 25  
 7th of 25  
 8th of 25  
 9th of 25  
 10th of 25  
 11th of 25  
 12th of 25  
 13th of 25  
 14th of 25  
 15th of 25  
 16th of 25  
 17th of 25  
 18th of 25  
 19th of 25  
 20th of 25  
 21st of 25  
 22nd of 25  
 23rd of 25  
 24th of 25  
 25th of 25