
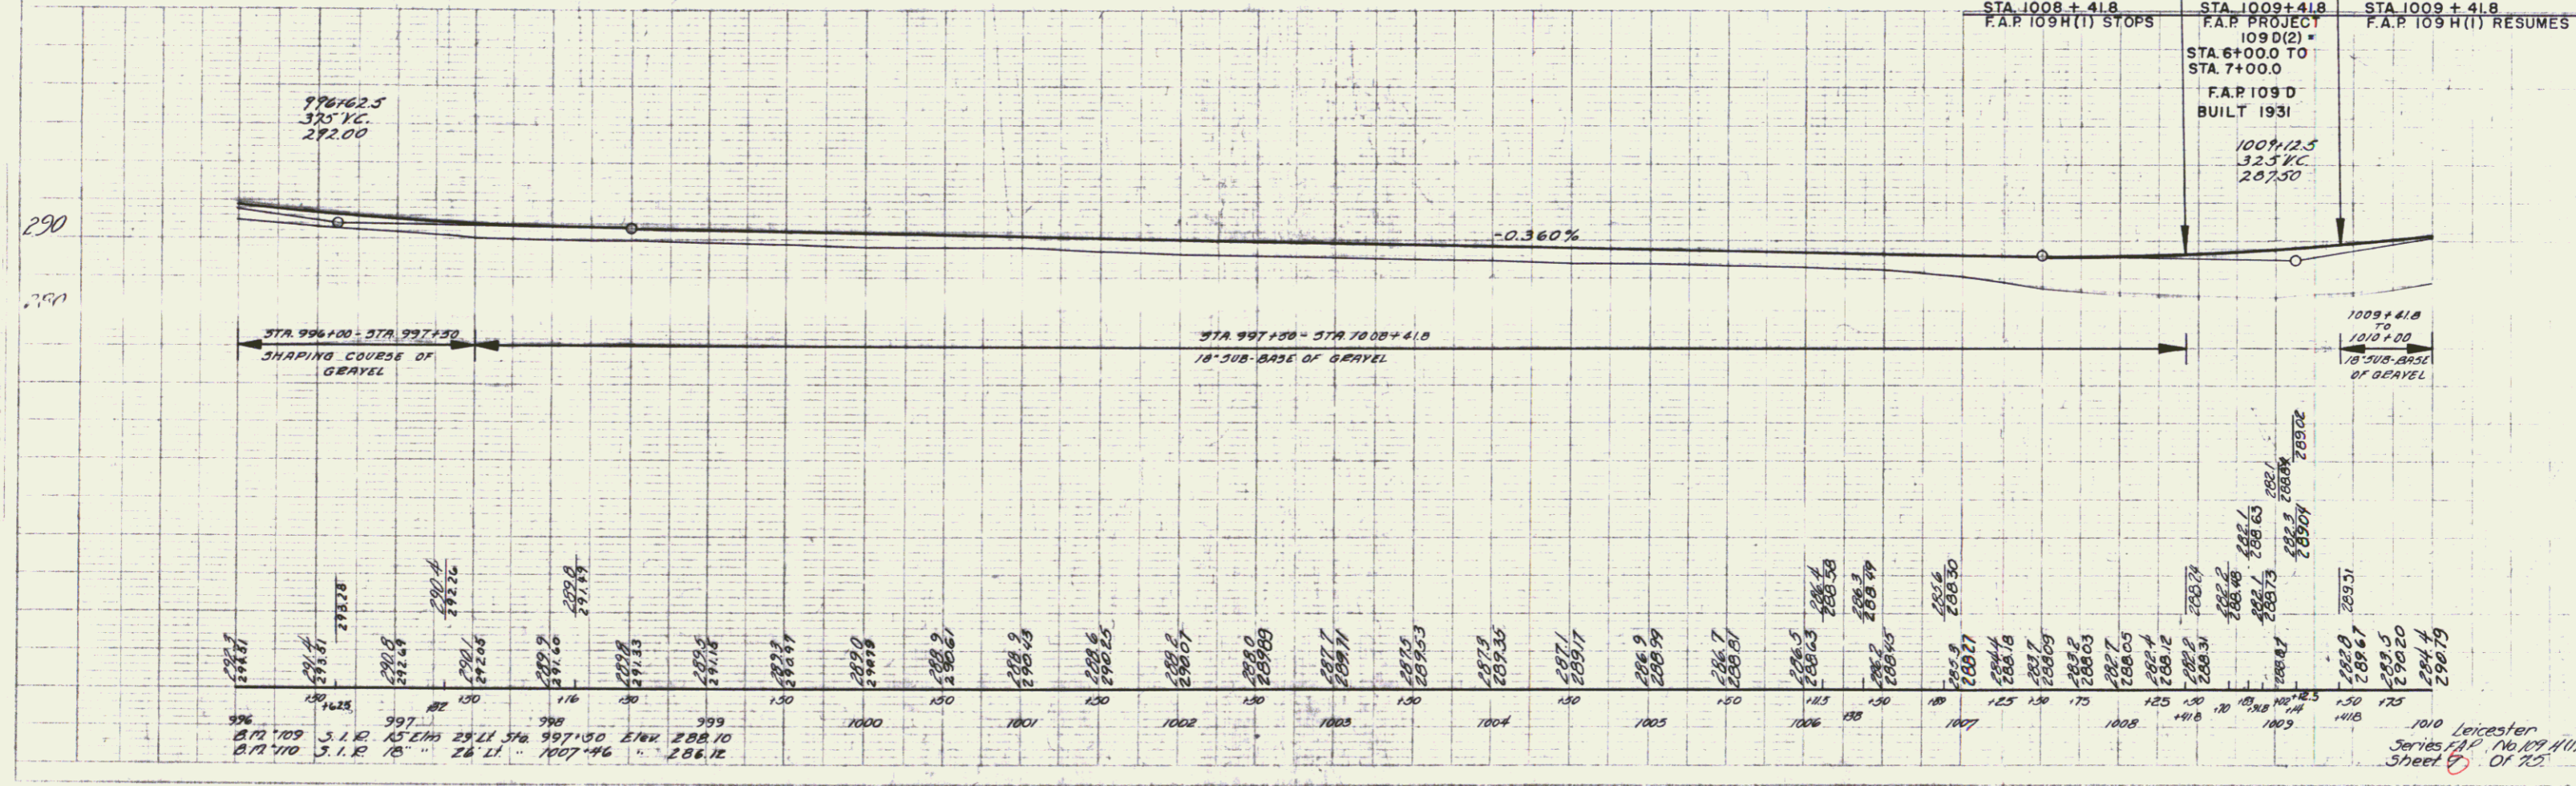


PARCEL INSTRUMENT	DATE	GRANTOR	GRANTEE	RECORDED	REMARKS		
D	V D O E	7-23-40	HOLT & RUBY PARBODY	ST. OF VT.	26	126-29	7-30-40
A.B.	G D O E	8-23-40	Mrs. KENNETH WILLIAMS (Guardian)	ST. OF VT.	26	163-65	8-28-41

FED. ROAD DIST. NO.	STATE	FED. AID	LOCAL	SHEET NO.	TOTAL SHEETS
9	VT	109	111	9	75

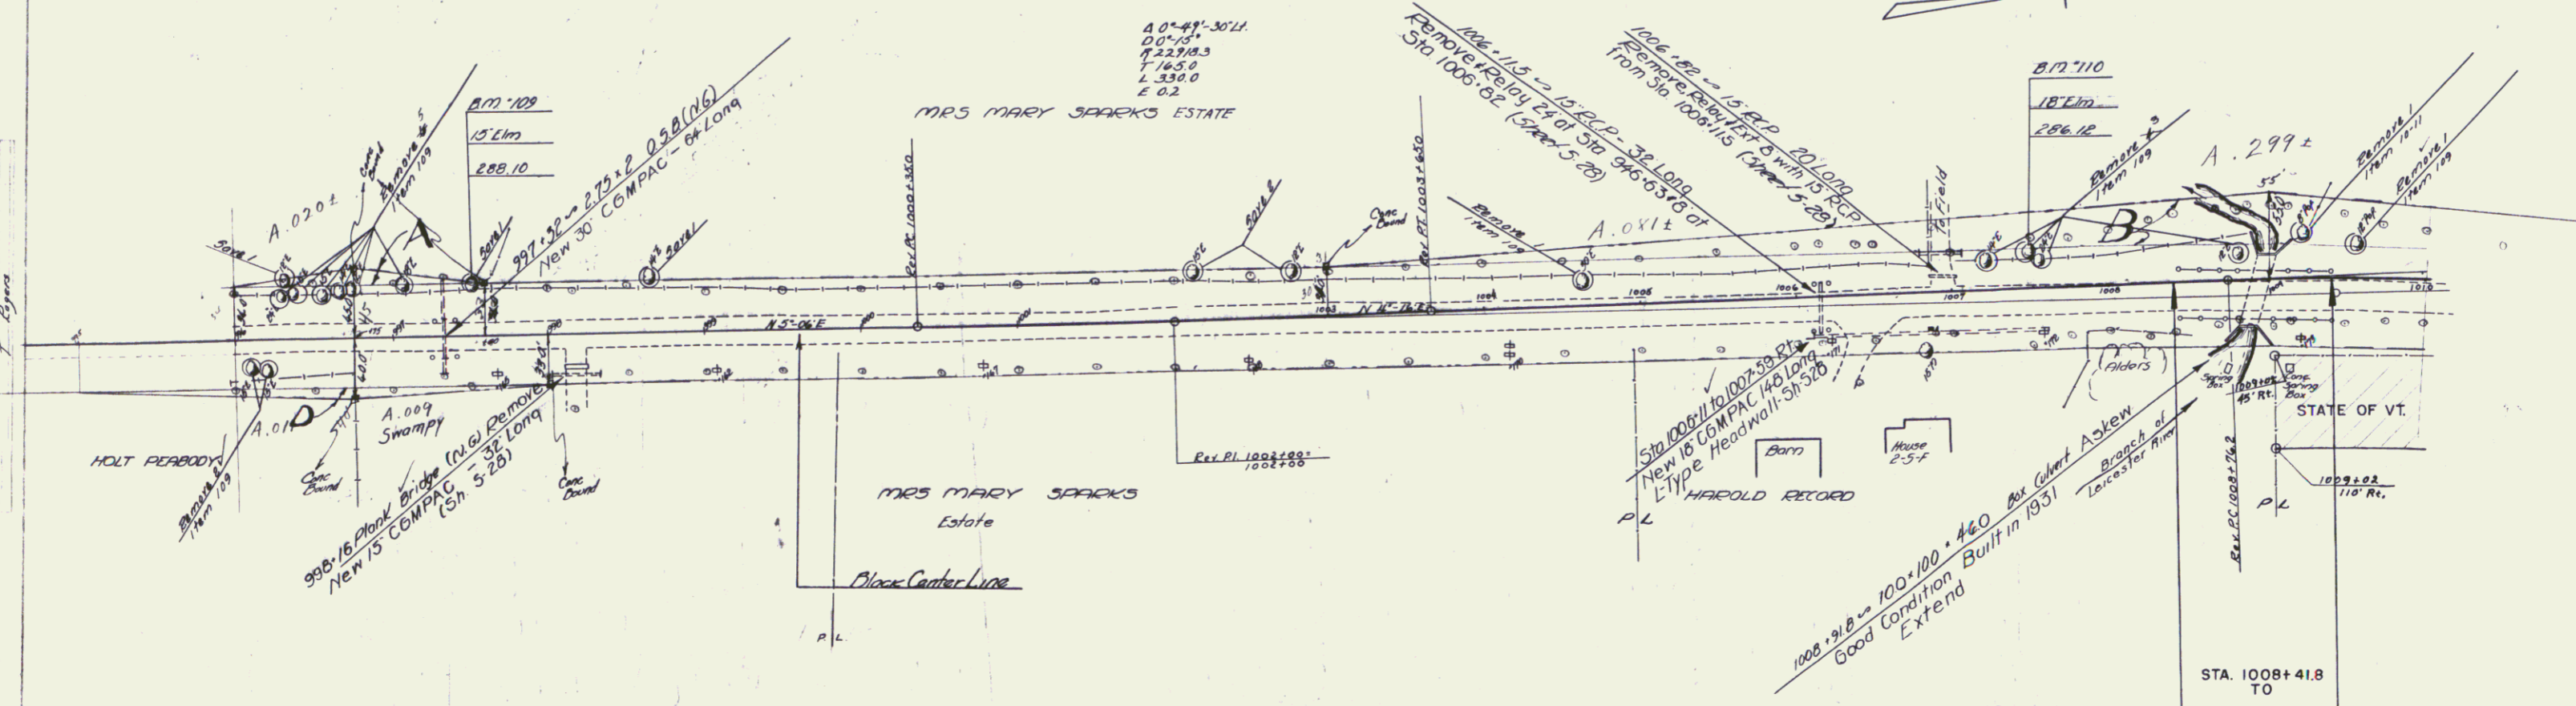

Station	Elevation	Station	Elevation	Station	Elevation	Station	Elevation
996+00	286.12	997+00	287.10	998+00	288.10	999+00	289.10
997+00	287.10	998+00	288.10	999+00	289.10	1000+00	290.10
998+00	288.10	999+00	289.10	1000+00	290.10	1001+00	291.10
999+00	289.10	1000+00	290.10	1001+00	291.10	1002+00	292.10
1000+00	290.10	1001+00	291.10	1002+00	292.10	1003+00	293.10
1001+00	291.10	1002+00	292.10	1003+00	293.10	1004+00	294.10
1002+00	292.10	1003+00	293.10	1004+00	294.10	1005+00	295.10
1003+00	293.10	1004+00	294.10	1005+00	295.10	1006+00	296.10
1004+00	294.10	1005+00	295.10	1006+00	296.10	1007+00	297.10
1005+00	295.10	1006+00	296.10	1007+00	297.10	1008+00	298.10
1006+00	296.10	1007+00	297.10	1008+00	298.10	1009+00	299.10
1007+00	297.10	1008+00	298.10	1009+00	299.10	1010+00	300.10
1008+00	298.10	1009+00	299.10	1010+00	300.10		
1009+00	299.10						
1010+00	300.10						

1010 Leicester Series (A.P. No. 109 H(1)) Sheet 9 of 75