
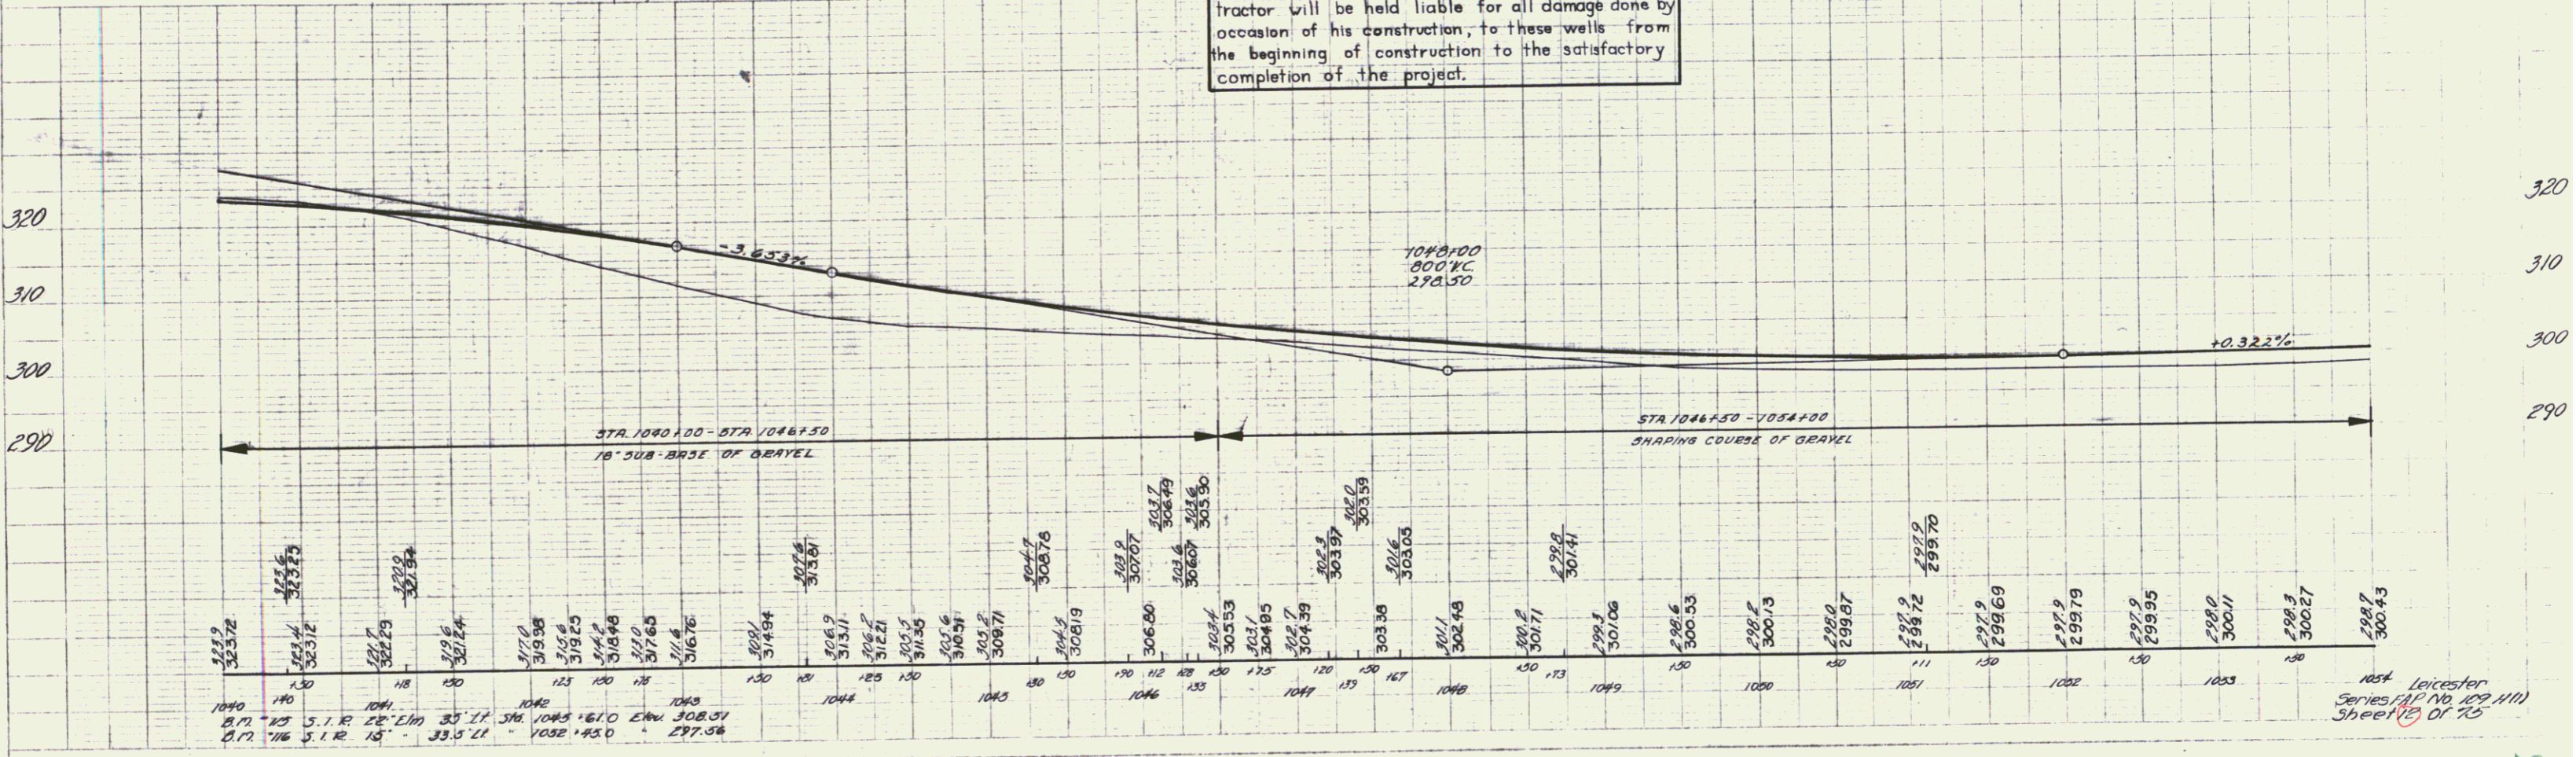


PARCEL	INSTRUMENT	DATE	GRANTOR	GRANTEE	RECORDED LEICESTER	REMARKS
A, B	WDOE	7-23-40	EVA SEYMOUR	ST OF RR	24 135-37	7-30-40 1 CULV
B'	WDOE	8-5-40	BURTON FISKE	ST OF RR	24 135-37	8-22-40 1 CULV
A' B'	WDOE	7-23-40	JOHN & ELSIE HOUGH	ST OF RR	24 137-40	7-30-40

ED. ROAD	STATE	ED. AID	TOTAL SHEET	TOTAL SHEETS
9	VI.	129 RD. 1941	12	12

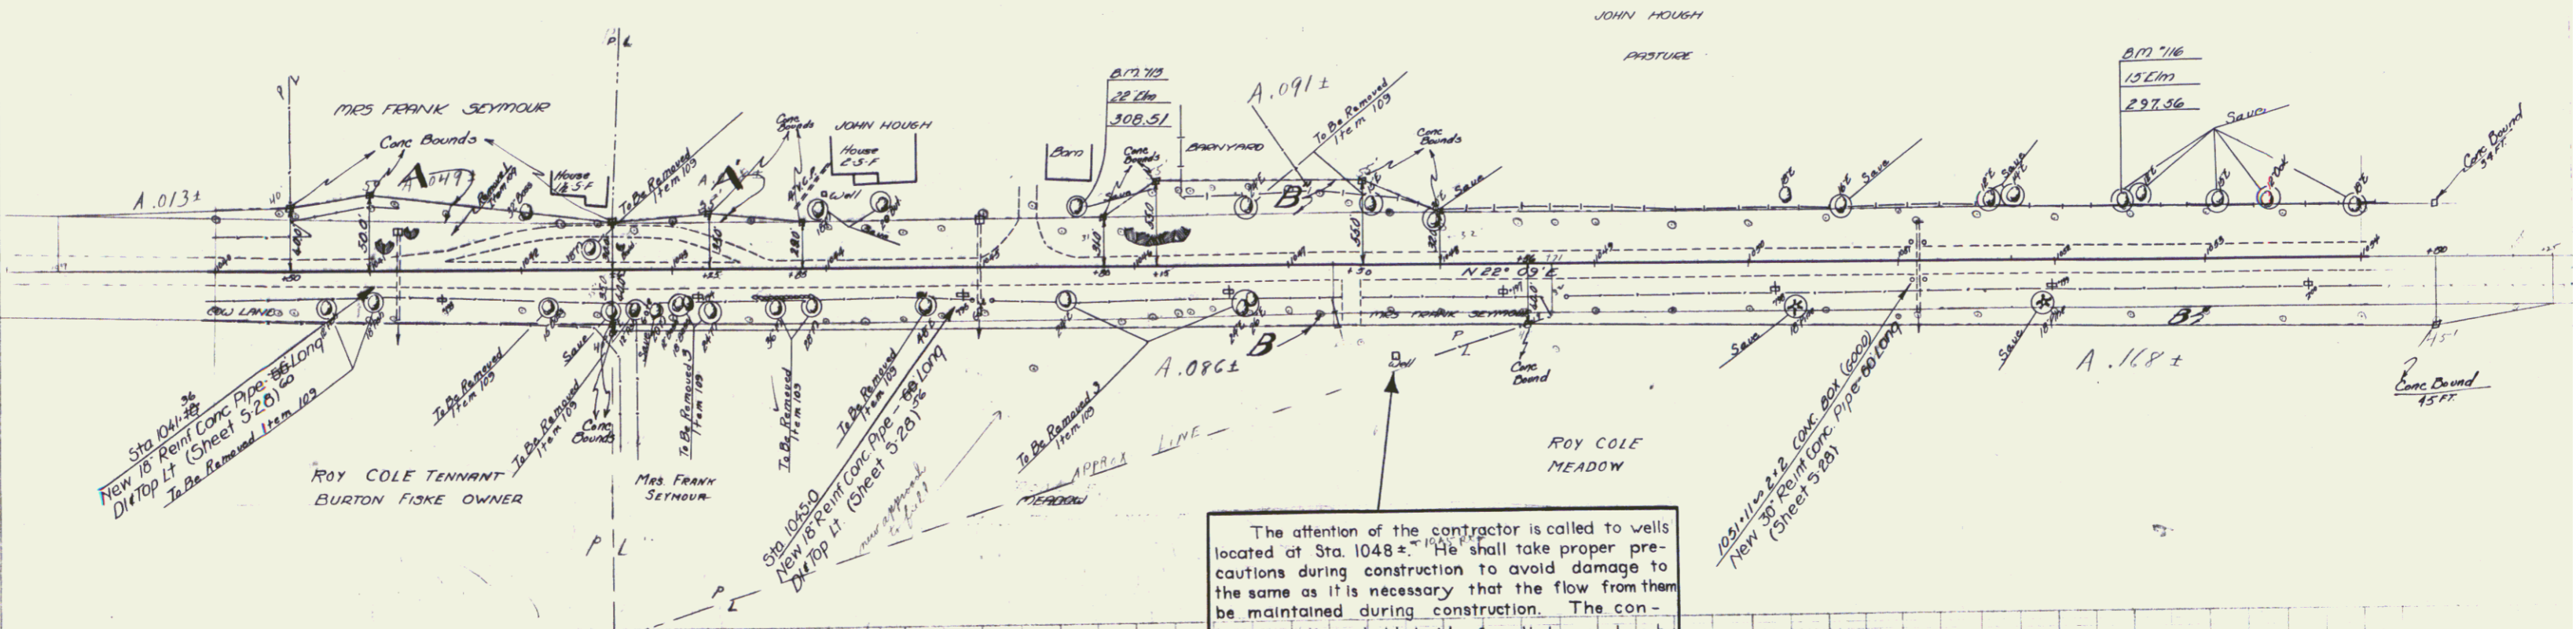

1054 Leicester Series (P.P. No. 109, 111) Sheet 12 of 15