
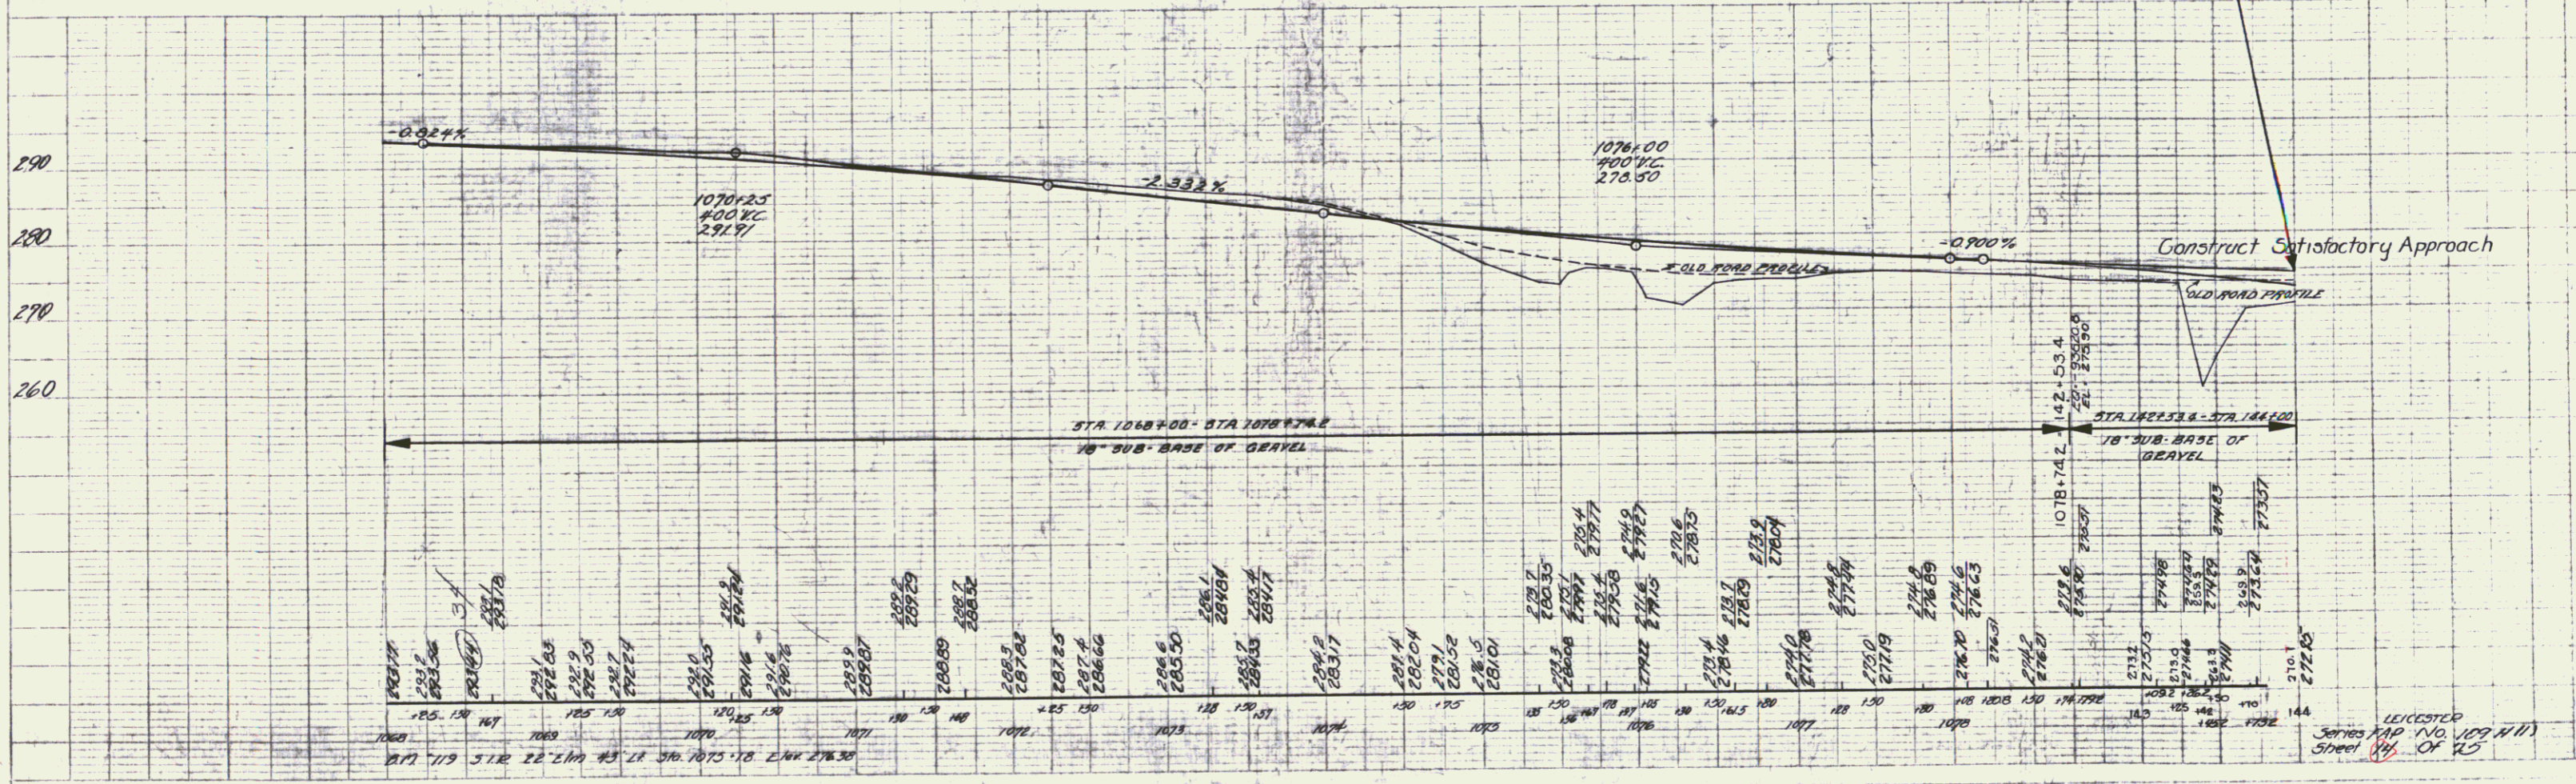


PARCEL INSTRUMENT	DATE	GRANTOR	GRANTEE	RECORDED	REMARK
A.B.C. W.D.O.E.	8.23.40	EARL ELIZABETH O'BYRN	ST OF V	26 148-51 8-3-40	5 CULV.

FED. ROAD DIST. NO.	STATE	FED. AID PROJ. NO.	FISCAL YEAR	SHEET NO.	TOTAL SHEETS
4	VT	109-H(1)	1944	11	22

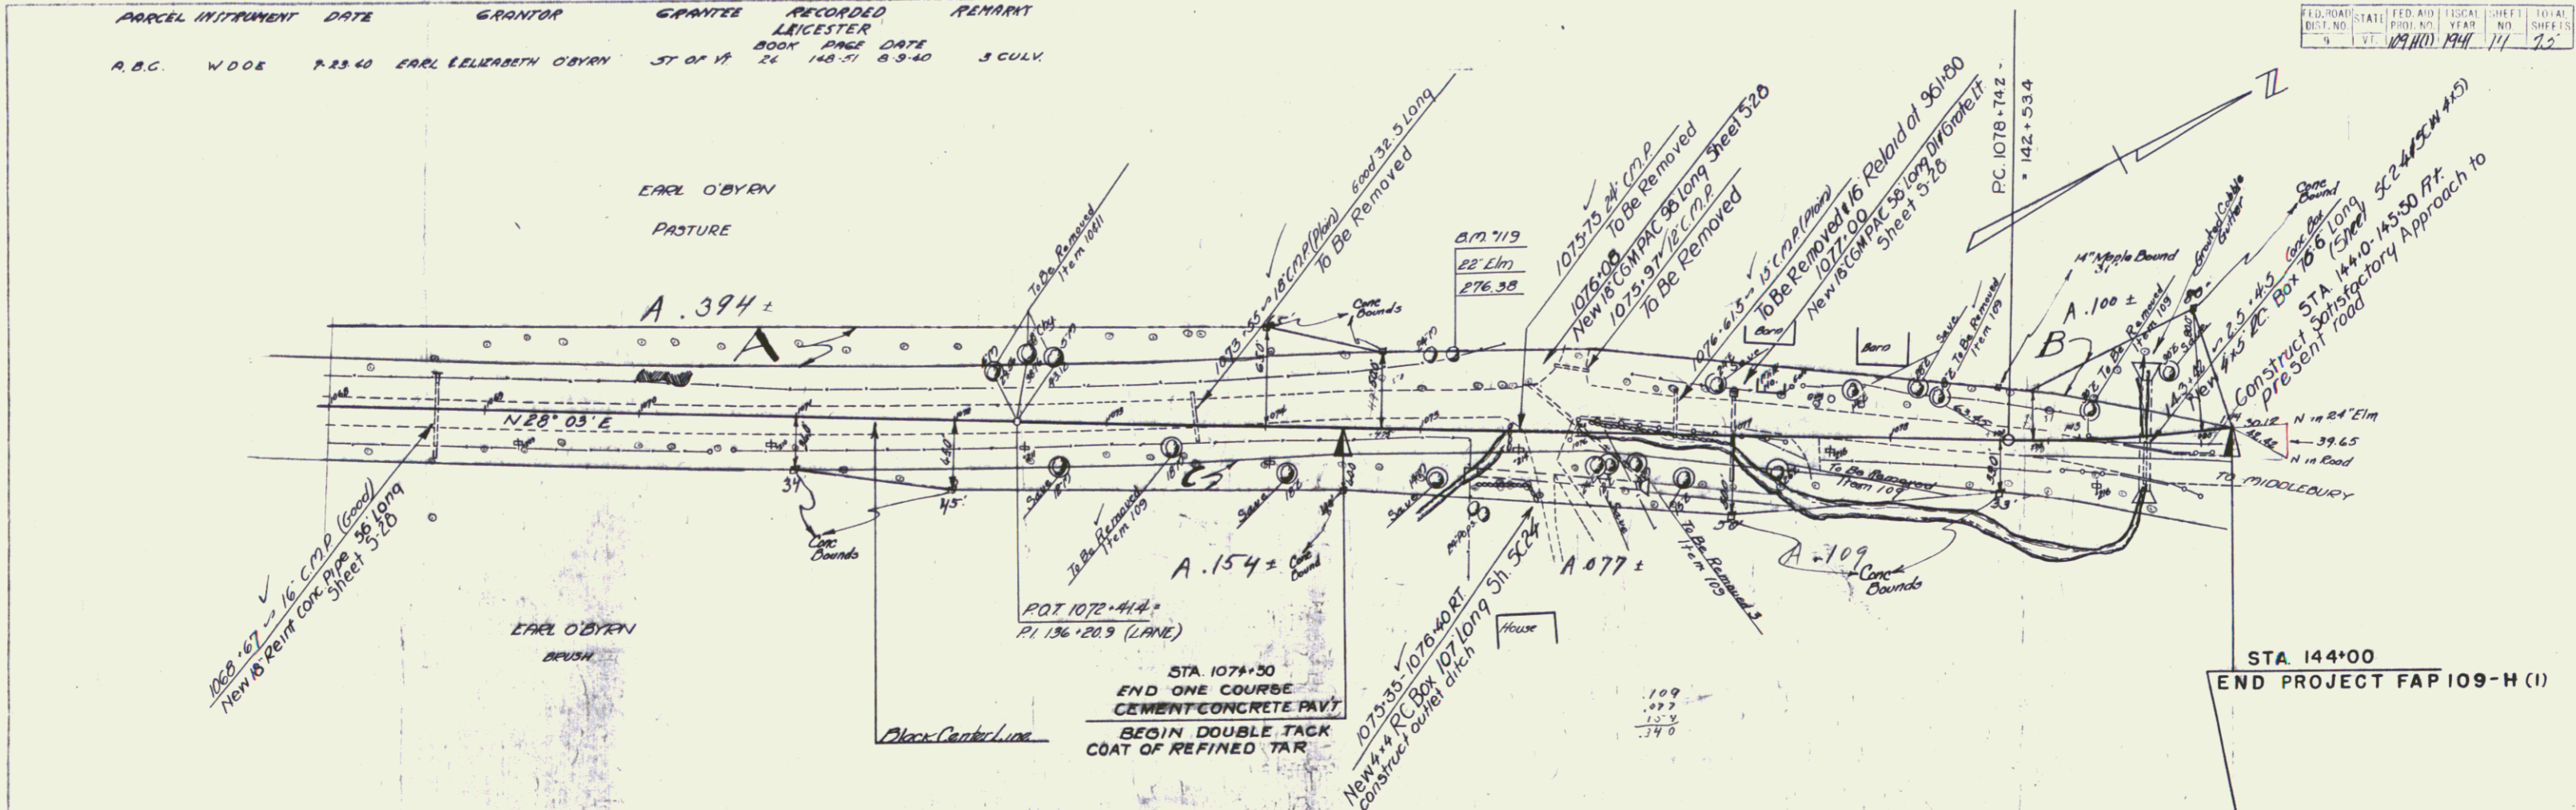

PLAN
 APPROXIMATE
 1:1000
 1/4" = 100'

PROFILE
 1" = 10'
 1/4" = 10'

LEICESTER
 JAMES HAD. (NO. 109-H(1))
 SHEET 11 OF 22