
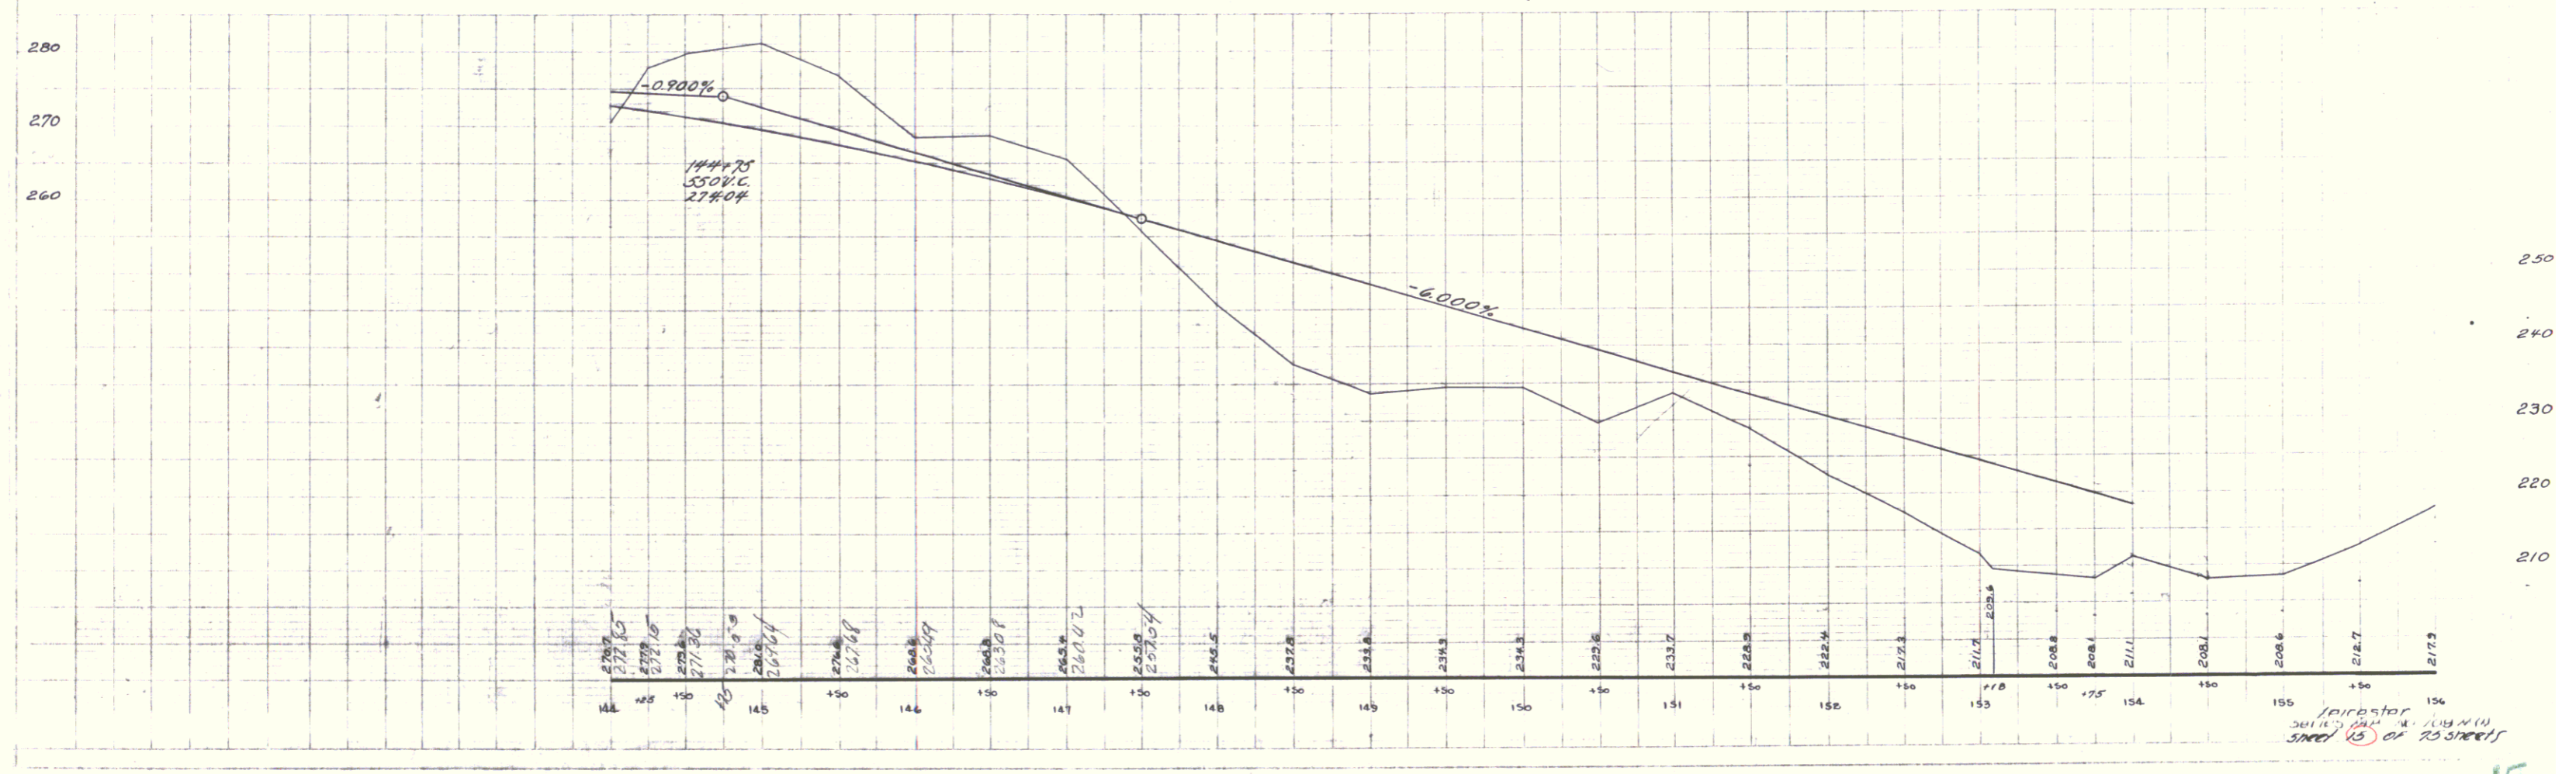


$\Delta = 32^\circ 43' 14''$   
 $D = 5''$   
 $R = 1146.3$   
 $T = 336.5$   
 $L = 659.3$   
 $E = 48.4$

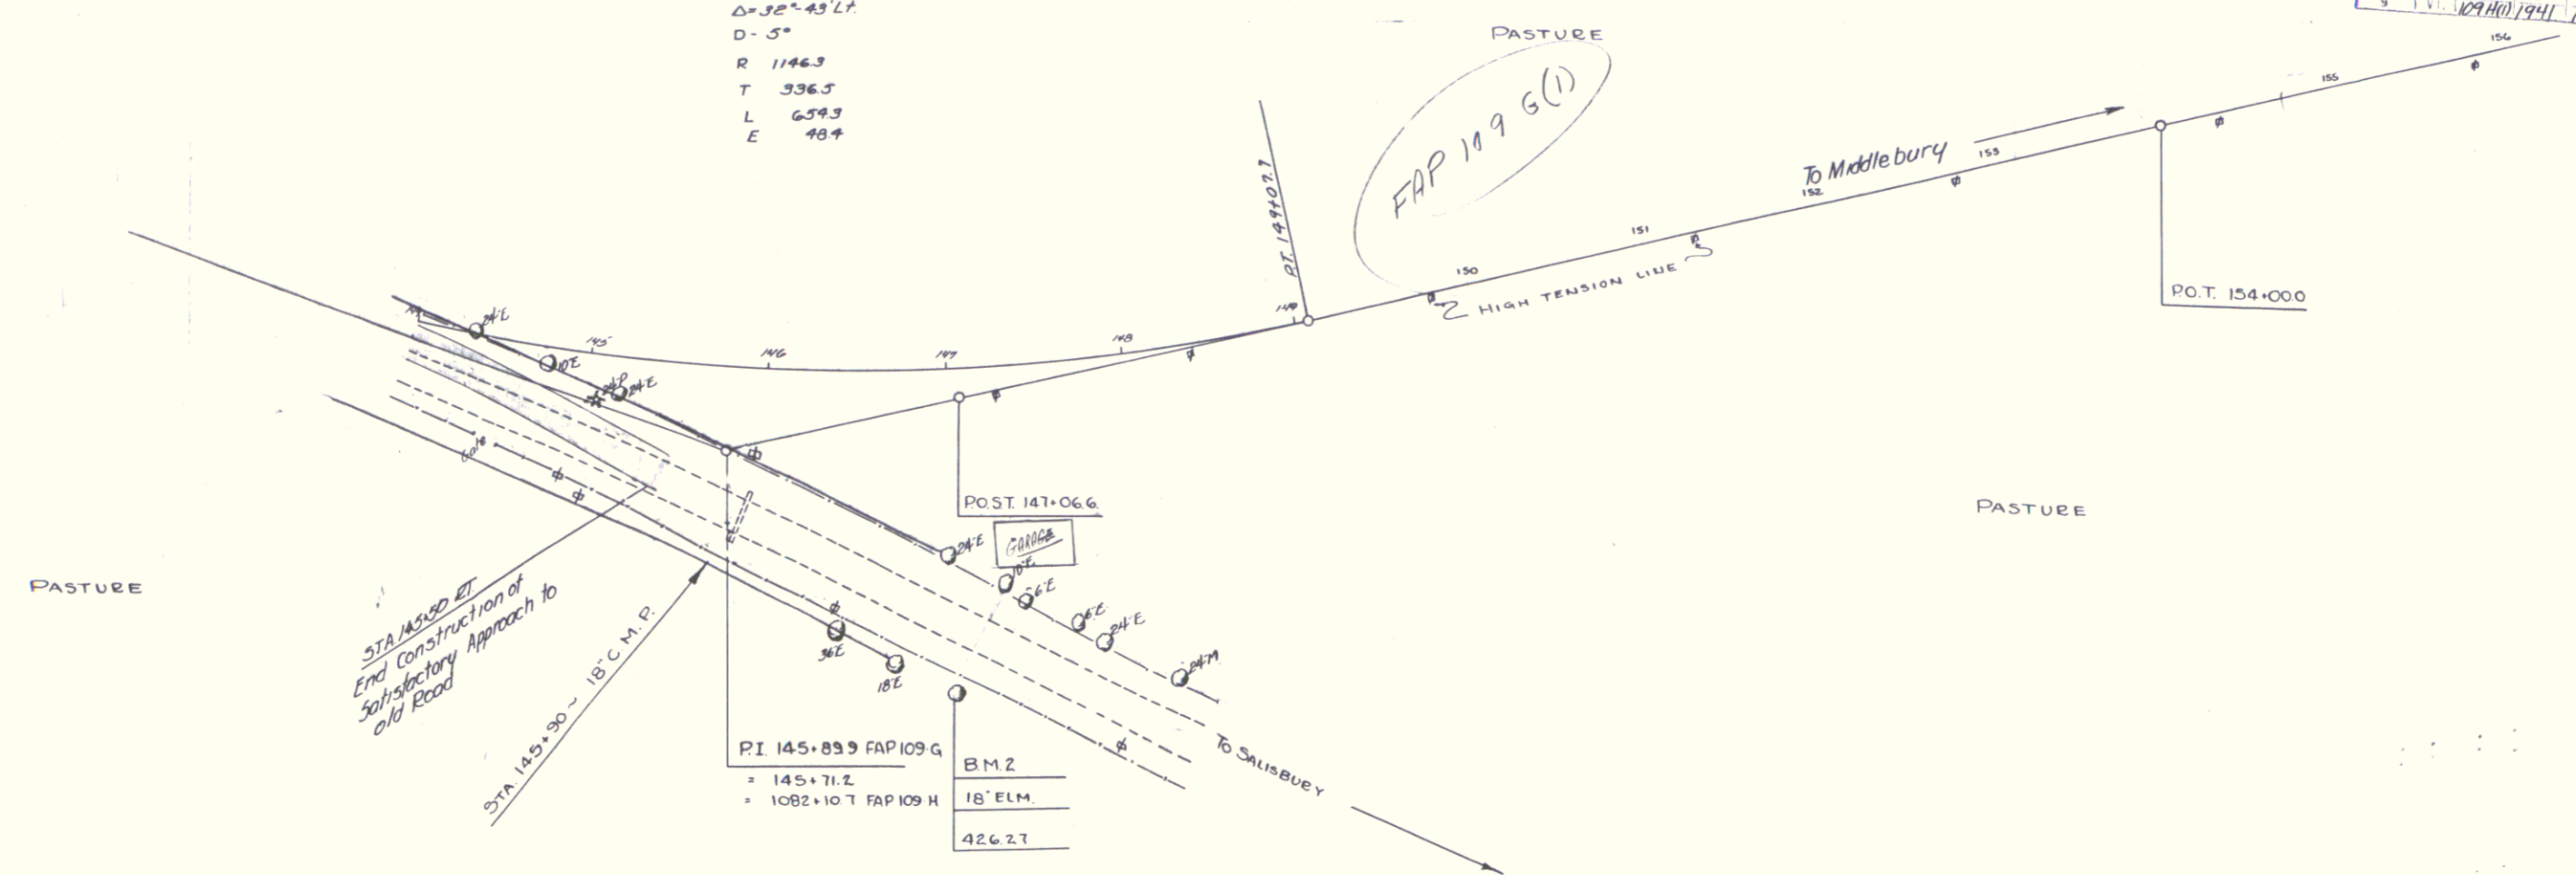

Instructor  
 SHEET 13 OF 23 SHEETS