
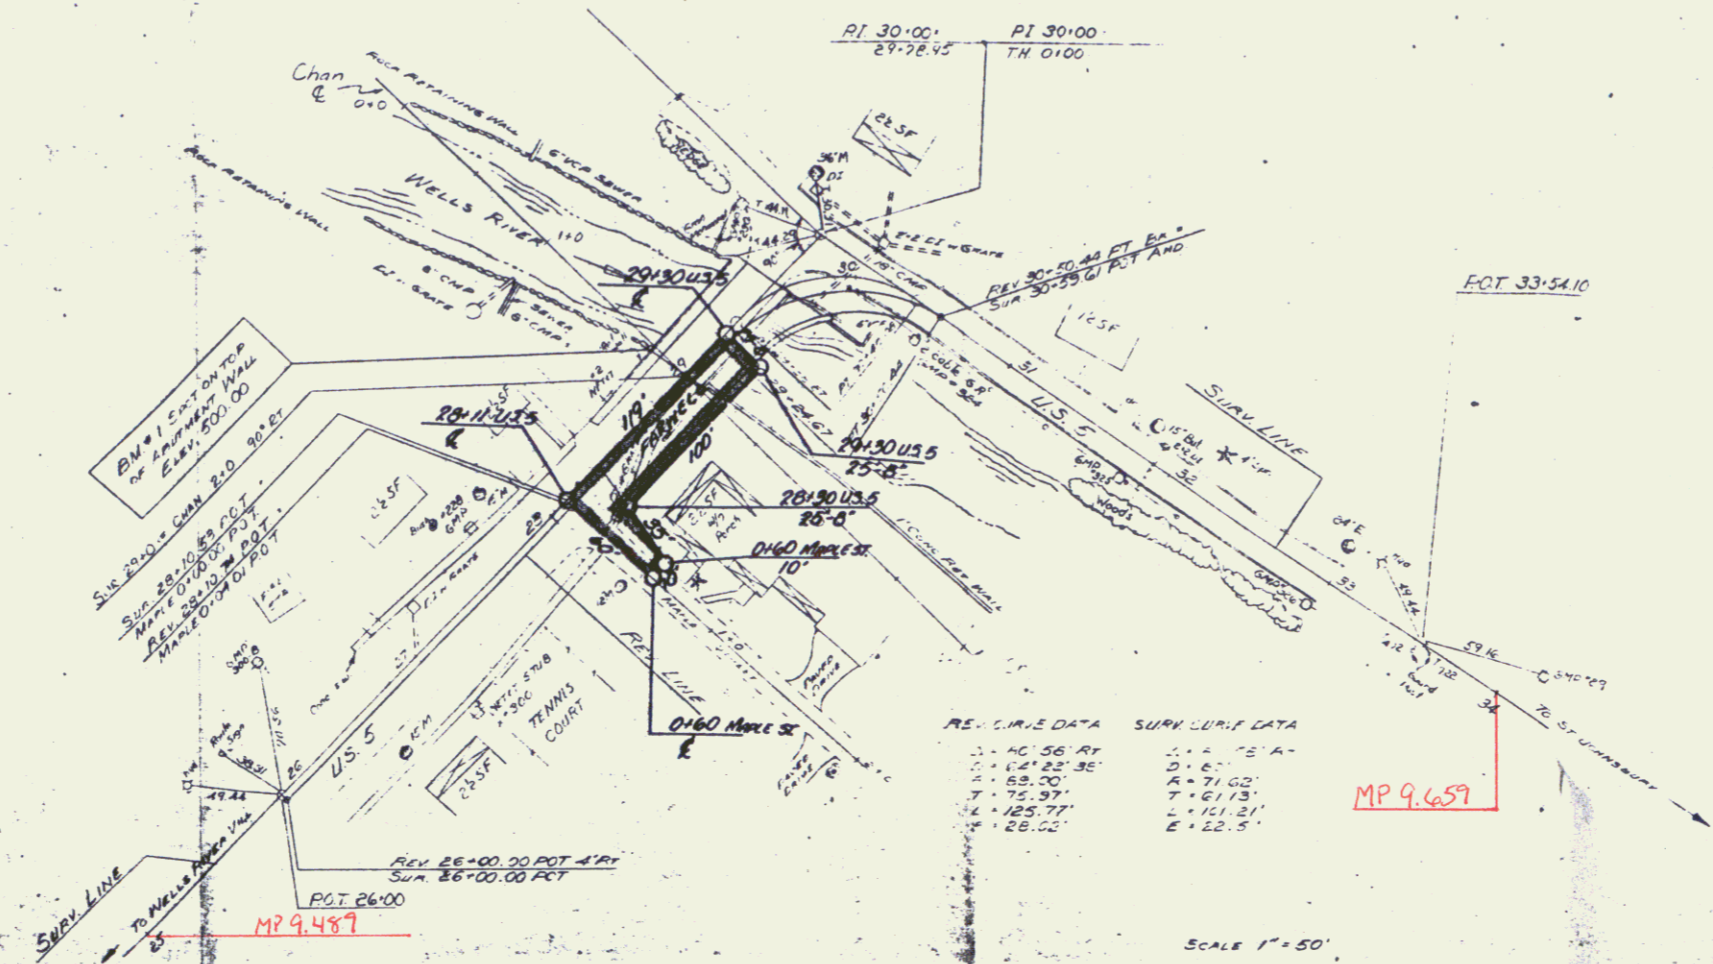


North end of Wells River Village

PLAN
CHECKED BY: []
DATE: []
NOTED BY: []
DATE: []

PROFILE
CHECKED BY: []
DATE: []
NOTED BY: []
DATE: []

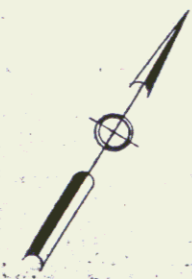

RE. CURVE DATA	SUPPLY CURVE DATA
1. 46.56' RY	1. 75' A
2. 104.25' RY	2. 12.5' A
3. 85.00'	3. 71.00'
4. 75.37'	4. 6.113'
5. 125.77'	5. 111.21'
6. 28.00'	6. 22.5'

MP 9.659

SCALE 1" = 50'

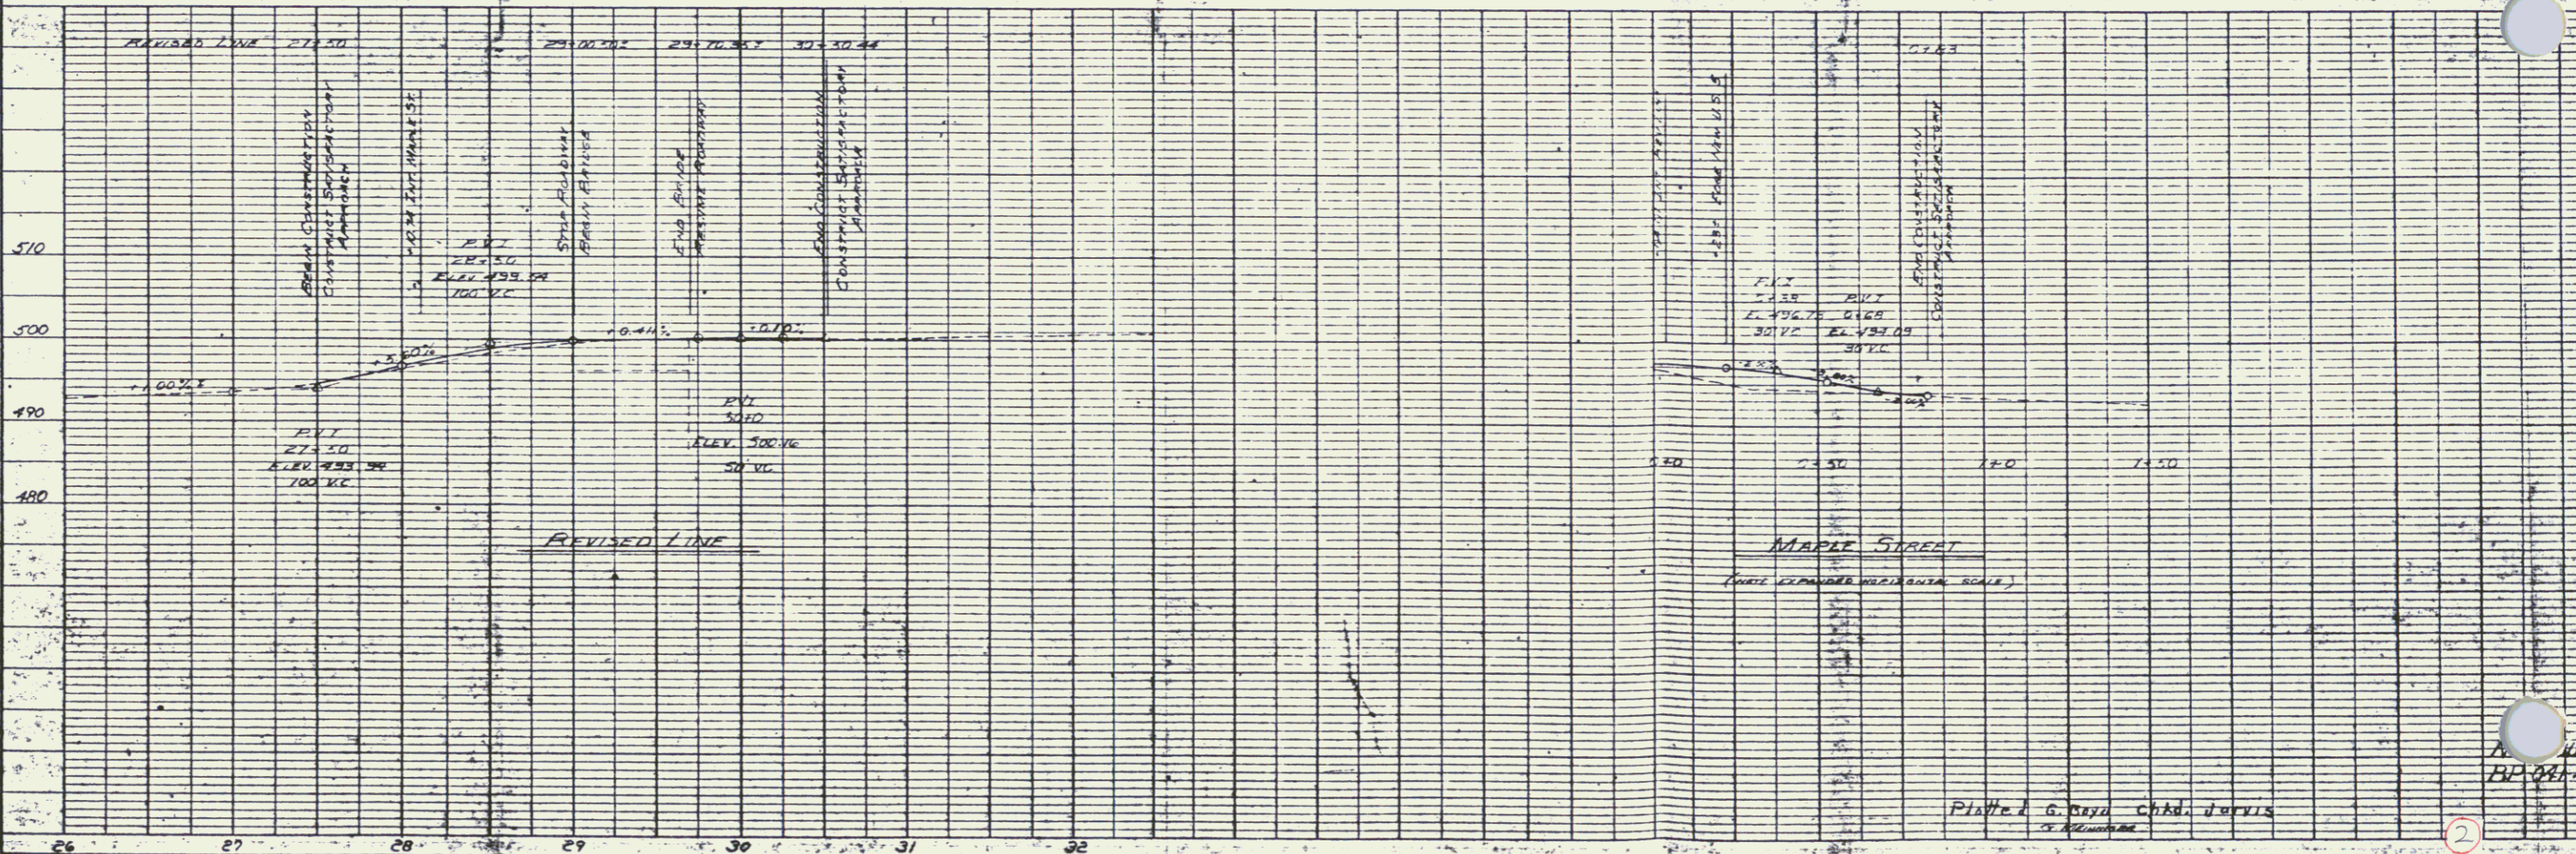


Plate 1 G. Gray Chkd. Jarvis

2