


PLAN

PROFILE

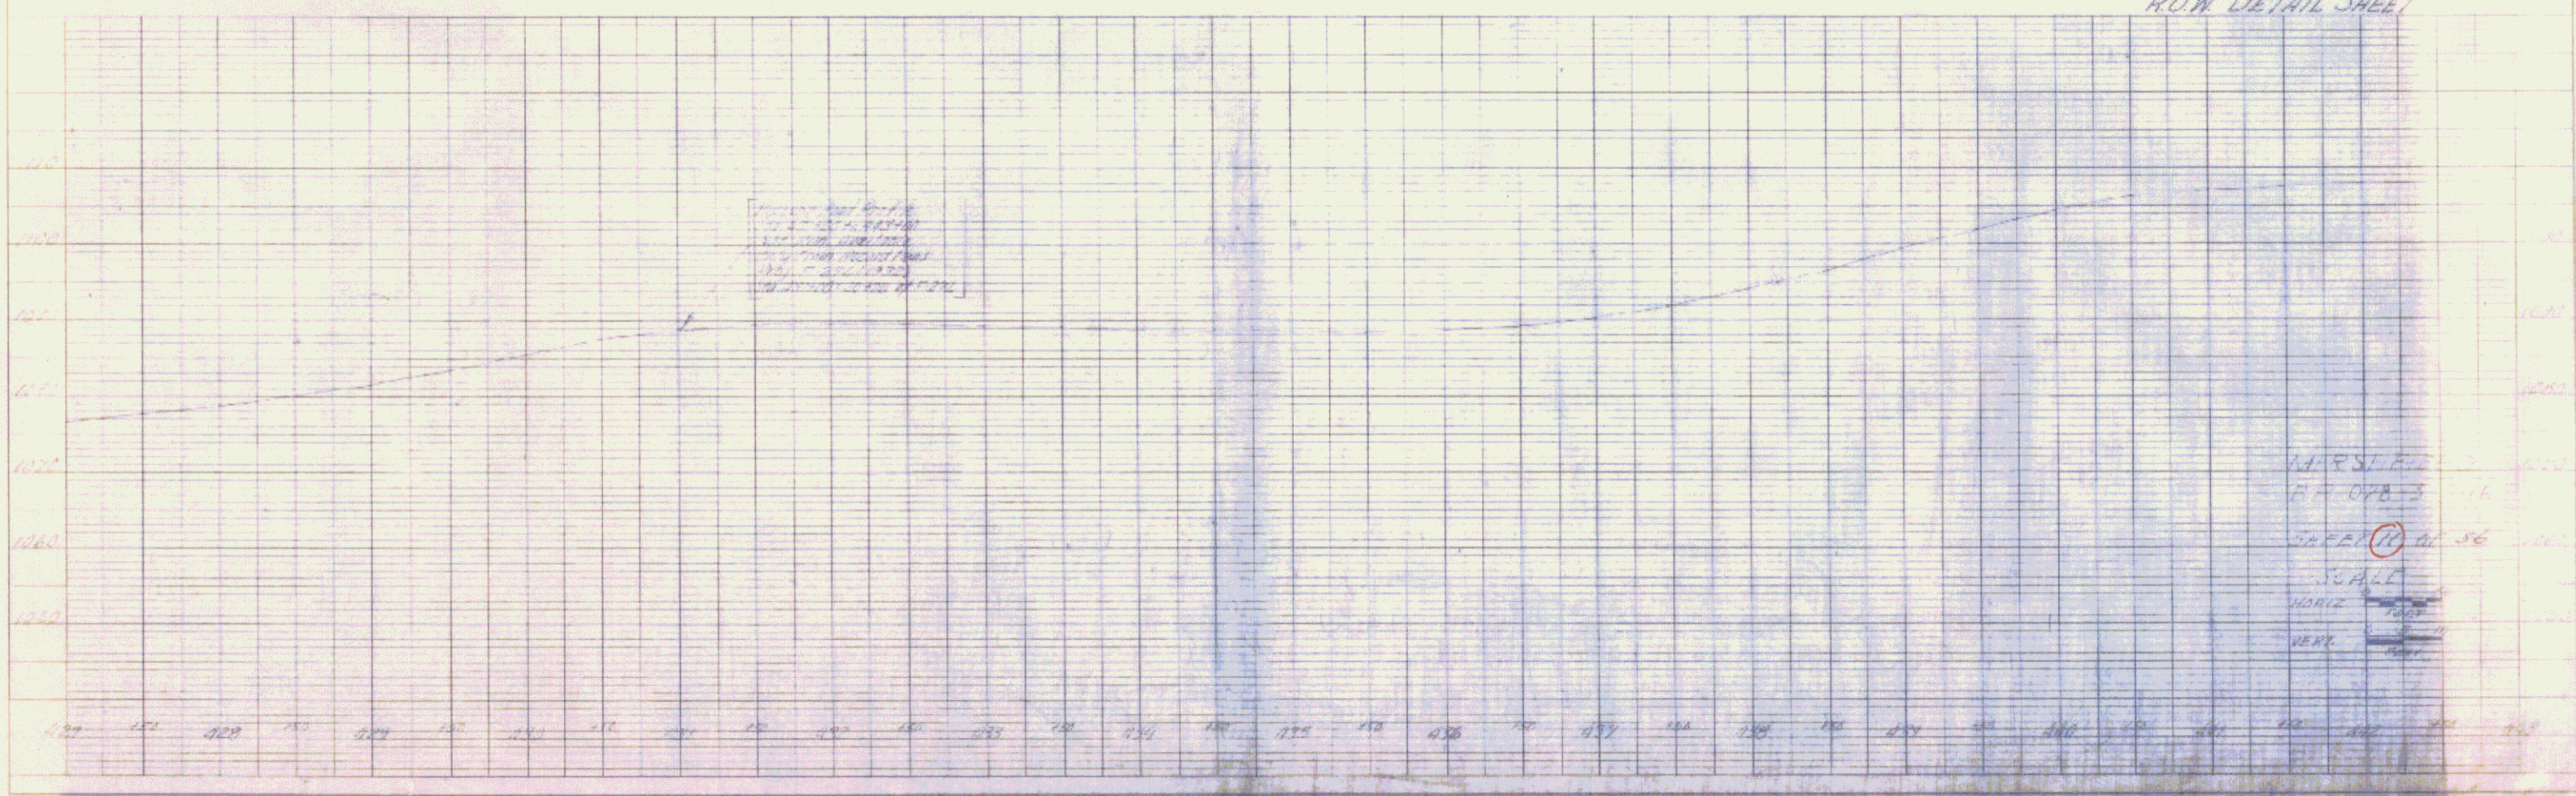

WEST END  
 H.P. 078-3  
 SHEET 10 of 56  
 SCALE  
 HORIZ. 1" = 100'  
 VERT. 1" = 10'