


6-22-2011 LANE  
 PROJECT NO. 118L  
 DATE 12/10/1940

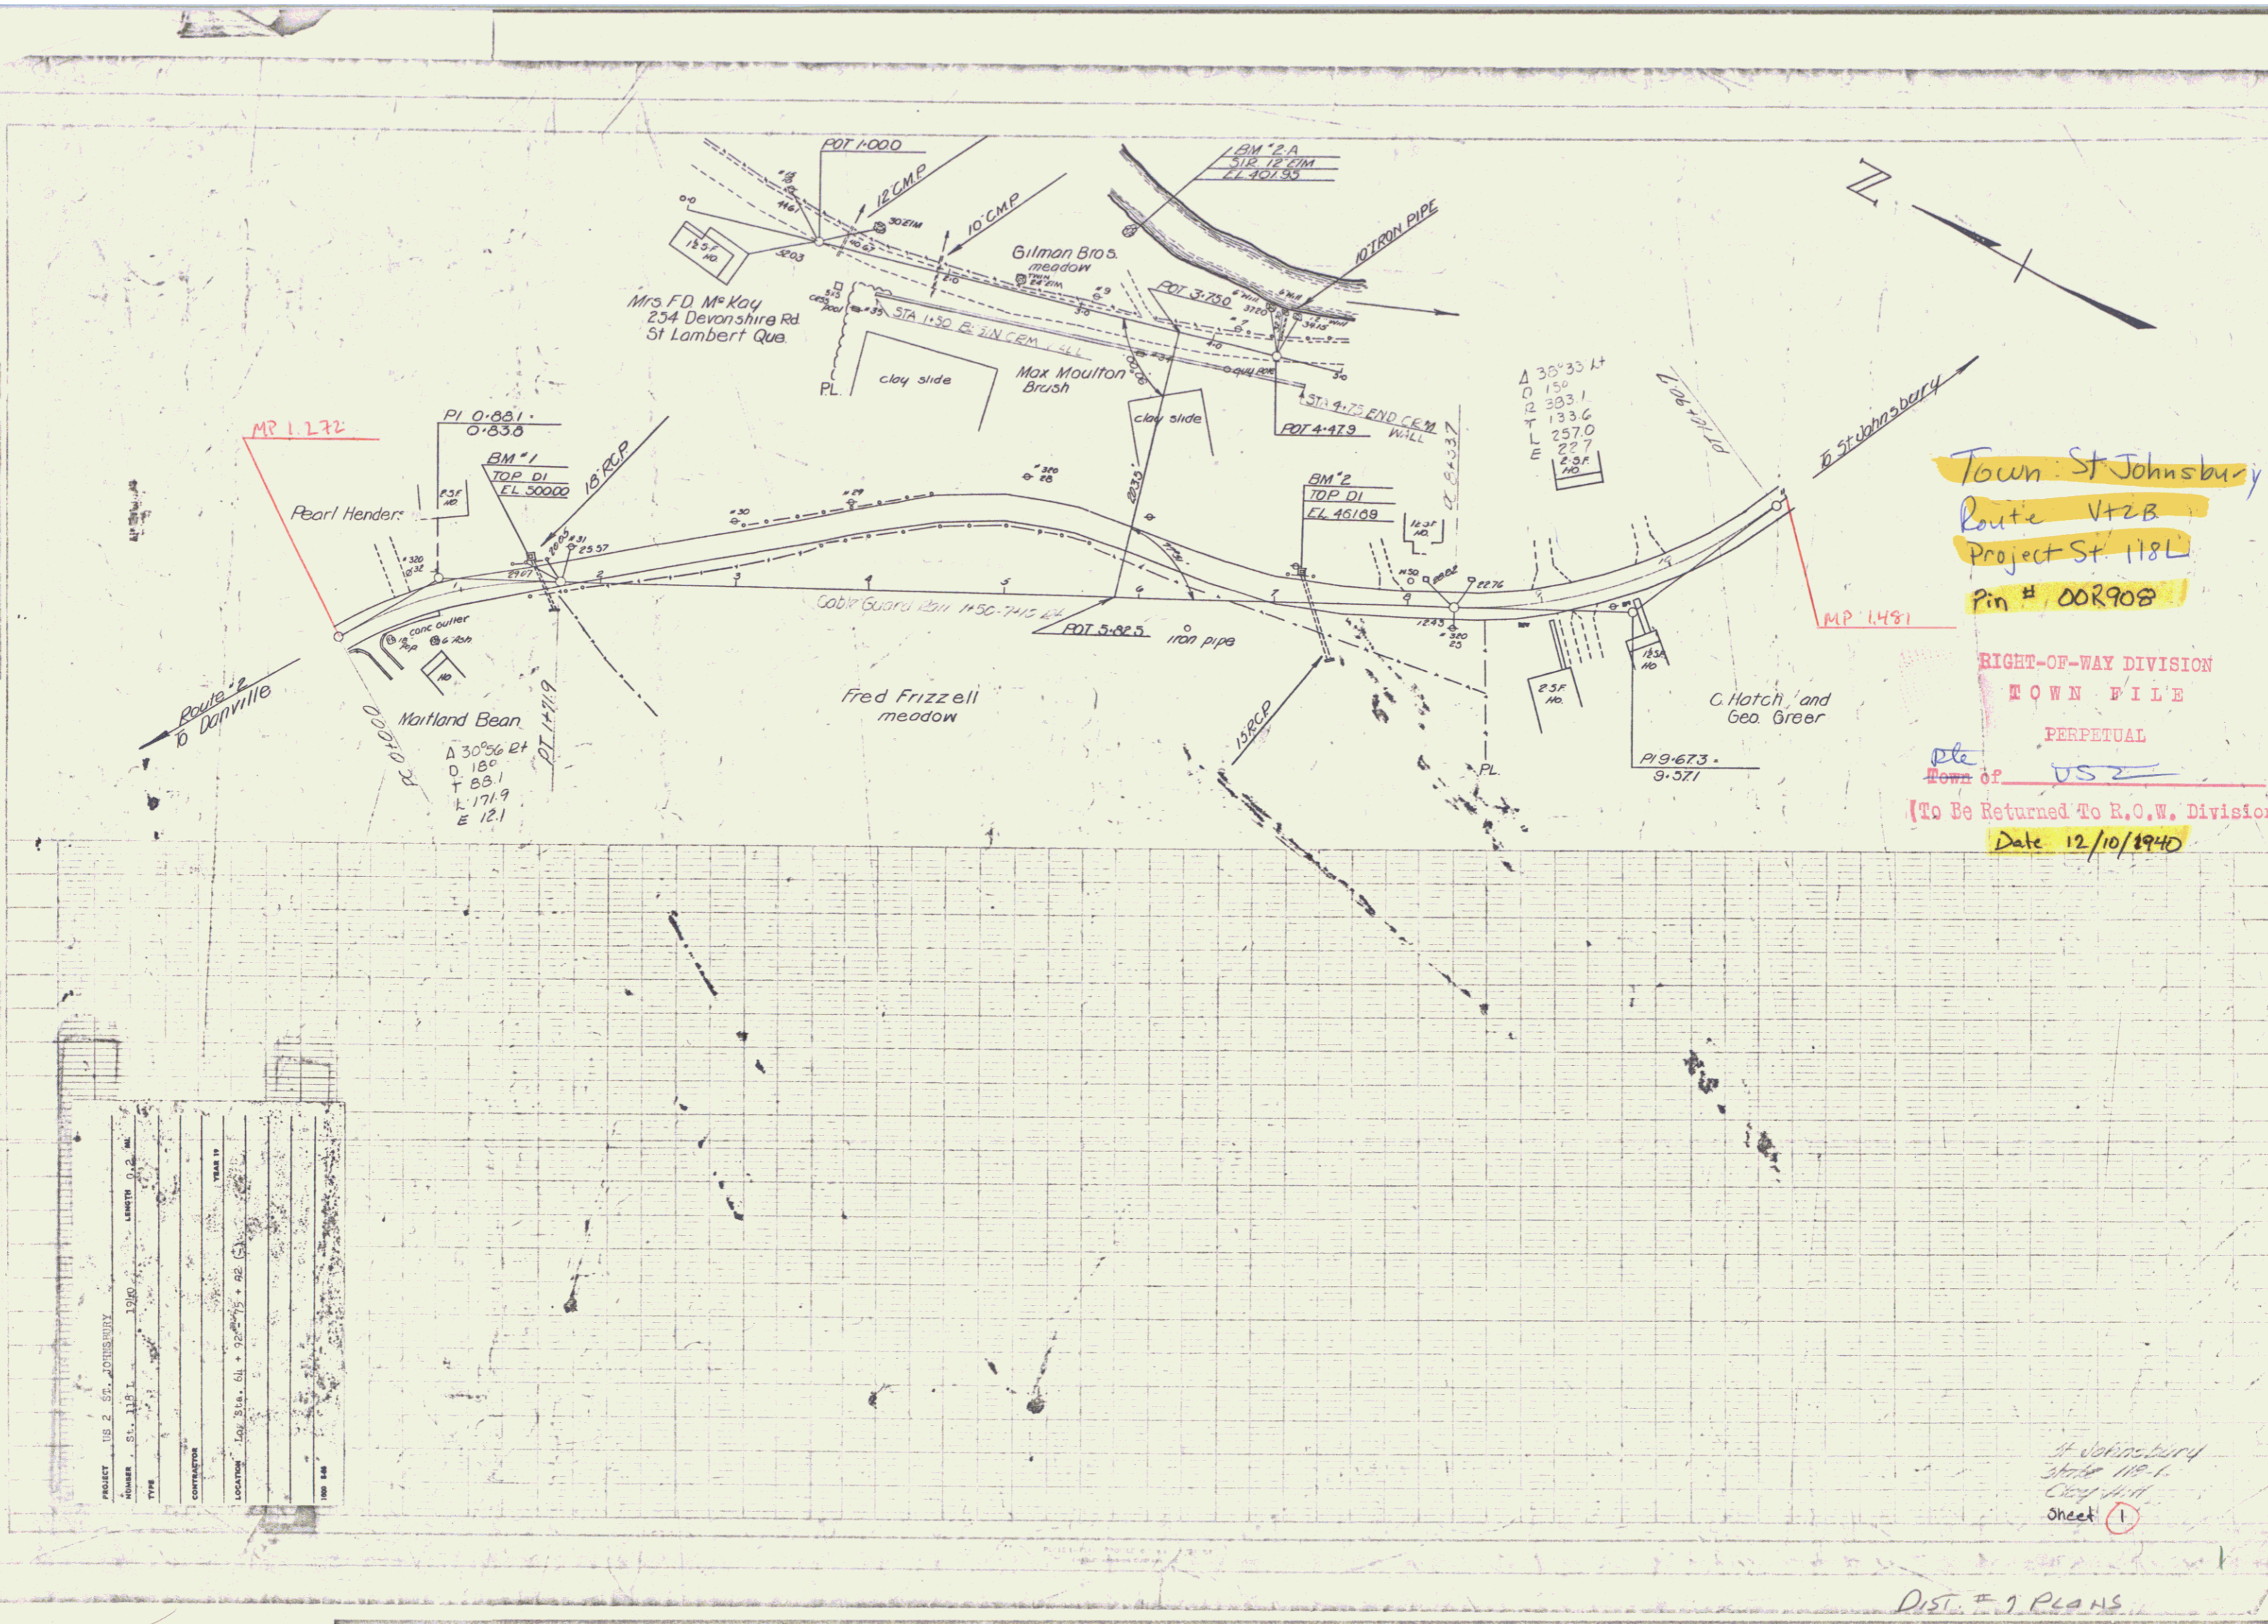

Town: St. Johnsbury  
 Route: Vt 2B  
 Project: St. 118L  
 Pin #: 008908

RIGHT-OF-WAY DIVISION  
 TOWN FILE  
 PERPETUAL  
 Town of St. Johnsbury  
 [To Be Returned To R.O.W. Division]  
 Date 12/10/1940

PROJECT	US 2 ST. JOHNSBURY
OWNER	ST. JOHNSBURY
DATE	12/10/1940
CONTRACTOR	LOCKPORT
LOCATION	1/2 M. S. E. COR. 118L
SCALE	1" = 100'

St. Johnsbury  
 Sheet 118-1  
 Copy 118L  
 Sheet 1

DIST. E. J. PLANS