
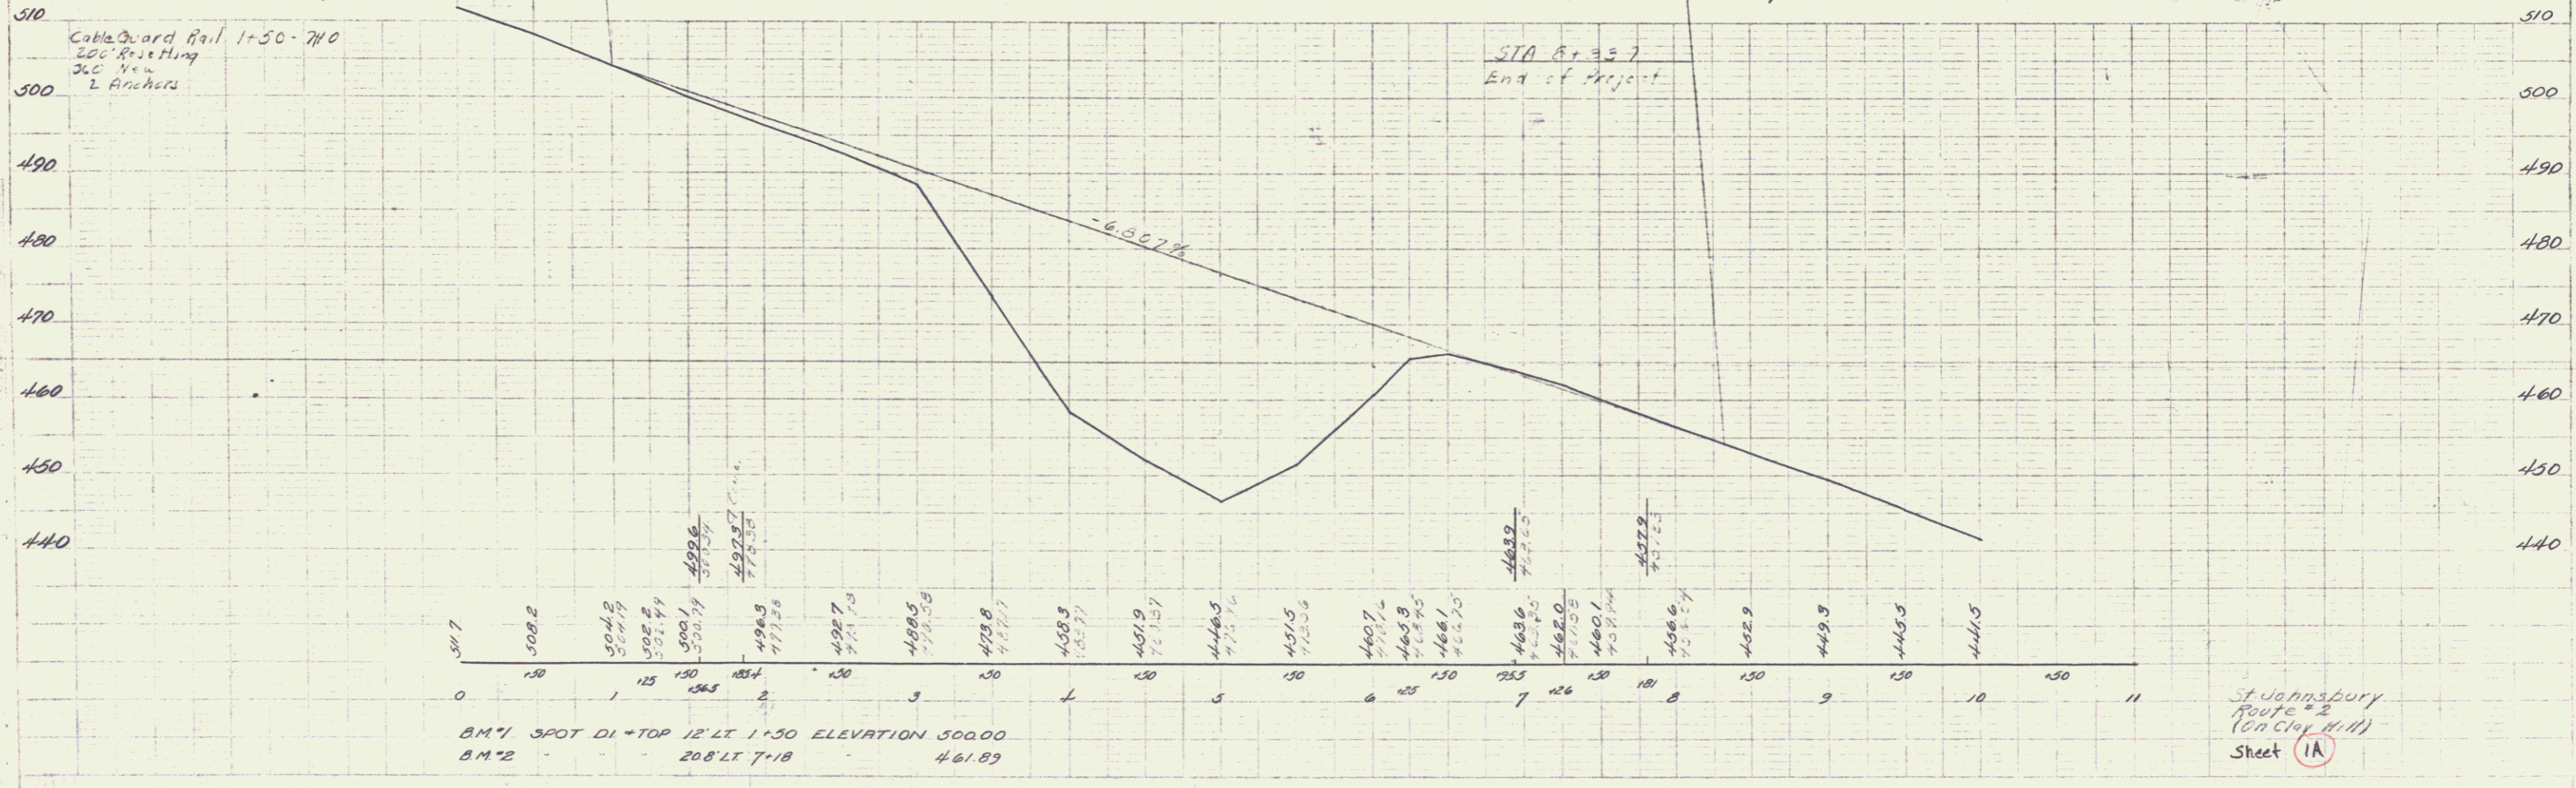


PARCEL	INSTRUMENT	DATE	GRANTOR	GRANTEE	RECORDED	REMARKS
A	W.D.O.E.	8-31-40	FRED FRIZZELL	ST JOHN BURY	ST OF VT	BOOK PAGE DATE
A'	A.V.D.O.E.	12-4-40	ANNIE McLEARN EIT	ST OF VT	83 332 8-3-40	
					83 426.7	12-10-40

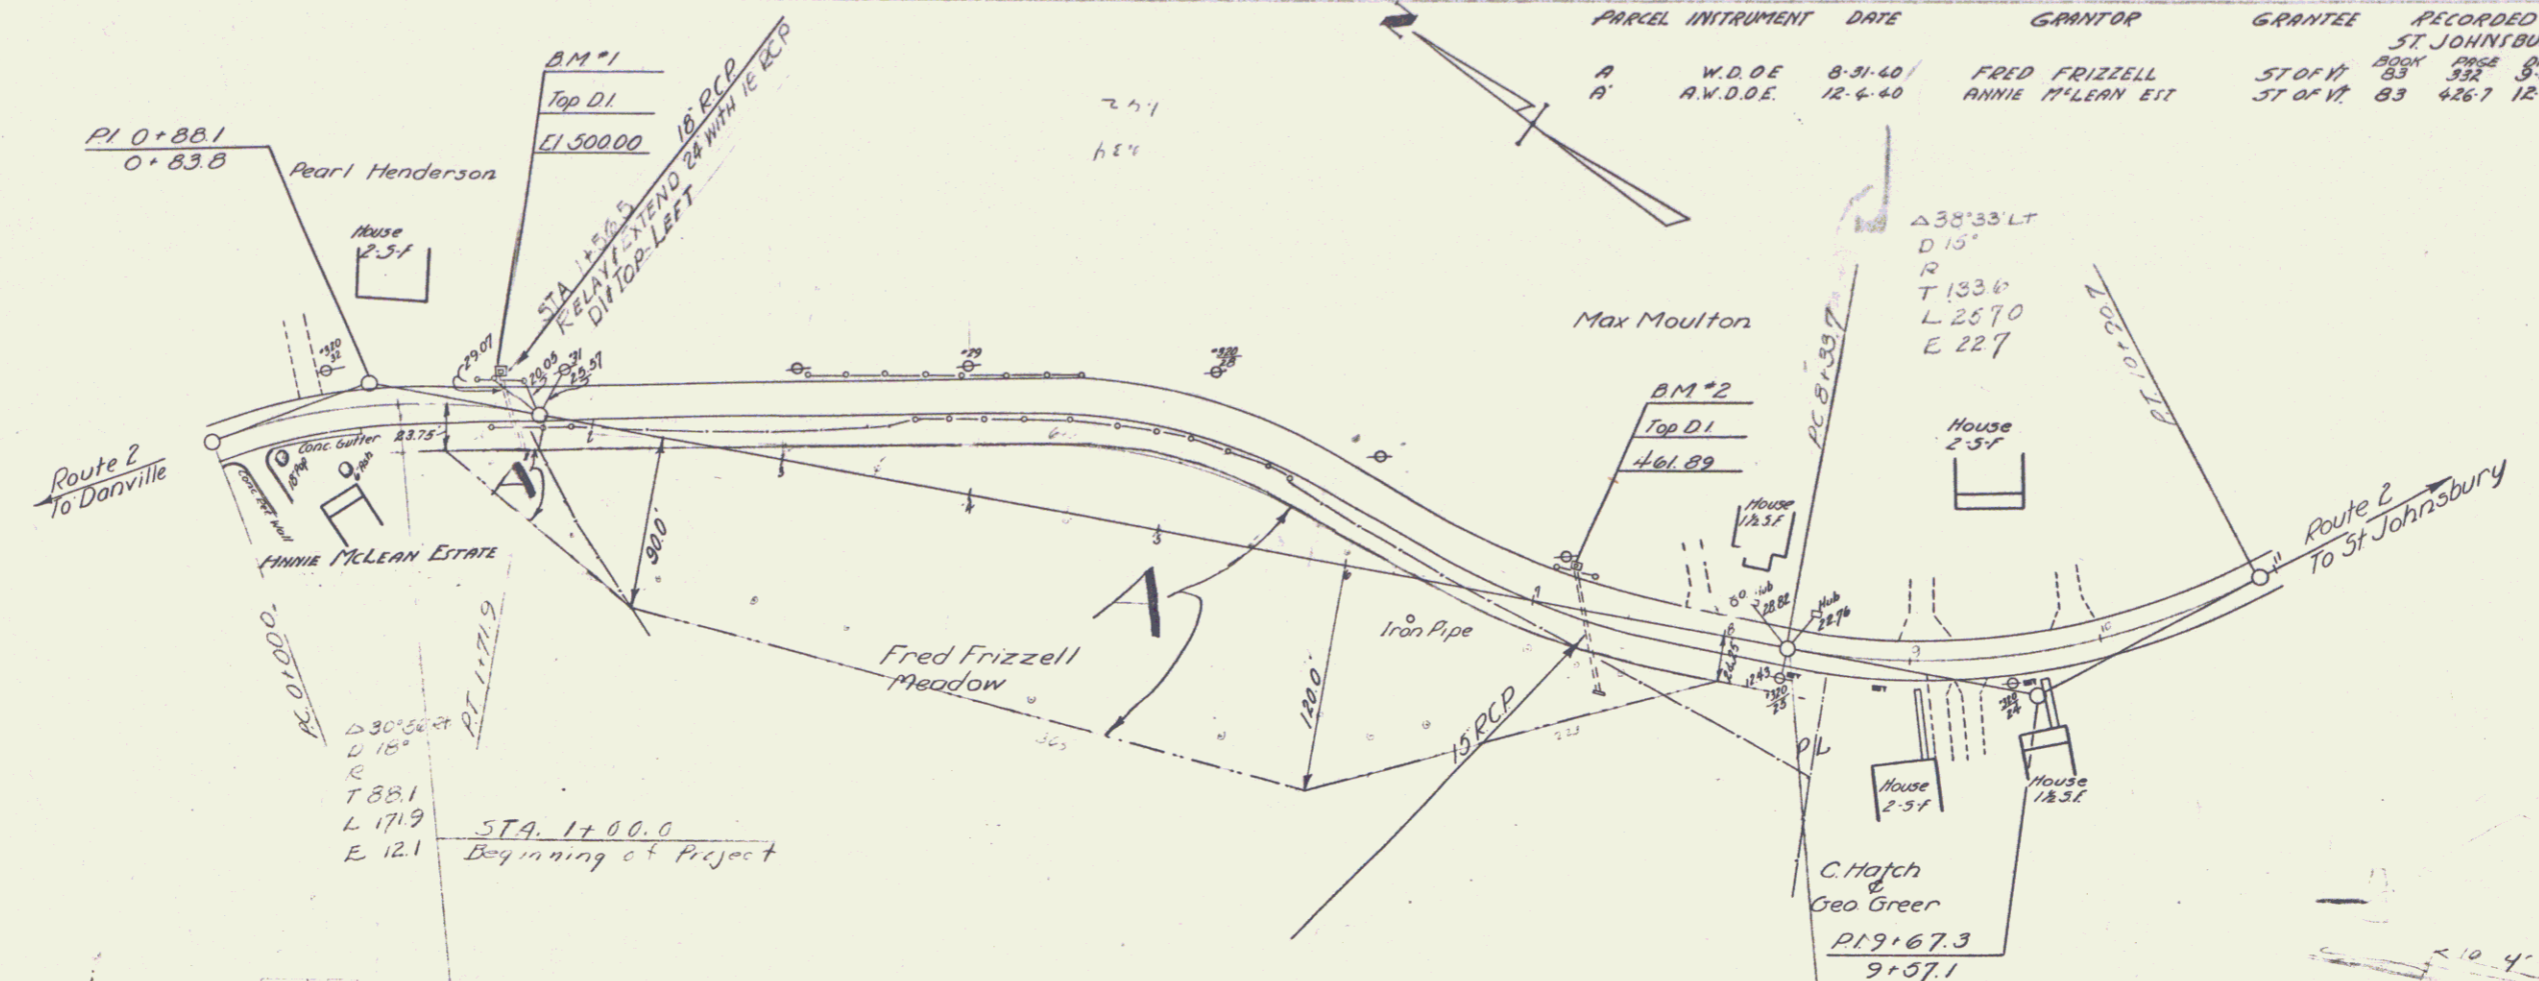

Lane Rogers
 May 40
 Traced Rogers

Lane Rogers
 Rogers

B.M.#1 SPOT DI + TOP 12' LT 1'50 ELEVATION 500.00
 B.M.#2 208' LT 7'18 461.89

St Johnsbury
 Route #2
 (on clay hill)
 Sheet 1A