


6-22-2011 LANE  
 PROJECT  
 SHEET NO.  
 DATE

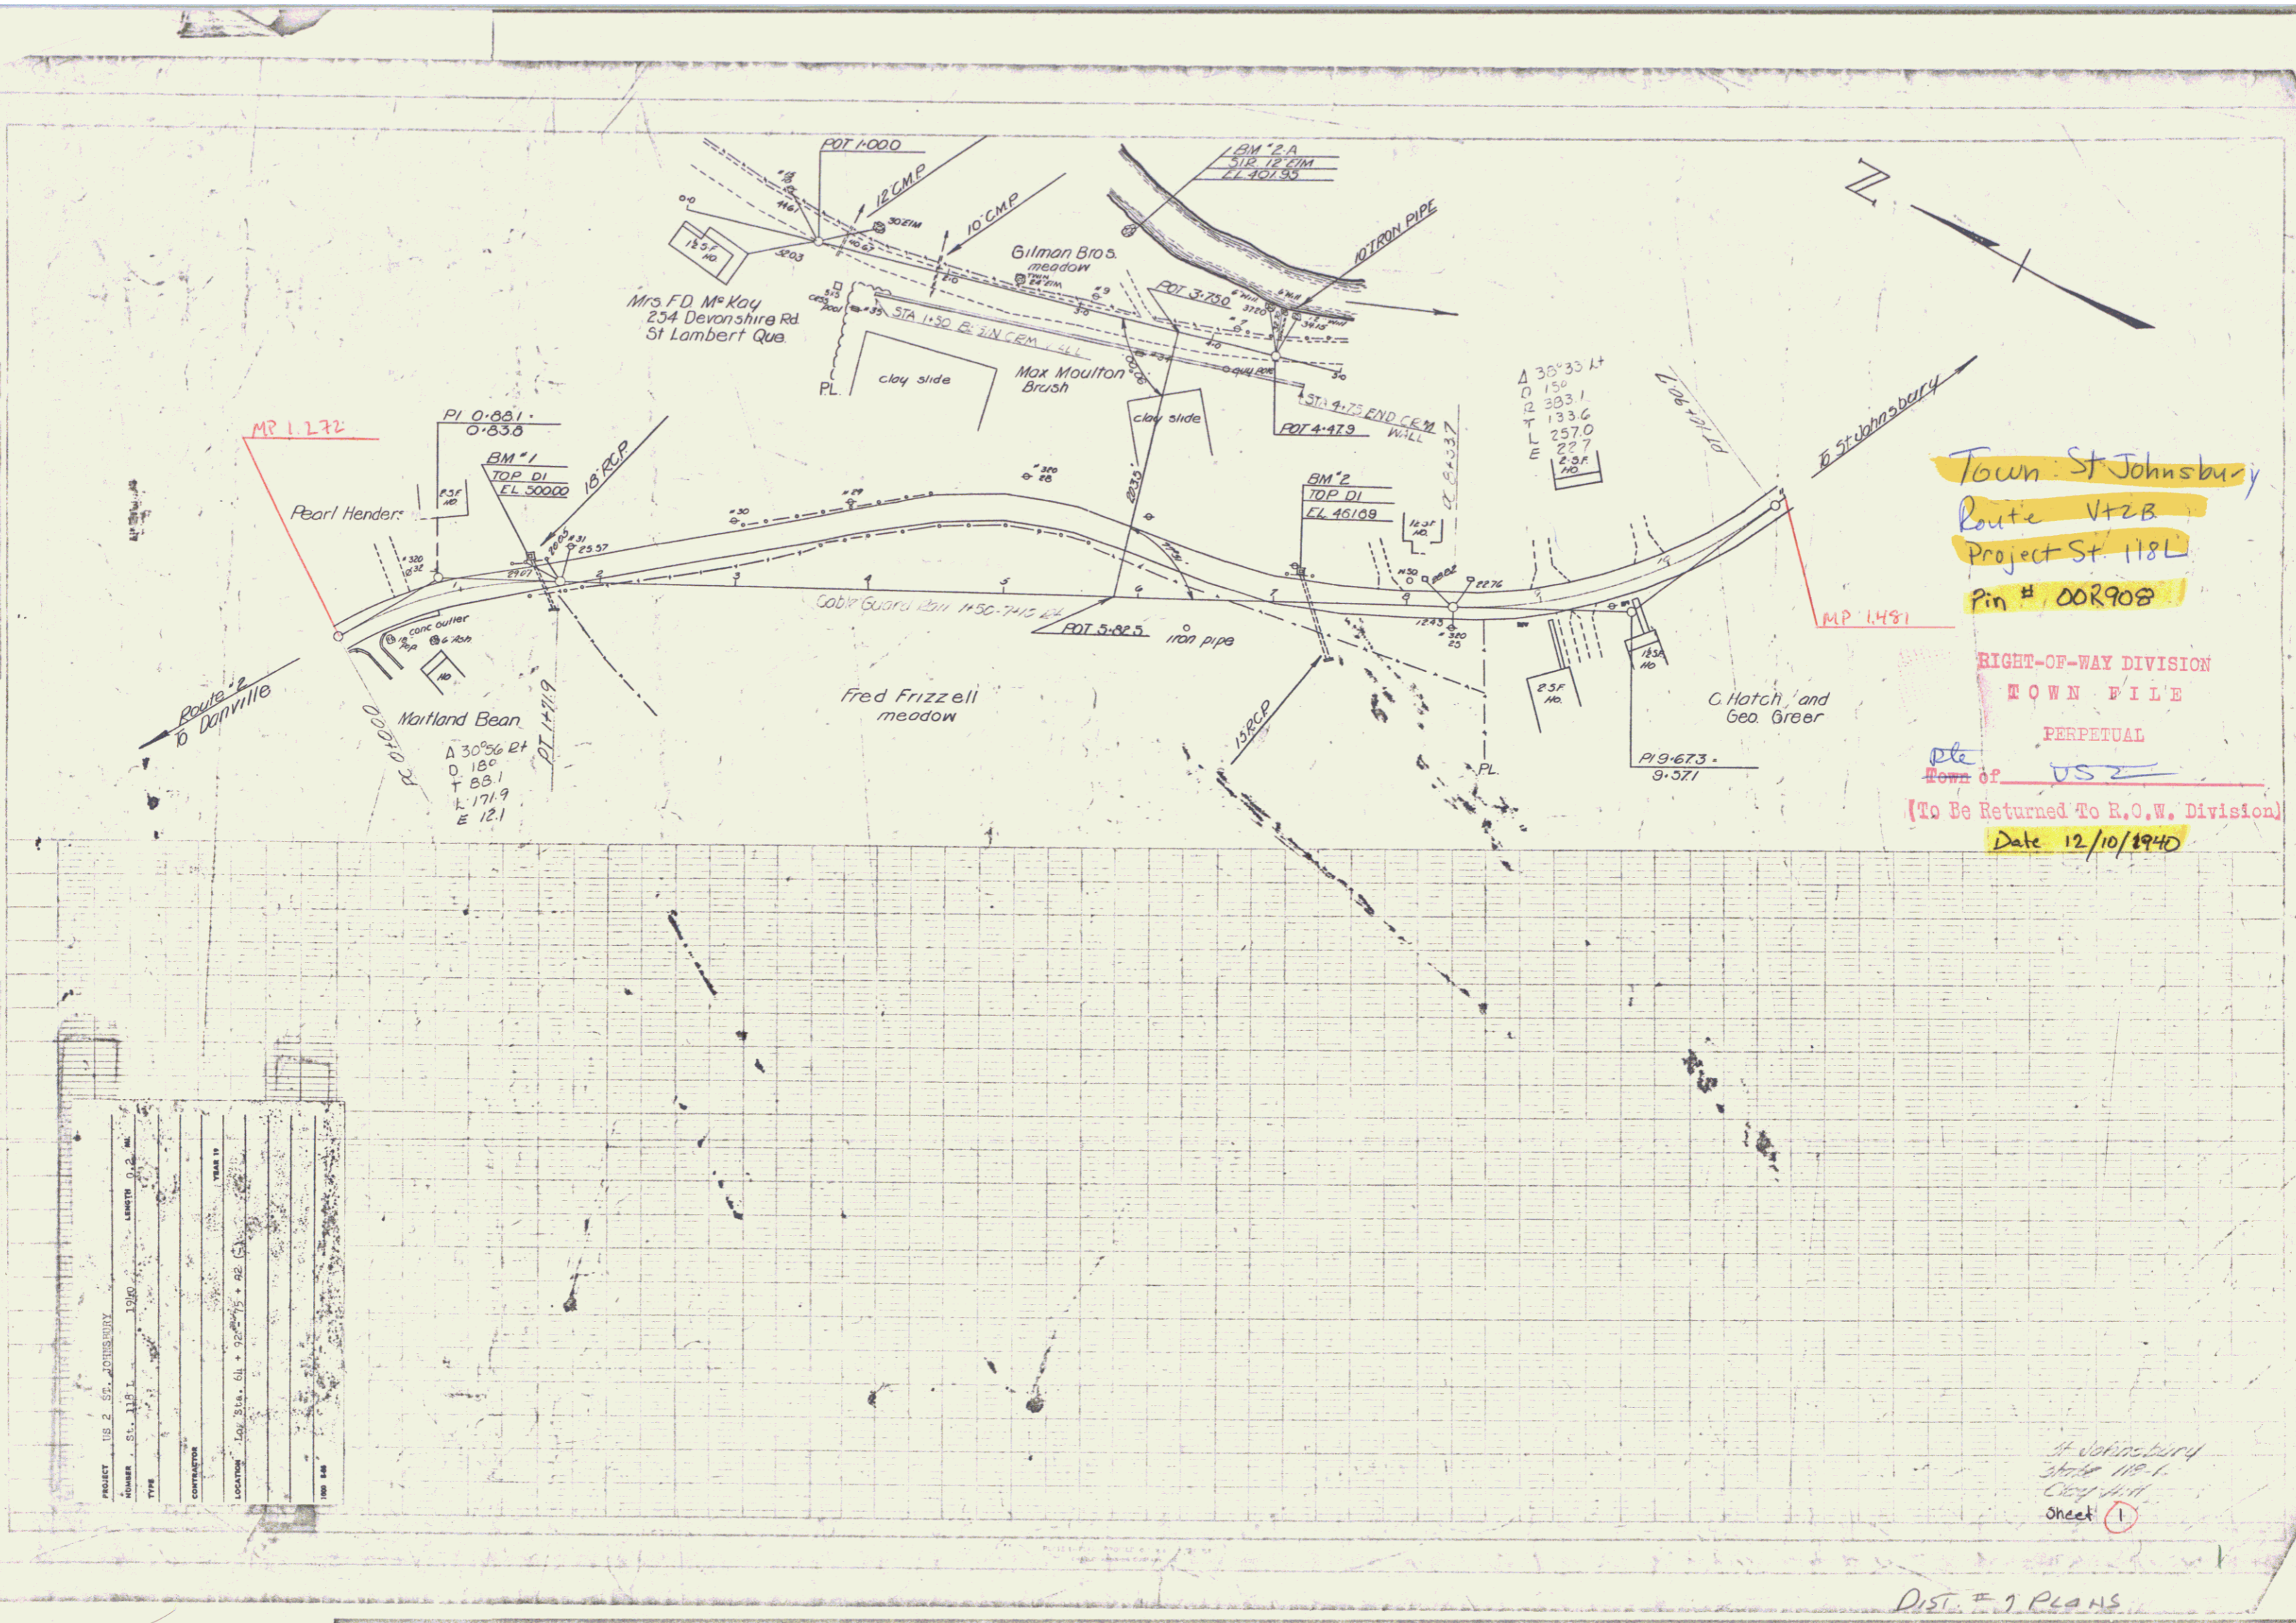

Town: St. Johnsbury  
 Route: Vt 2B  
 Project: St. 118L  
 Pin #: 008908


RIGHT-OF-WAY DIVISION  
 TOWN FILE  
 PERPETUAL  
 Town of St. Johnsbury  
 [To Be Returned To R.O.W. Division]  
 Date 12/10/1940

PROJECT	US 2 ST. JOHNSBURY
OWNER	ST. JOHNSBURY
DATE	1940
CONTRACTOR	
LOCATION	Map Sta. 611 + 722-75 + 82 (S)
SCALE	1" = 100'

St. Johnsbury  
 Sheet 118-1  
 Copy 1/11  
 Sheet 1

DIST. E. J. PLANS

PARCEL	INSTRUMENT	DATE	GRANTOR	GRANTEE	RECORDED	REMARKS
A	W.D.O.E.	8-31-40	FRED FRIZZELL	ST JOHN BURY	ST OF VT	BOOK PAGE DATE
A'	A.V.D.O.E.	12-4-40	ANNIE McLEARN EIT	ST OF VT	83 332 8-3-40	
					83 426.7	12-10-40

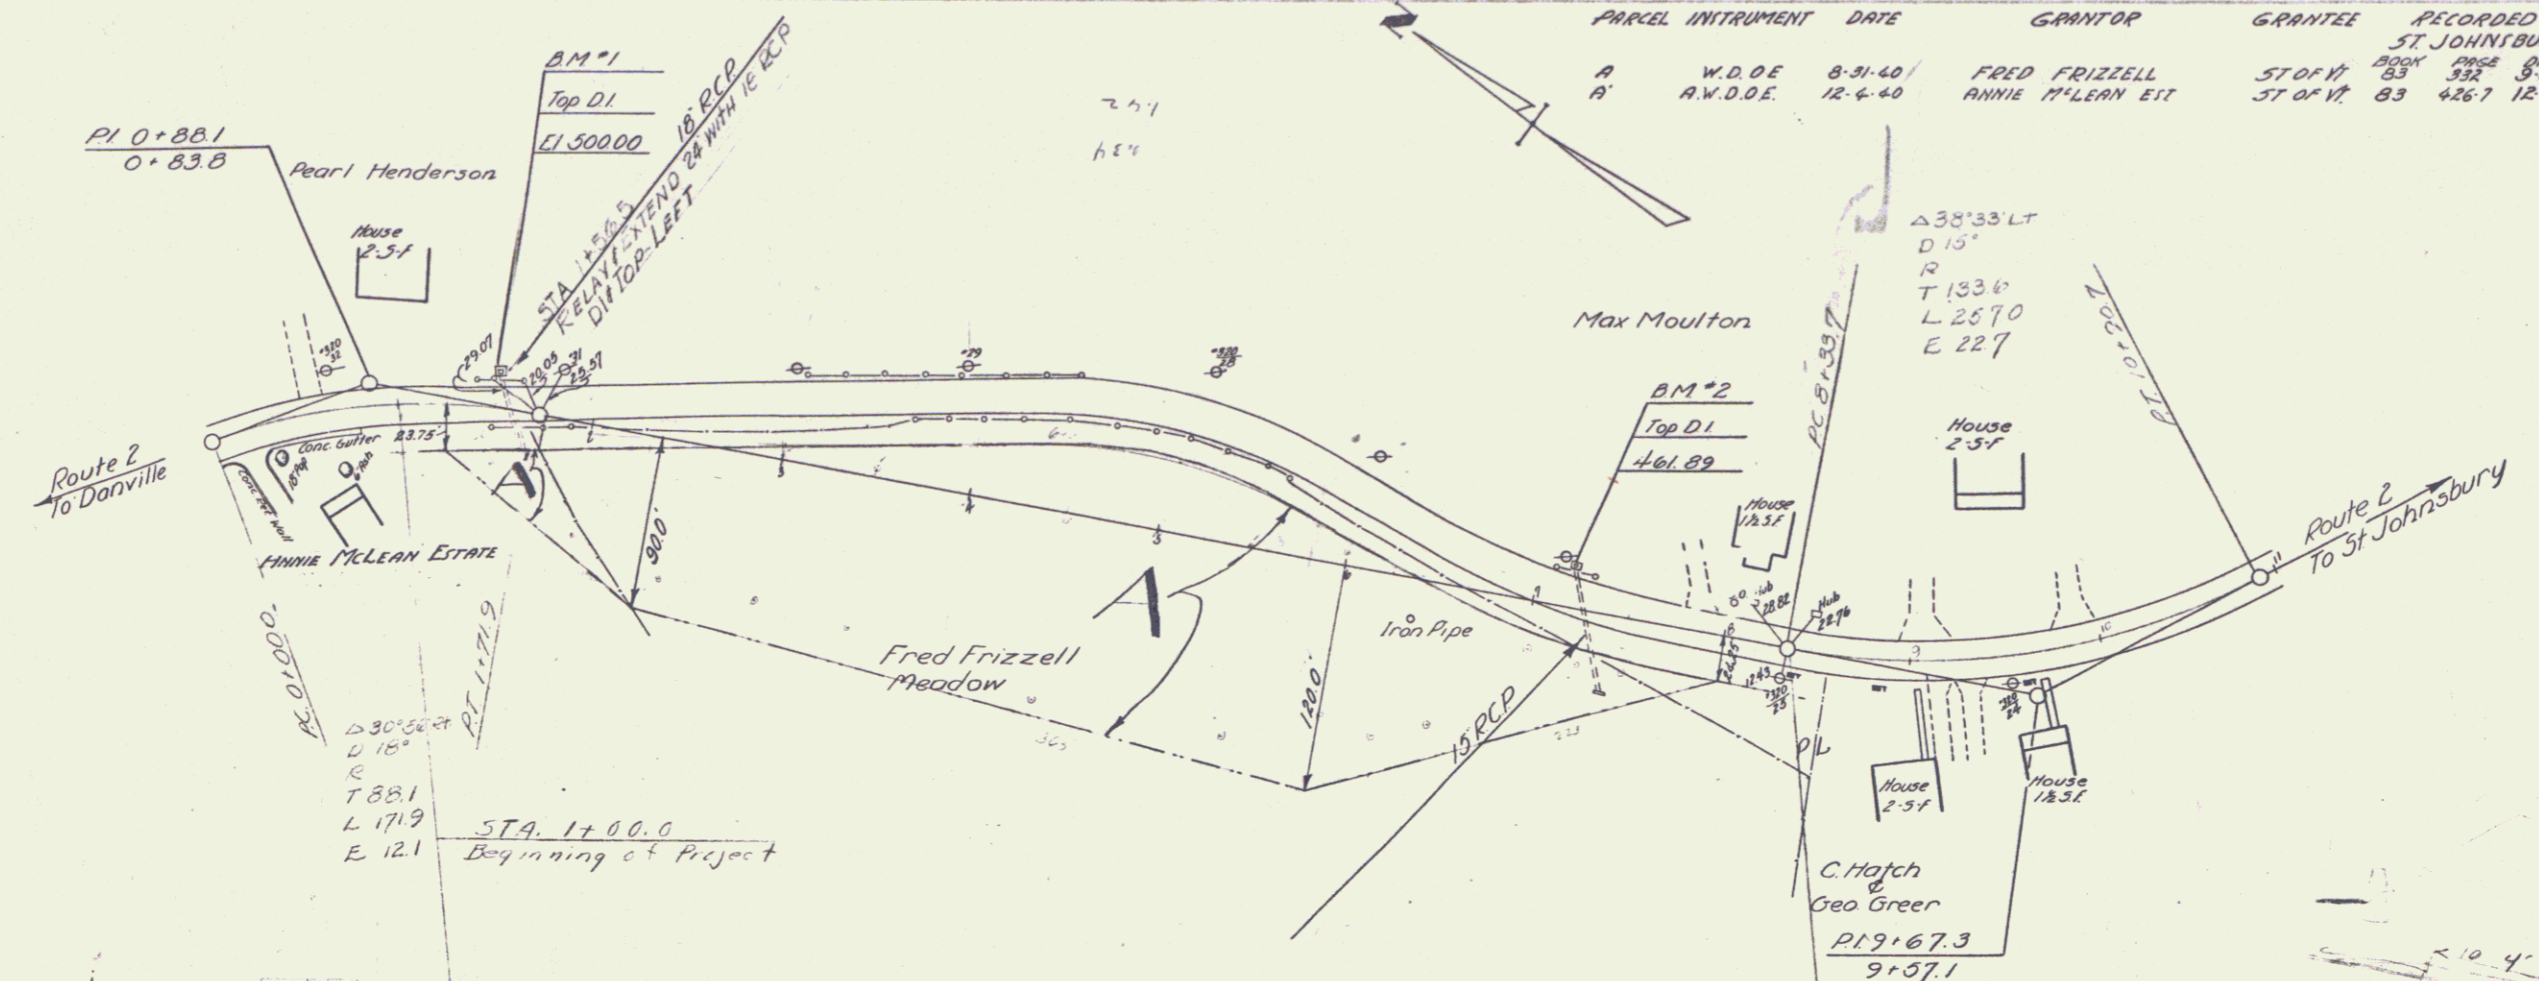

Lane Rogers  
 May 40  
 Traced Rogers

Lane Rogers  
 Rogers

B.M.#1 SPOT DI + TOP 12' LT 1' 50 ELEVATION 500.00  
 B.M.#2 208' LT 7-18 461.89