
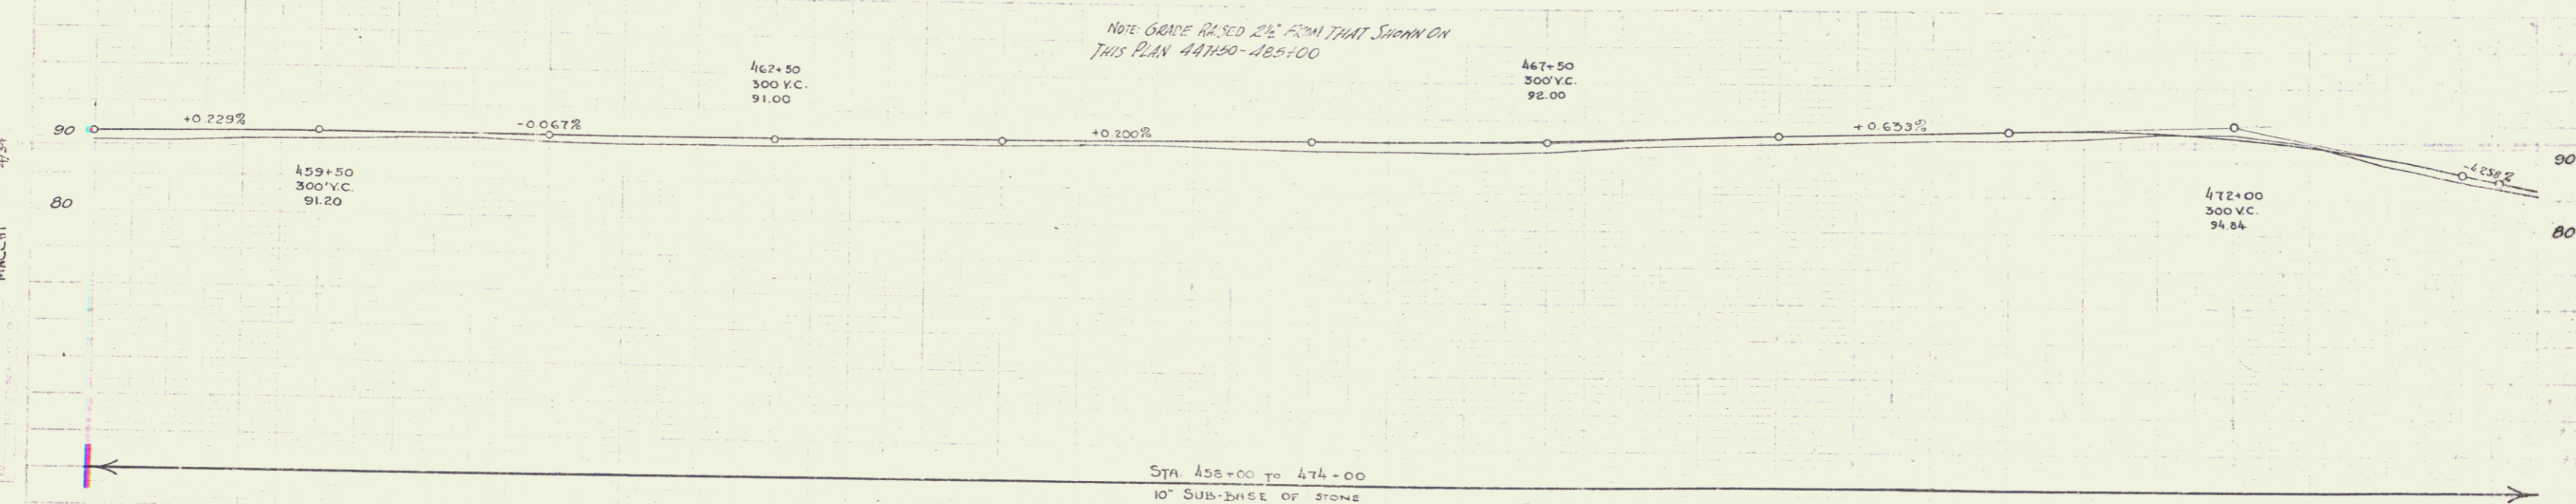


F.A.P. 128 B		
WOODGUIDE POSTS		
STA.	RT.	LT.
448+50	1	1

POOR ORIGINAL COPY

NO.	DATE	BY	REVISION
1	12/10/46	S	0

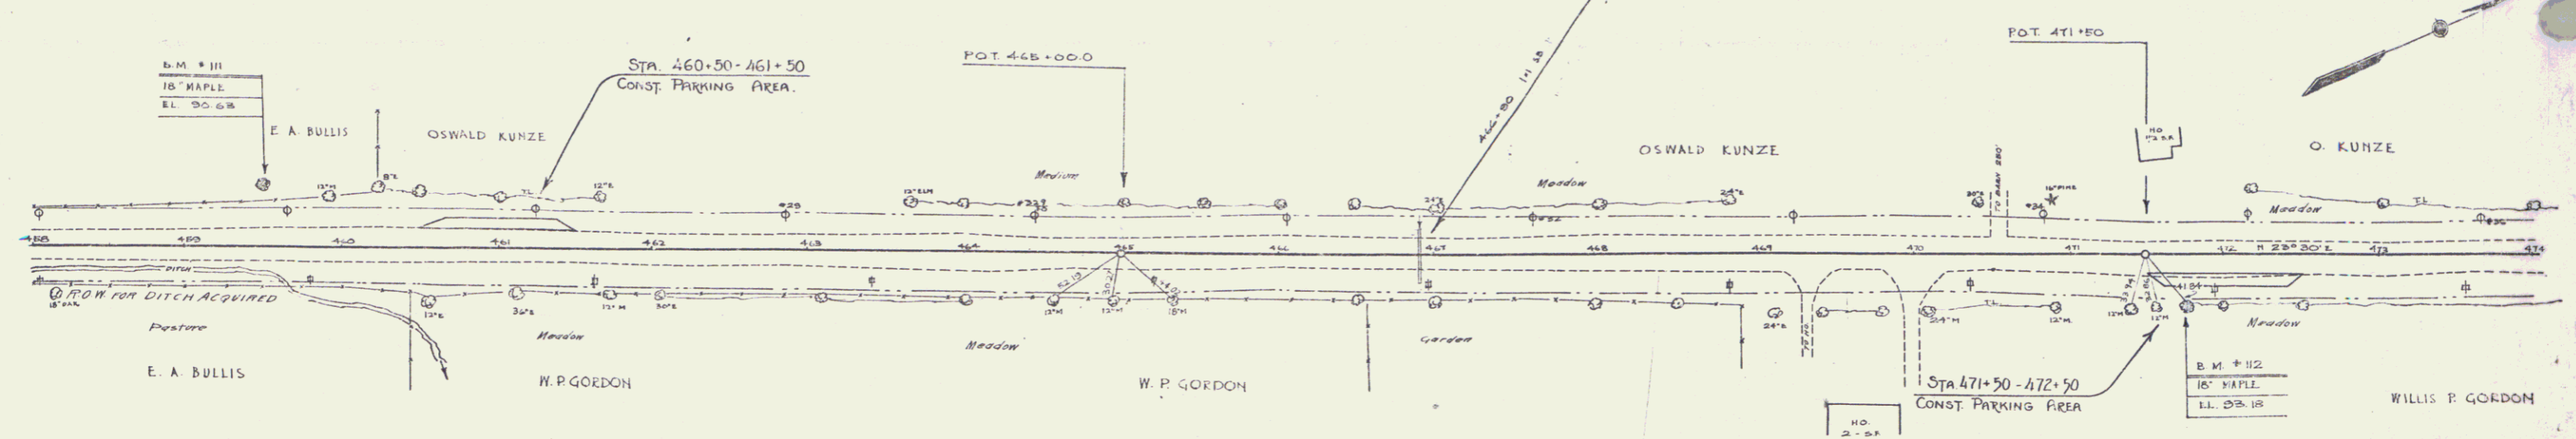

STA.	ELEVATION	STA.	ELEVATION	STA.	ELEVATION	STA.	ELEVATION	STA.	ELEVATION	STA.	ELEVATION	STA.	ELEVATION	STA.	ELEVATION	STA.	ELEVATION
458	90.86	461	91.07	464	91.30	467	91.57	470	91.90	473	92.30	476	92.75	479	93.24	482	93.78
459	90.96	462	91.10	465	91.50	468	91.85	471	92.30	474	92.75	477	93.15	480	93.60	483	94.05
460	91.04	463	91.14	466	91.45	469	91.80	472	92.25	475	92.70	478	93.15	481	93.60	484	94.05
461	91.09	464	91.21	467	91.55	470	91.95	473	92.40	476	92.85	479	93.30	482	93.75	485	94.20
462	91.12	465	91.40	468	91.75	471	92.20	474	92.65	477	93.10	480	93.55	483	94.00	486	94.45
463	91.18	466	91.45	469	91.80	472	92.25	475	92.70	478	93.15	481	93.60	484	94.05	487	94.50
464	91.25	467	91.55	470	91.95	473	92.40	476	92.85	479	93.30	482	93.75	485	94.20	488	94.65
465	91.30	468	91.70	471	92.15	474	92.60	477	93.05	480	93.50	483	93.95	486	94.40	489	94.85
466	91.35	469	91.75	472	92.20	475	92.65	478	93.10	481	93.55	484	94.00	487	94.45	490	94.90
467	91.40	470	91.80	473	92.25	476	92.70	479	93.15	482	93.60	485	94.05	488	94.50	491	94.95
525	94.30	528	94.70	531	95.15	534	95.60	537	96.05	540	96.50	543	96.95	546	97.40	549	97.85
526	94.35	529	94.75	532	95.20	535	95.65	5									