


FAP 128 B			
Wood Curved Box			
Station	Station	LT	RT
476+25	477+75	176	177
476+50	477+25	176	177


F.A.P.			
Station	Station	LT	RT
476+25	477+75	176	177
476+50	477+25	176	177

D. MACCHI
 4/17/34

D. MACCHI
 4/17/34

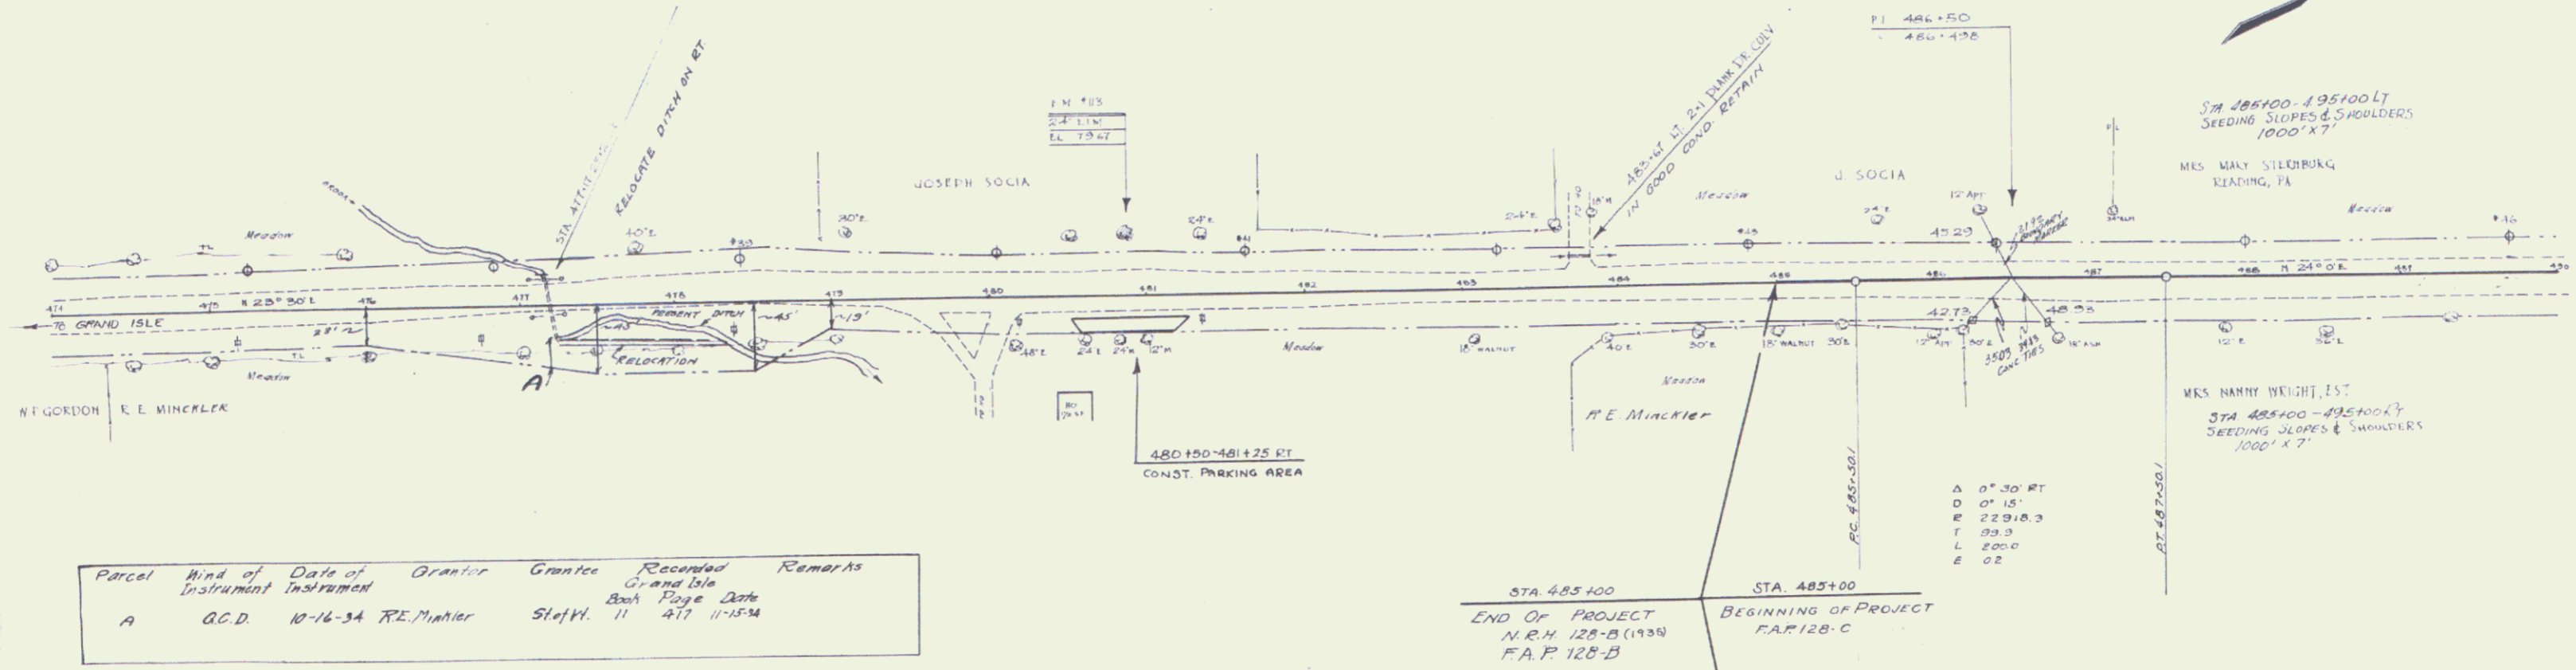

Parcel	Kind of Instrument	Date of Instrument	Grantor	Grantee	Recorded	Remarks
A	G.C.D.	10-16-34	RE Minckler	Stef W.	11 477 11-15-34	

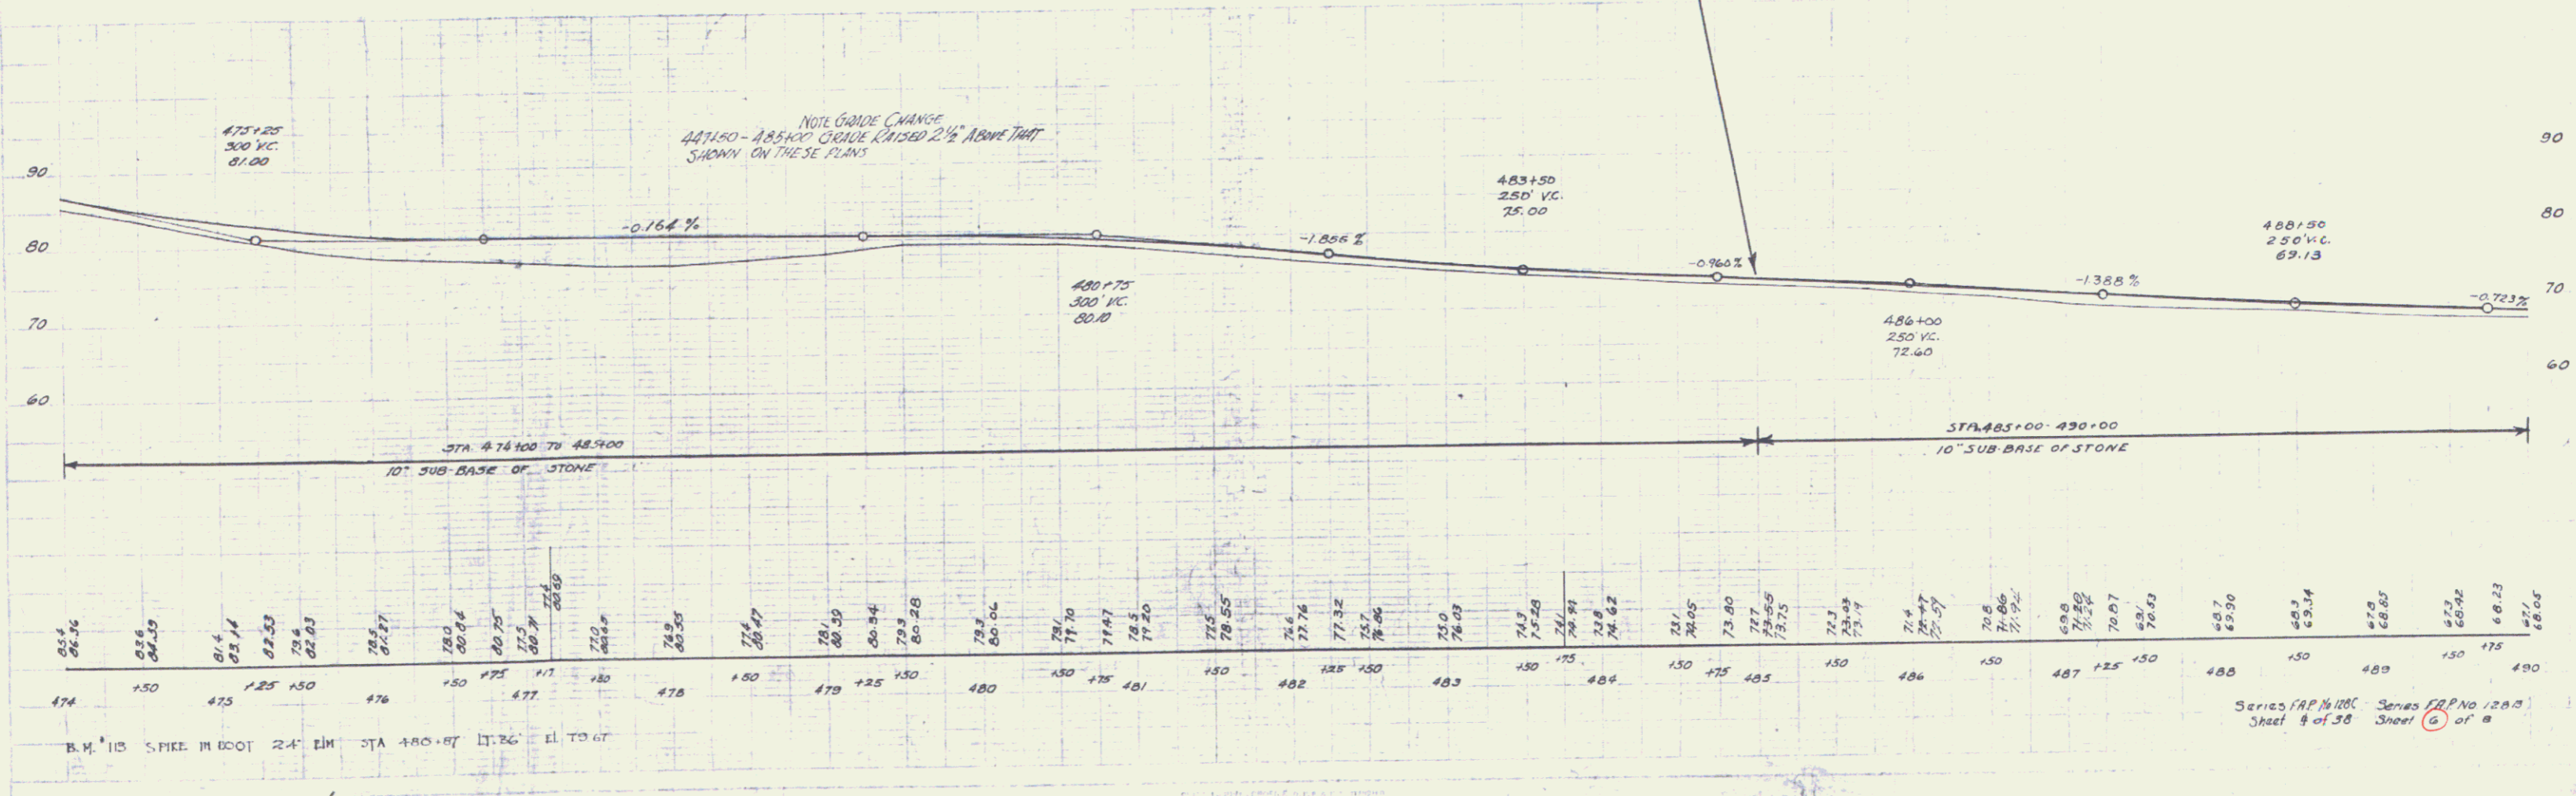

B.M. 115 S. PINE H. DOTT 24' ELM STA 480+87 H. 26' EL 73.67

Series FAP 128 B Series F.P. NO. 128 B
 Sheet 4 of 38 Sheet 6 of 8

4