


FAF 128 B			
1000' CURVED ROAD			
STATION	WIDTH	LT	RT
476+00	20.00	21.7	21.7
478+00	20.00	21.7	21.7


F.A.P.			
FAF 128 B 1436 G			
STATION	WIDTH	LT	RT
476+00	20.00	21.7	21.7
478+00	20.00	21.7	21.7

POOR ORIGINAL COPY

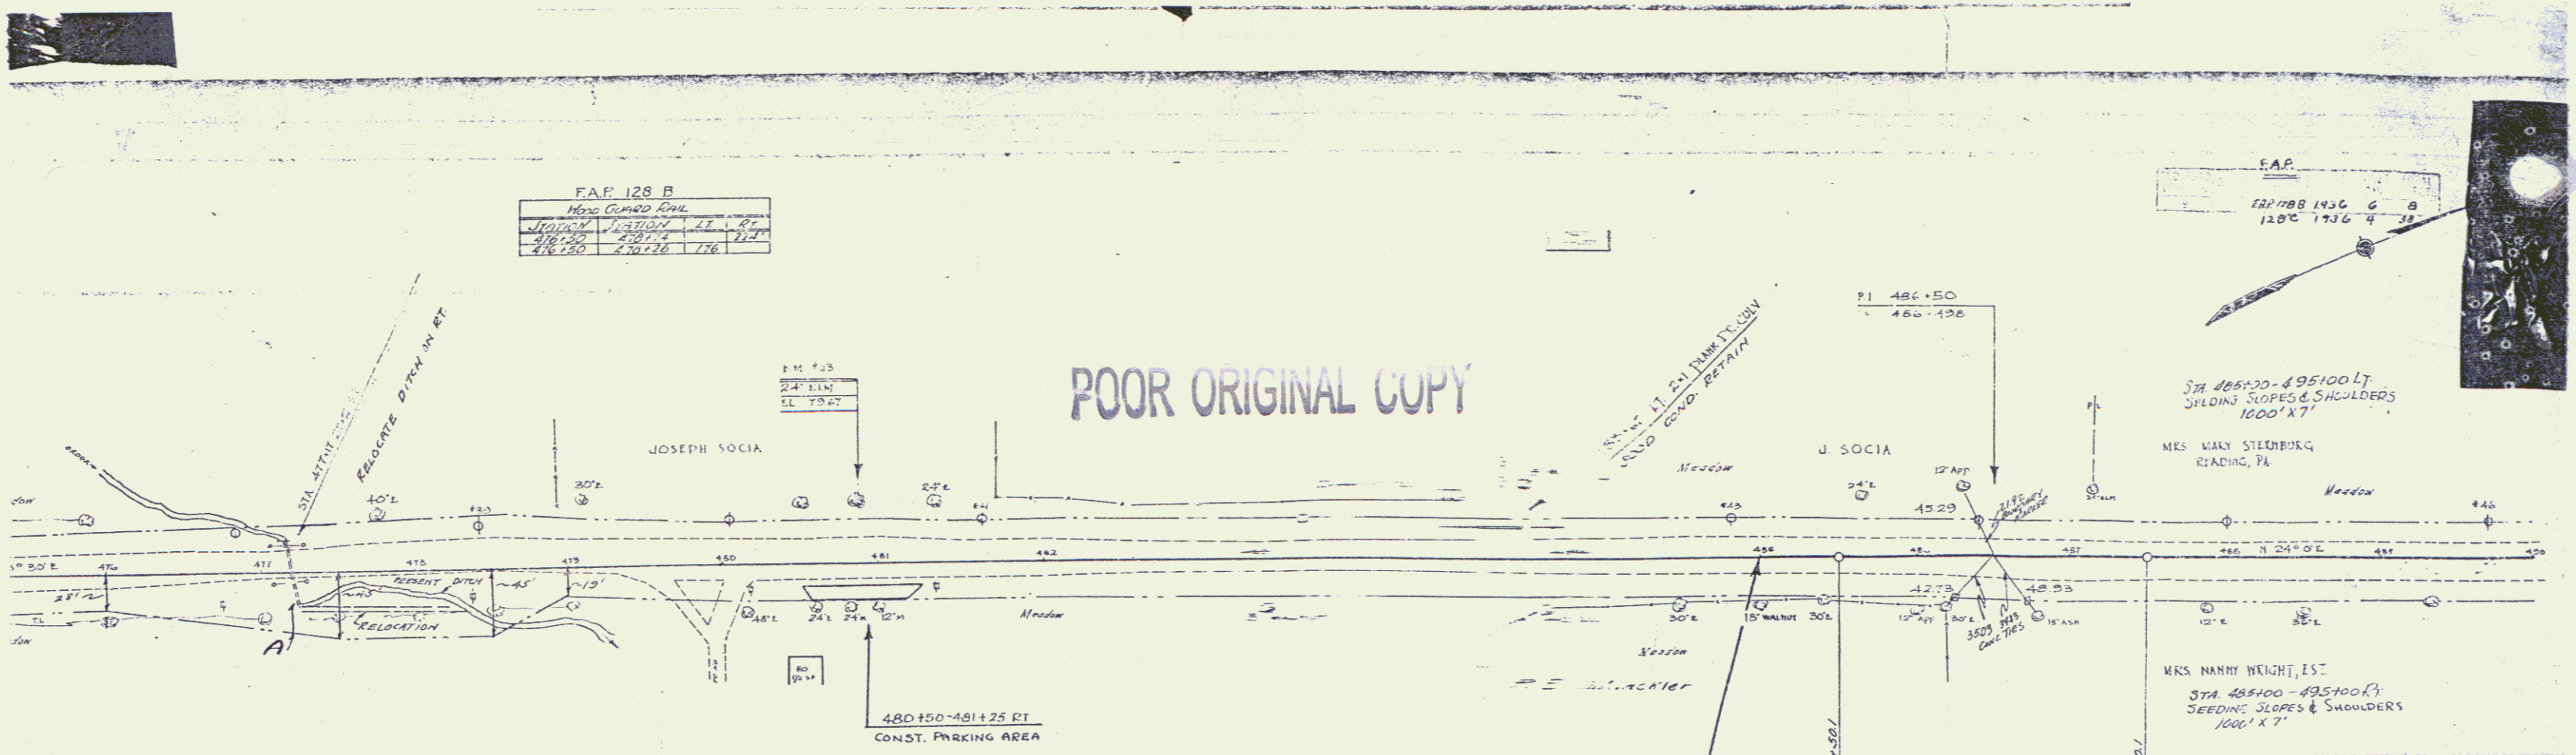

Date of Instrument	Grantor	Grantee	Recorded Grant No.	Remarks
10-16-34	RE. Munkler	Slaf. W. H.	417	11-15-34

NOTE GRADE CHANGES
447+00 - 485+00 SHOULD RAISED 2 1/2" ABOVE THAT SHOWN ON THESE PLANS

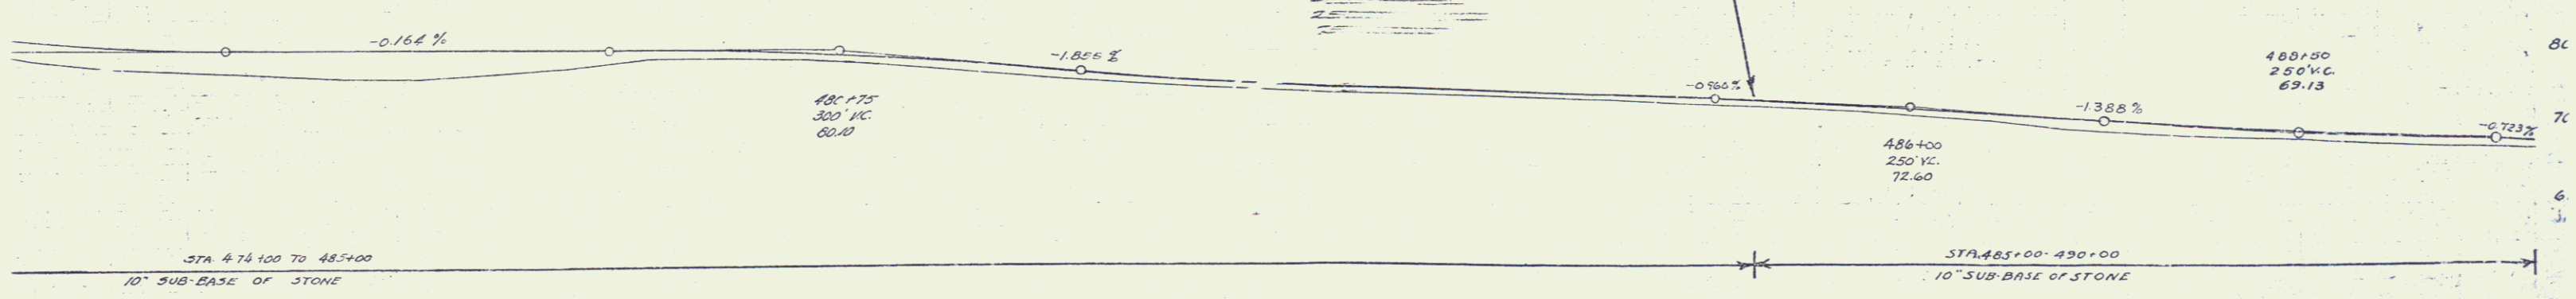

Station	Grade (%)	Vertical Curve Data
476+00	-0.164	
480+75	-0.164	300' VC, 60.10
486+00	-1.856	300' VC, 72.60
486+00	-0.960	250' VC, 72.60
490+00	-1.388	