


POOR ORIGINAL COPY

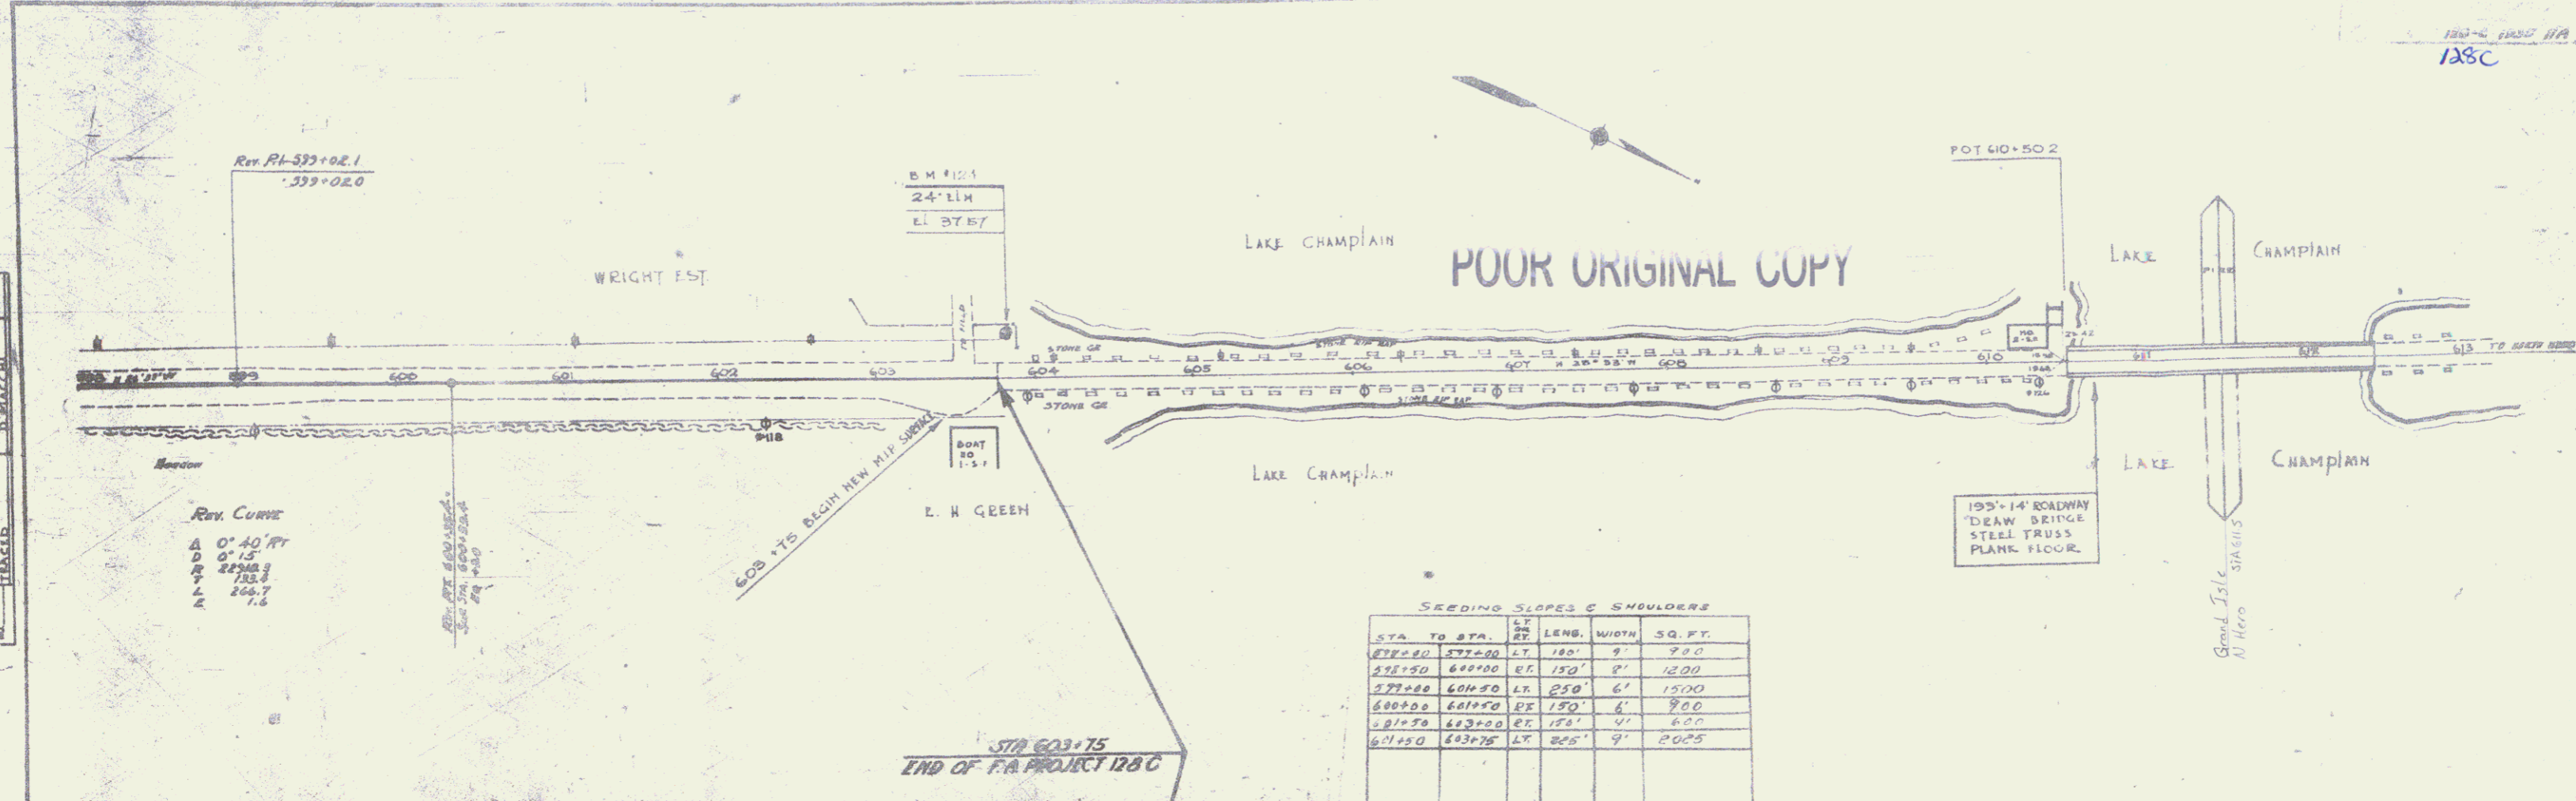

SEEDING SLOPES & SHOULDER

STA. TO STA.	LT./RT.	LENG.	WIDTH	SQ. FT.
572+50	LT.	180'	9'	700
572+50	RT.	150'	8'	1200
572+50	LT.	250'	6'	1500
600+00	RT.	150'	6'	700
601+50	RT.	150'	4'	600
601+50	LT.	265'	9'	2025

PLAN

DATE	12/17/77
BY	J. S. BROWN
CHECKED BY	J. S. BROWN
SCALE	AS SHOWN
PROJECT NO.	128C
DATE	12/17/77
BY	J. S. BROWN
CHECKED BY	J. S. BROWN
SCALE	AS SHOWN
PROJECT NO.	128C

11A

12