



PLAN	DATE	BY
PROJECT		
SCALE		
BY		

PROFILE	DATE	BY
PROJECT		
SCALE		
BY		

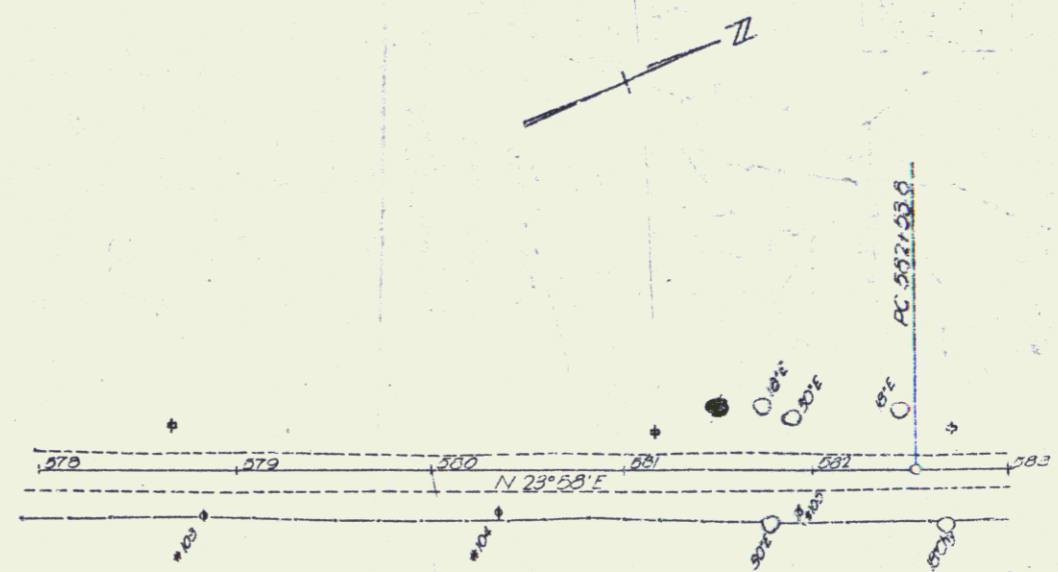

WRIGHT EST
See Jas. Landusky Est.

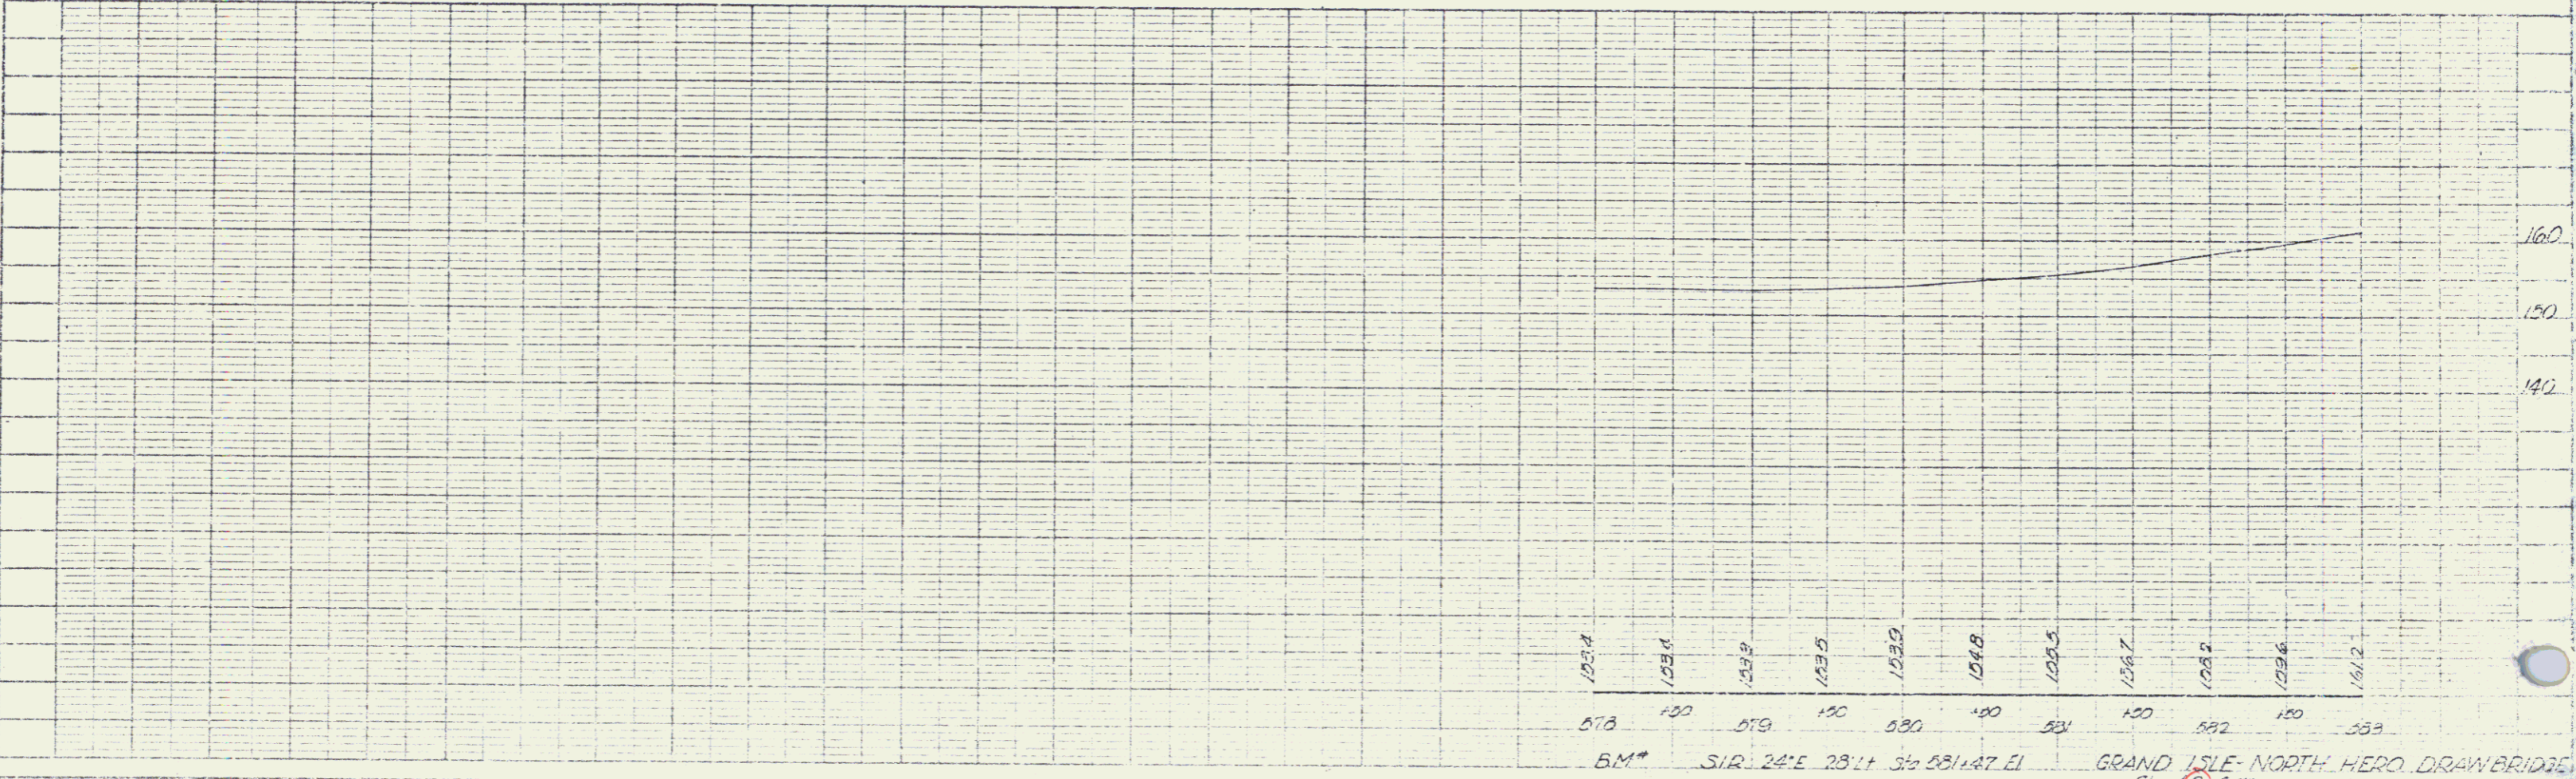

12314
12315
12316
578 579 580 581 582 583

BM# S1R 24°E 28'14 3/4 581.47 EI GRAND ISLE-NORTH HERO DRAW BRIDGE
Slope 1/2%