
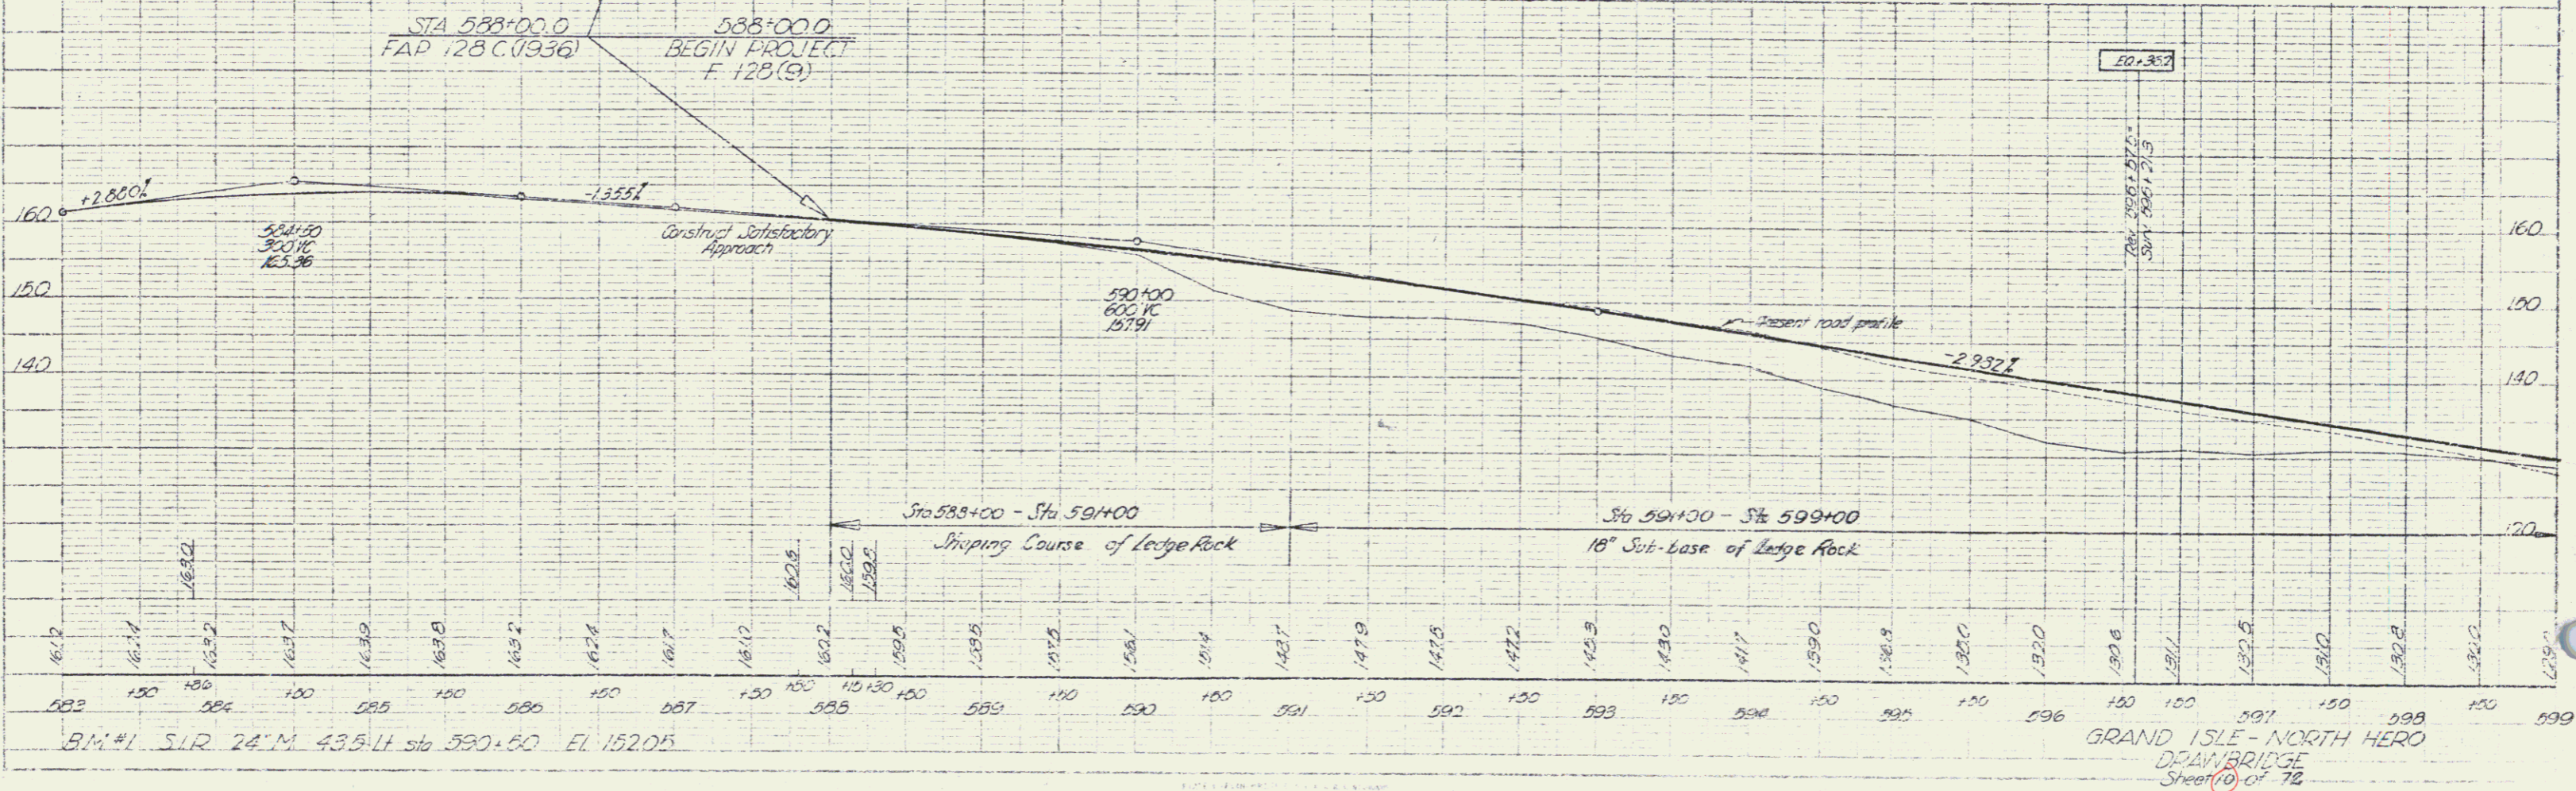


PLAN	DATE	BY	CHKD
5/28/50	5/28/50	J. L. ...	J. L. ...
REVISED	DATE	BY	CHKD

SECTION	DATE	BY	CHKD
10	5/28/50	J. L. ...	J. L. ...
REVISED	DATE	BY	CHKD

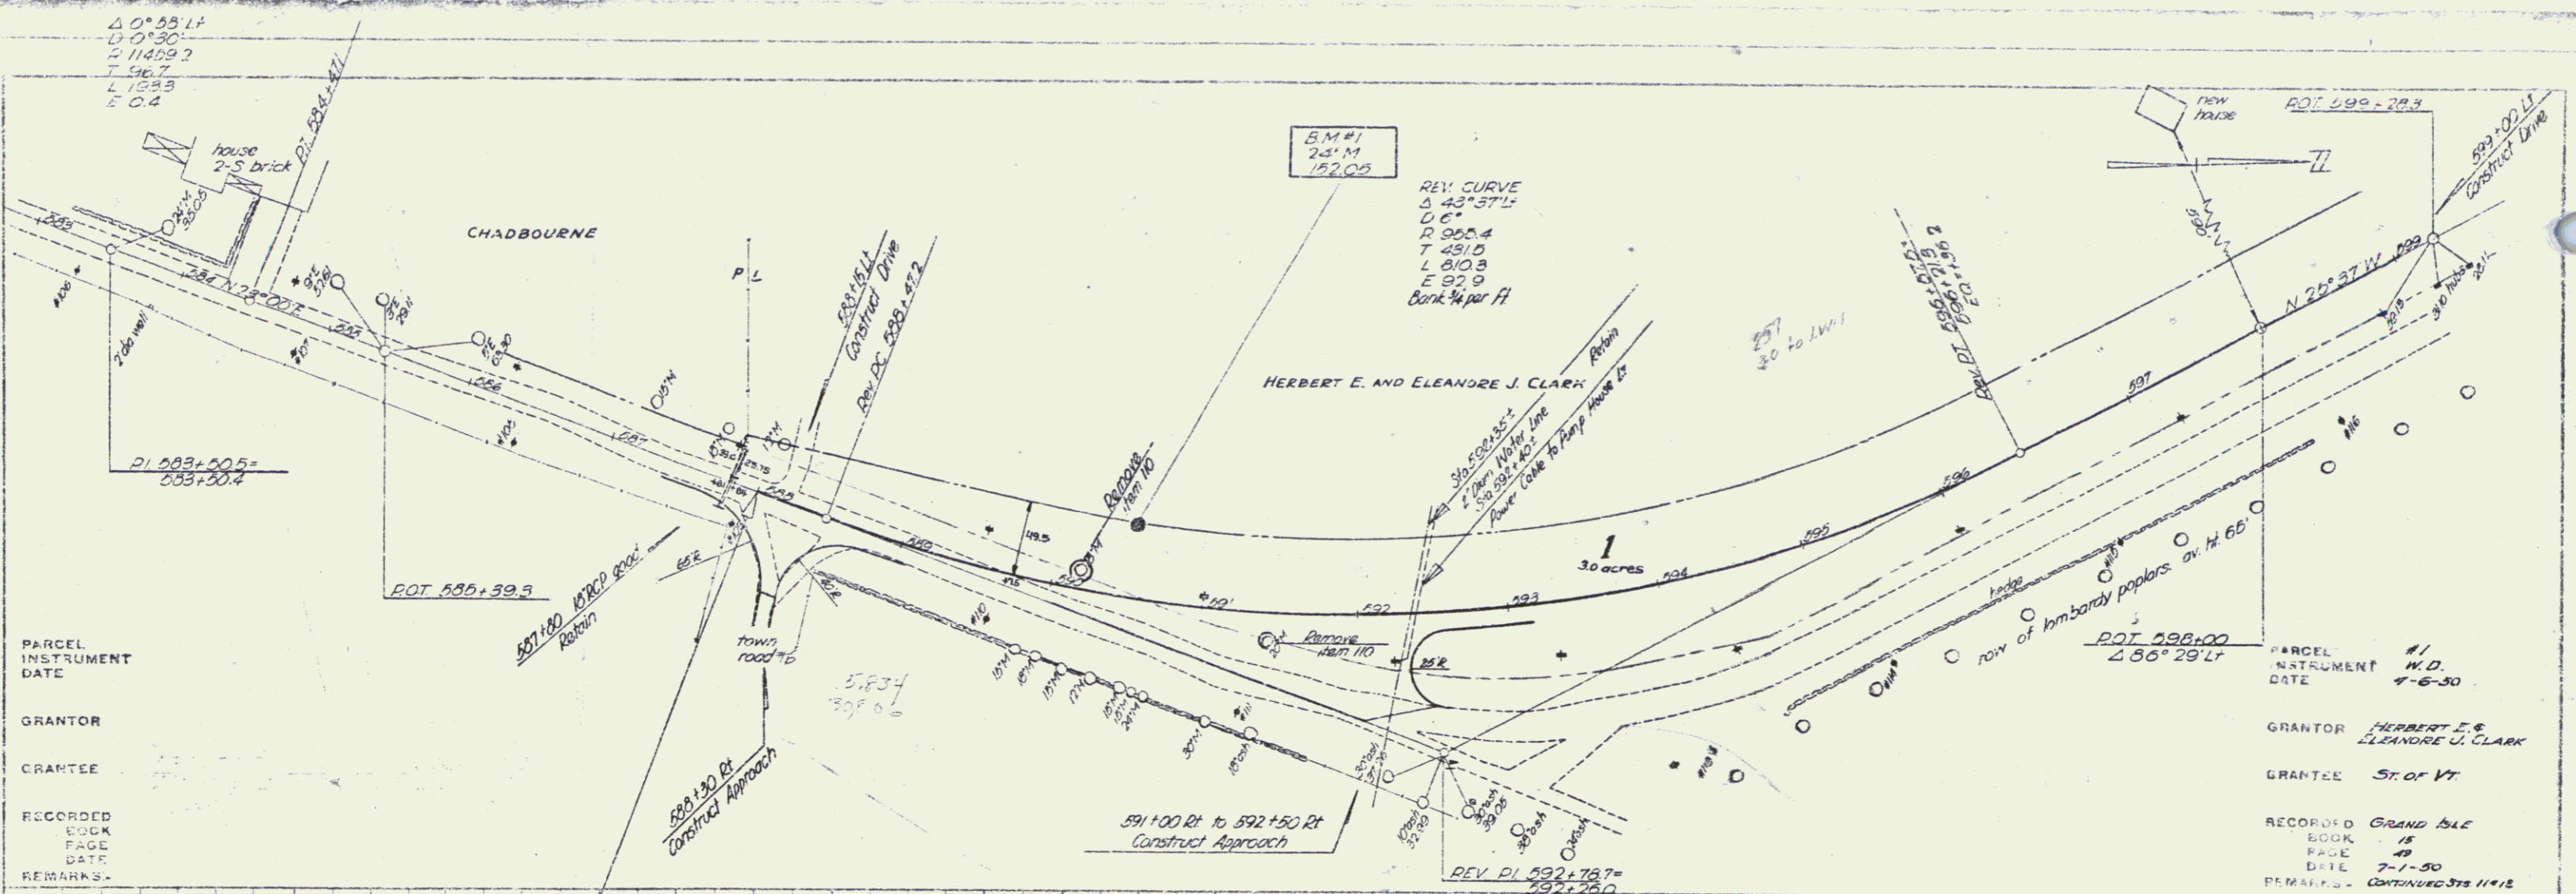

PARCEL INSTRUMENT DATE
GRANTOR
GRANTEE
RECORDED BOOK PAGE DATE REMARKS

PARCEL INSTRUMENT #1 W.D. 4-6-30 DATE
GRANTOR HERBERT E. & ELEANORE J. CLARK
GRANTEE ST. OF VT
RECORDED GRAND ISLE BOOK 15 PAGE 49 DATE 7-1-50 PERMITS - CONTINUED 318 11+12

B.M. #1 S.I.R. 24' M. 43.5' LT. STA 590+60 EL. 152.05

GRAND ISLE - NORTH HERO
DRAWN BY BRIDGE
Sheet 10 of 72

3