


NOTE REV. E
 0.0' @ 799+00
 3.0' @ 801+00 TO 805+50
 0.0' @ 805+00
 For other offsets see Cross Section sheets

794+50
 350 YL
 34.33

STA 796+00 TO 802+00
 10" Subbase or Stone - Macadam

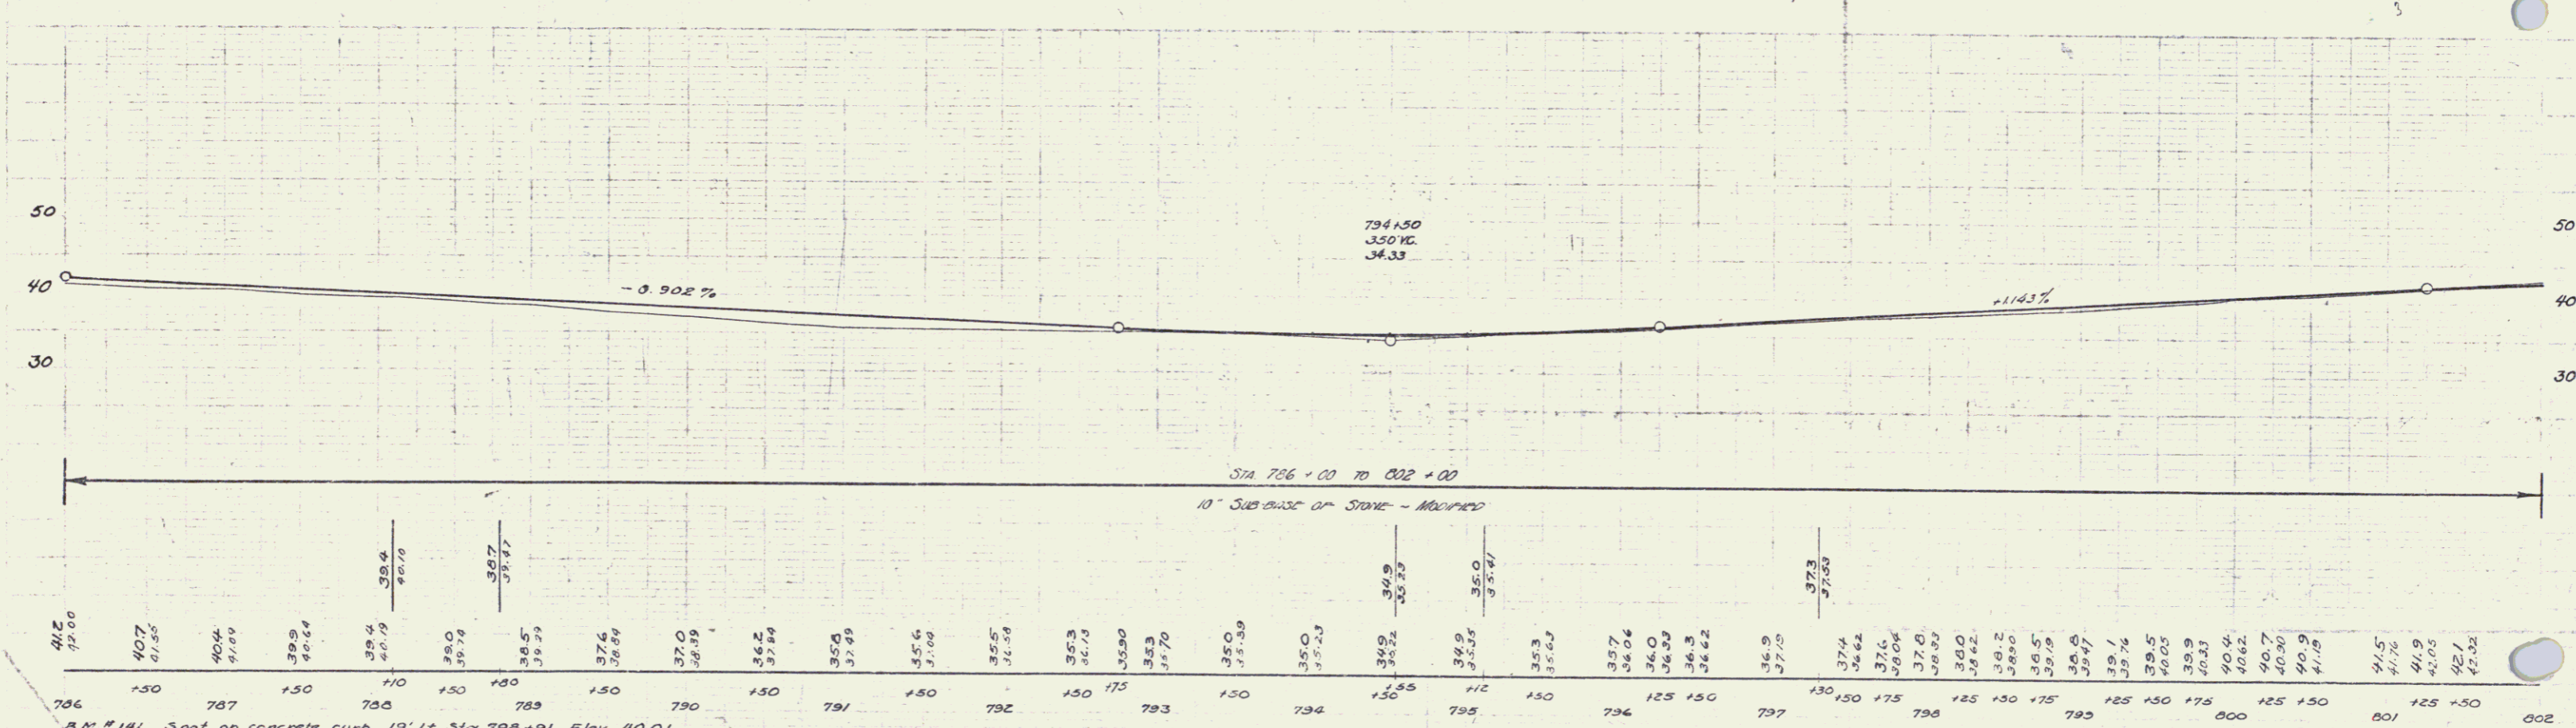

13