


**LINE CHANGE**

STATION	OFFSET RIGHT
12	50
13	50
14	50
0.02" = 1' V.C.  
0.04" = 1' V.C.

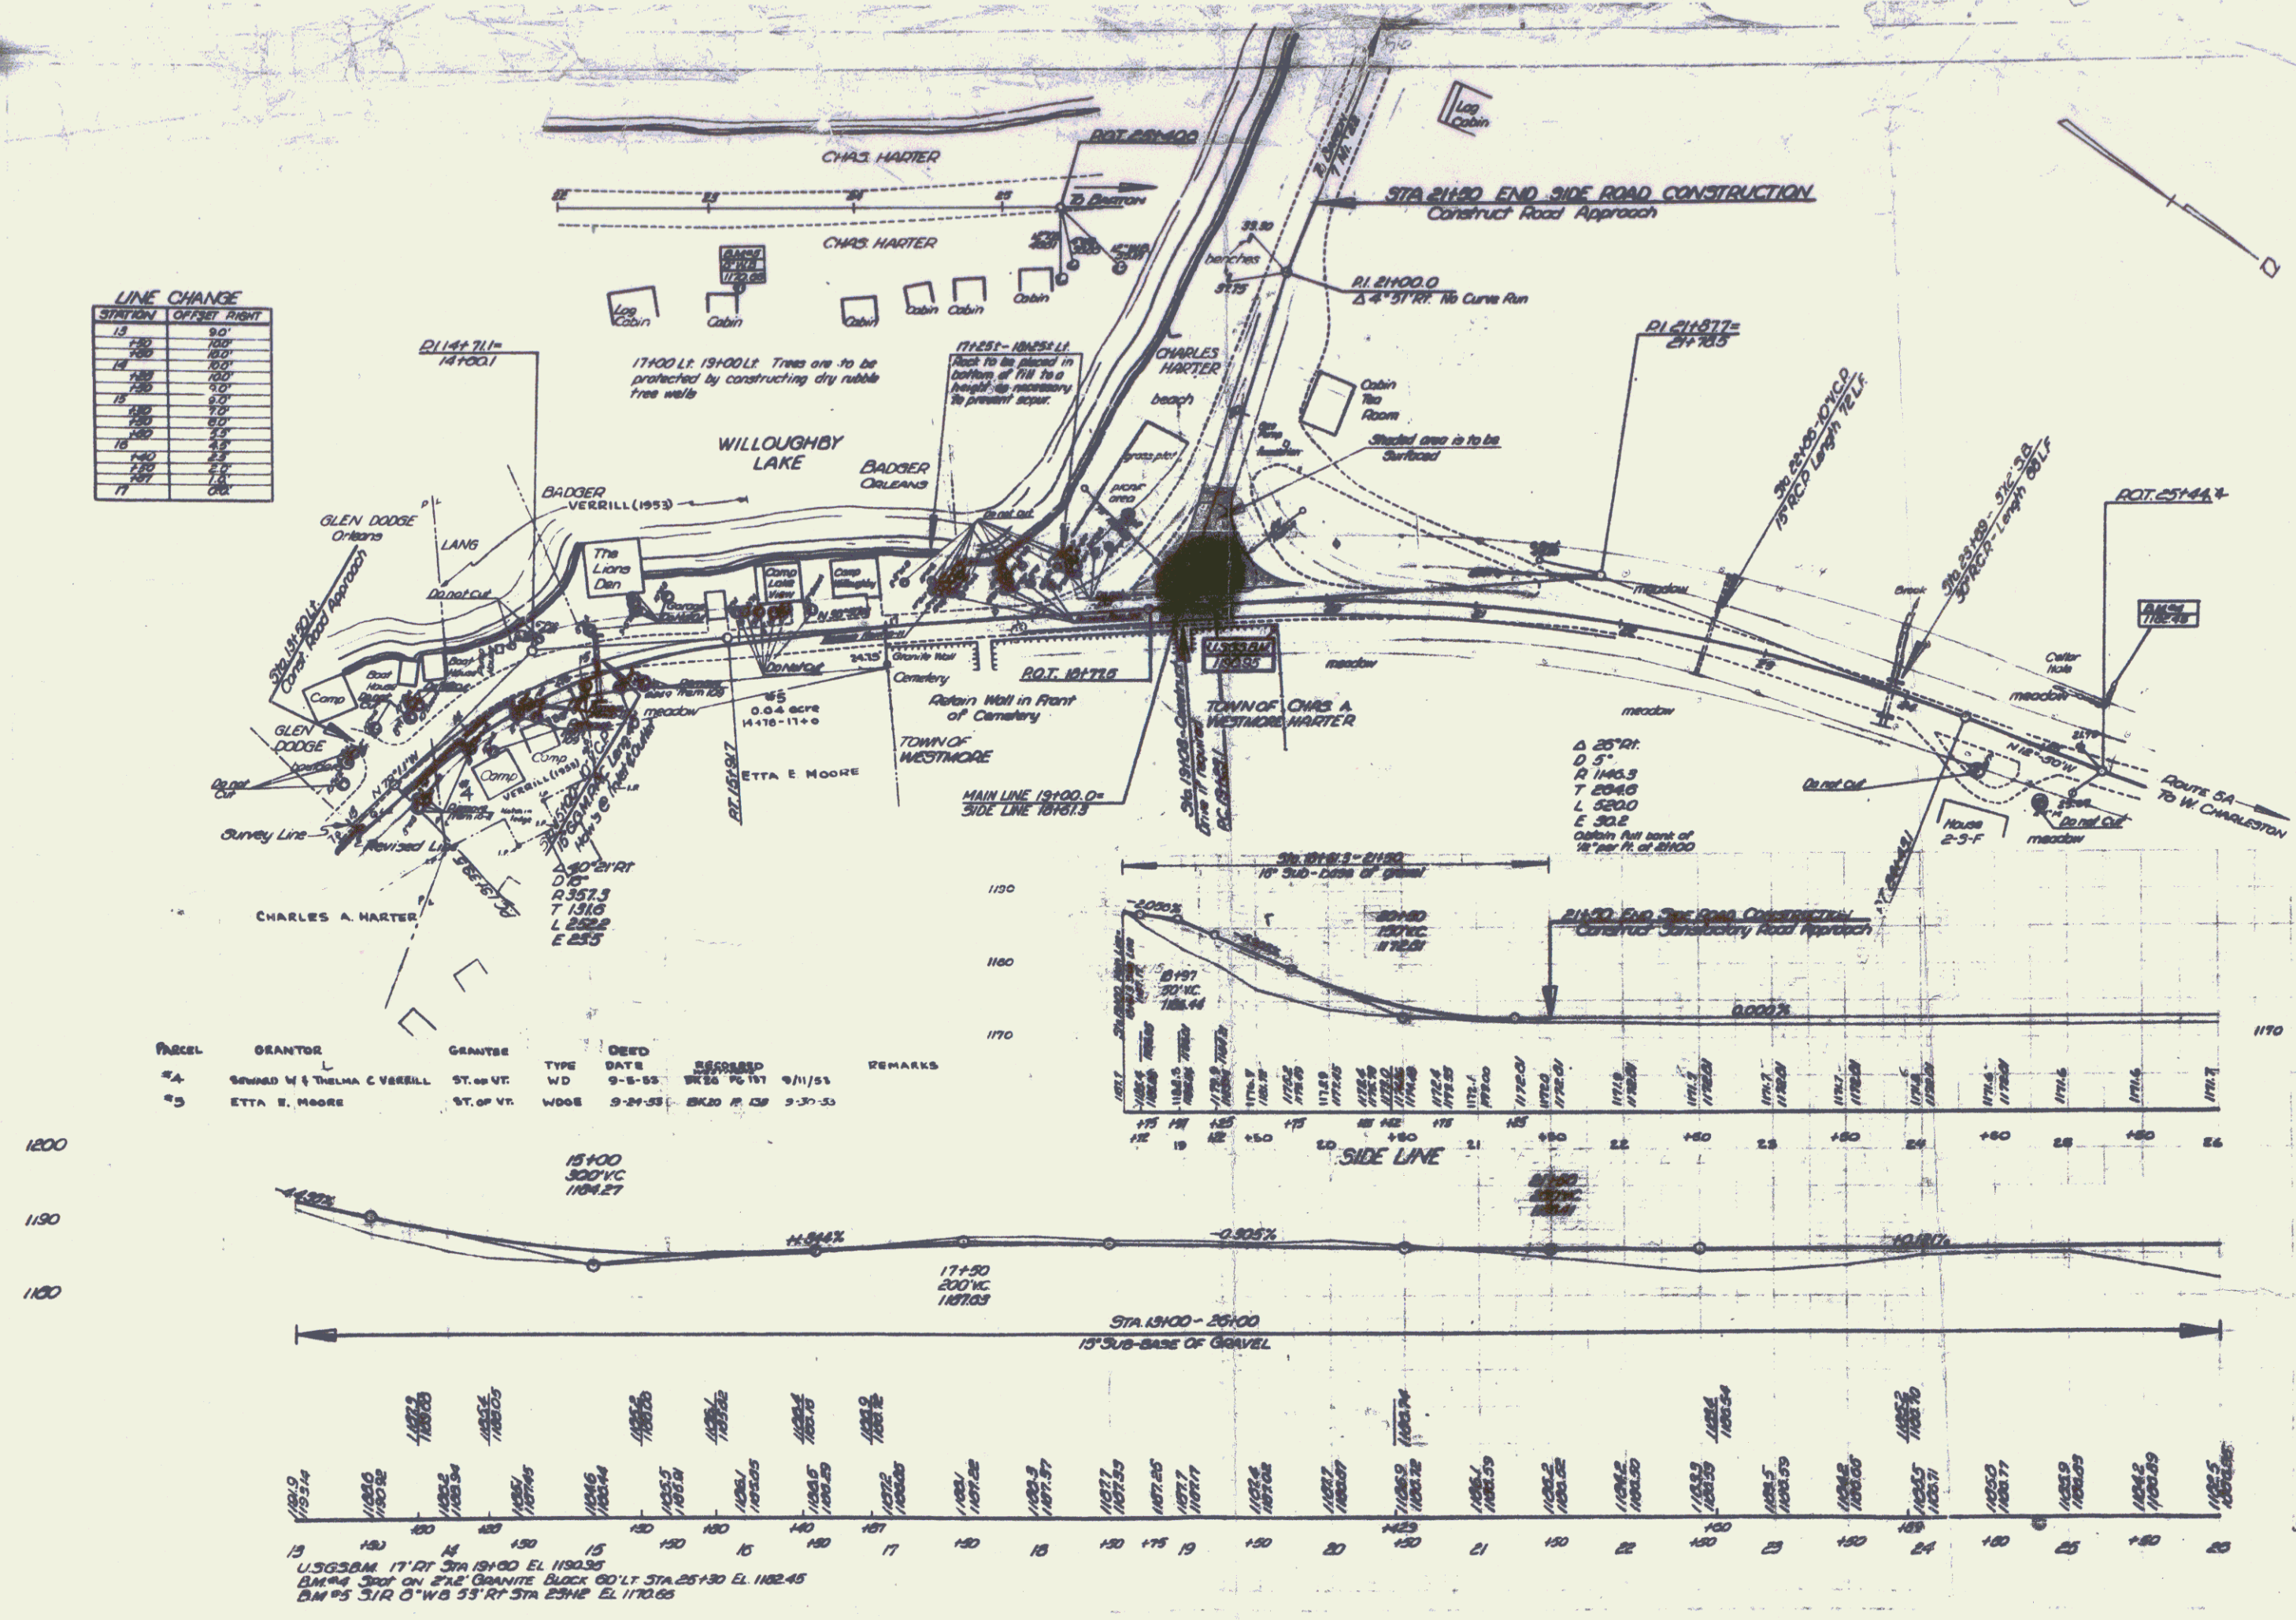

PARCEL	GRANTOR	GRANTEE	TYPE	DATE	RECORDED	REMARKS
24	SEYMOUR W & THELMA C VERRILL	ST. OF VT.	WD	9-8-55	8735 PG 197	9/11/51
25	ETTA B. MOORE	ST. OF VT.	WDOE	9-29-55	8732 PG 129	9-30-55

U.S.G.S. 1" = 1" 30' 1940 EL. 1190.95  
 BM #4 3" on 2" GRANITE BLK 60' LT STA. 25+30 EL. 1182.45  
 BM #5 3" 0" W 55' RT STA. 25+30 EL. 1170.65