

STATION	OFFSET	RIGHT
12	50	
13	50	
14	50	
0.02" = 100'
 1" = 100'




PARCEL	GRANTOR	GRANTEE	TYPE	DATE	RECORDED	REMARKS
24	SEYMOUR W & THELMA C VERRILL	ST. OF VT.	WD	9-8-55	BR 55 PG 191	9/11/51
25	ETTA B. MOORE	ST. OF VT.	WDOE	9-29-55	BR 55 PG 191	9-30-55

U.S.G.S. 1" = 100' 3" x 19" 1940 EL. 1190.35
 BM #4 3" x 4" GRANITE BLOCK 60' LT STA. 25+30 EL. 1182.45
 BM #5 3" x 4" GRANITE BLOCK 60' LT STA. 25+30 EL. 1170.65

LINE CHANGE

STATION	OFFSET RIGHT
13	9.0'
14	10.0'
15	10.0'
16	10.0'
17	10.0'
18	9.0'
19	8.0'
20	7.5'
21	7.0'
22	6.5'
23	6.0'
24	5.5'
25	5.0'
26	4.5'
27	4.0'
28	3.5'
29	3.0'
30	2.5'
31	2.0'
32	1.5'
33	1.0'
34	0.5'
35	0.0'

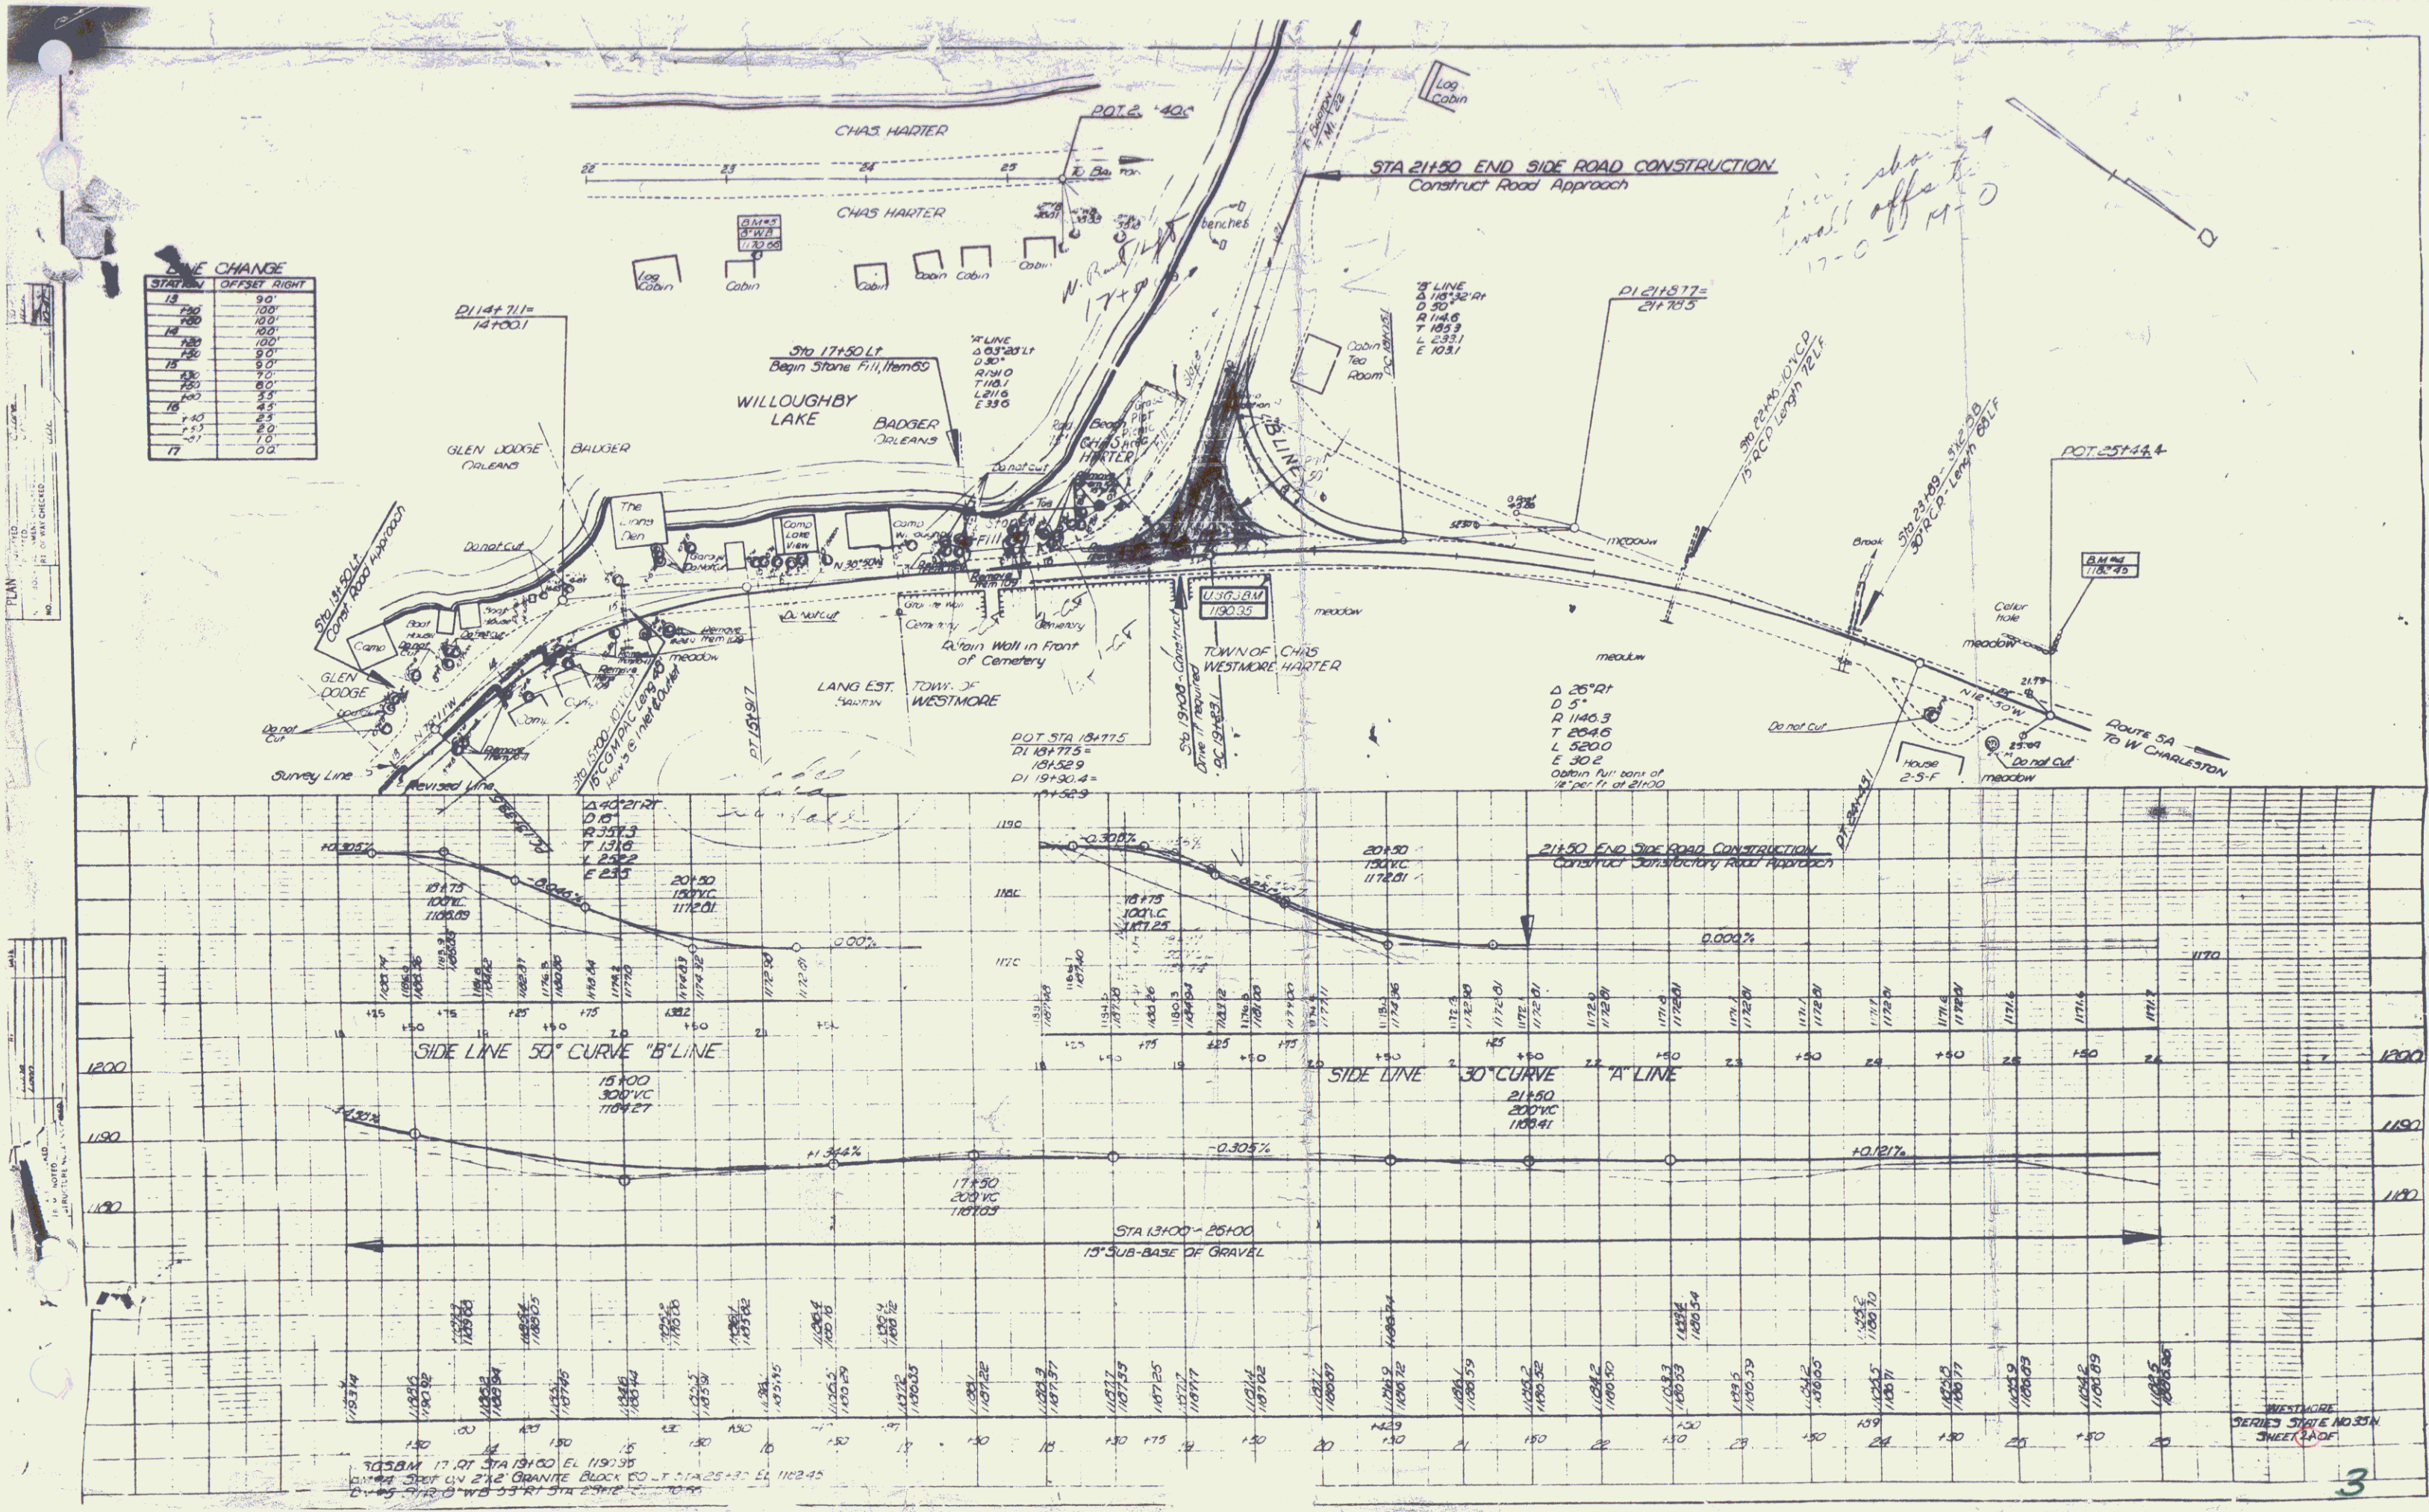

WESTMORE
SERIES STATE NO. 35-N
SHEET 3-ADP