



REIN. CONC. BOX REQUIRED.				CORRUS. GALV. METAL PIPE (RIP COATED) CULVERTS.				
STA.	SIZE	LENG.	CONC. CL. A. STEEL	STA.	DIA.	LENG.	C.F.M.	
5+66	8'x6'	97'	59.0x4	4528"	1+55	18"	90'	274.4
					3+63	18"	90'	374.4

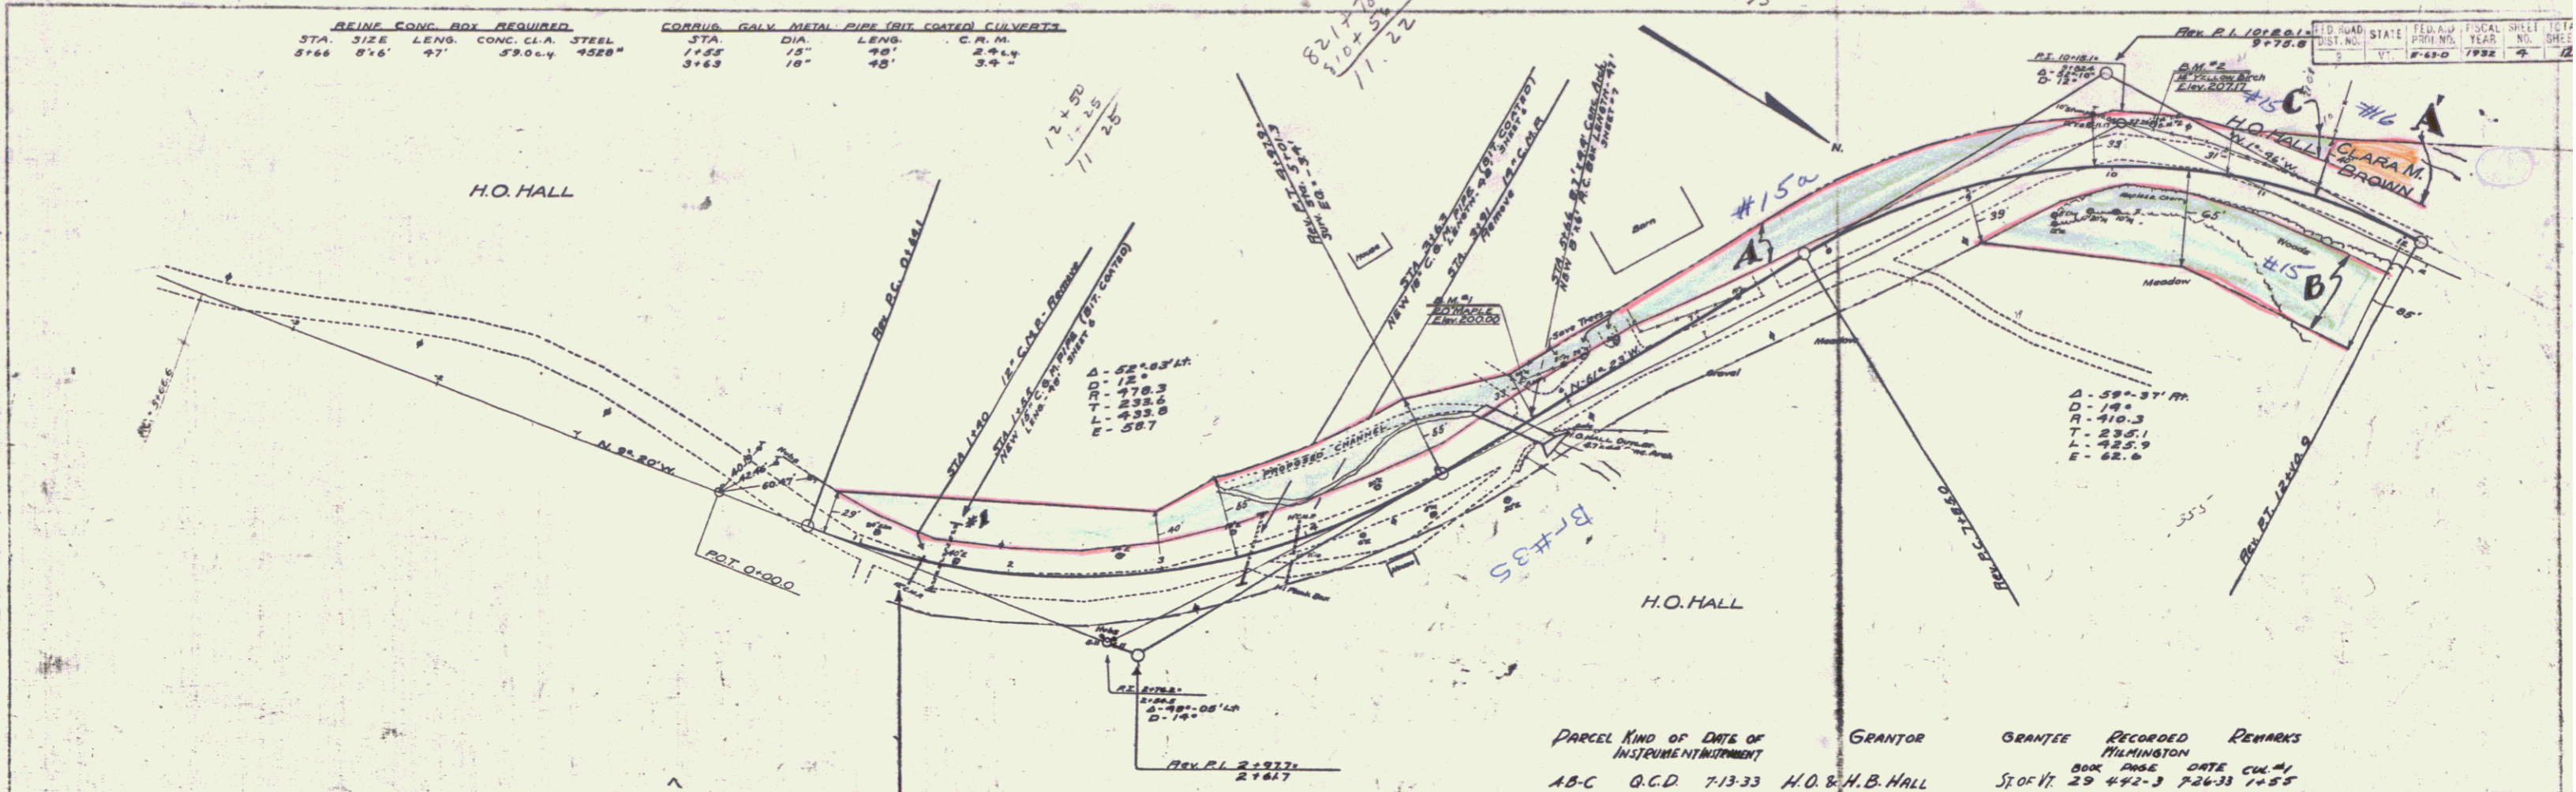

PARCEL	KIND OF INSTRUMENT	DATE OF INSTRUMENT	GRANTOR	GRANTEE	RECORDED	REMARKS
A-B-C	G.C.D.	7-13-33	H.O. & H.B. HALL	ST. OF VT.	29 442-3	7-26-33 1+55
A-B-C	G.C.D.	2-1-33	CLARA M. BROWN	"	29 392-3	2-6-33

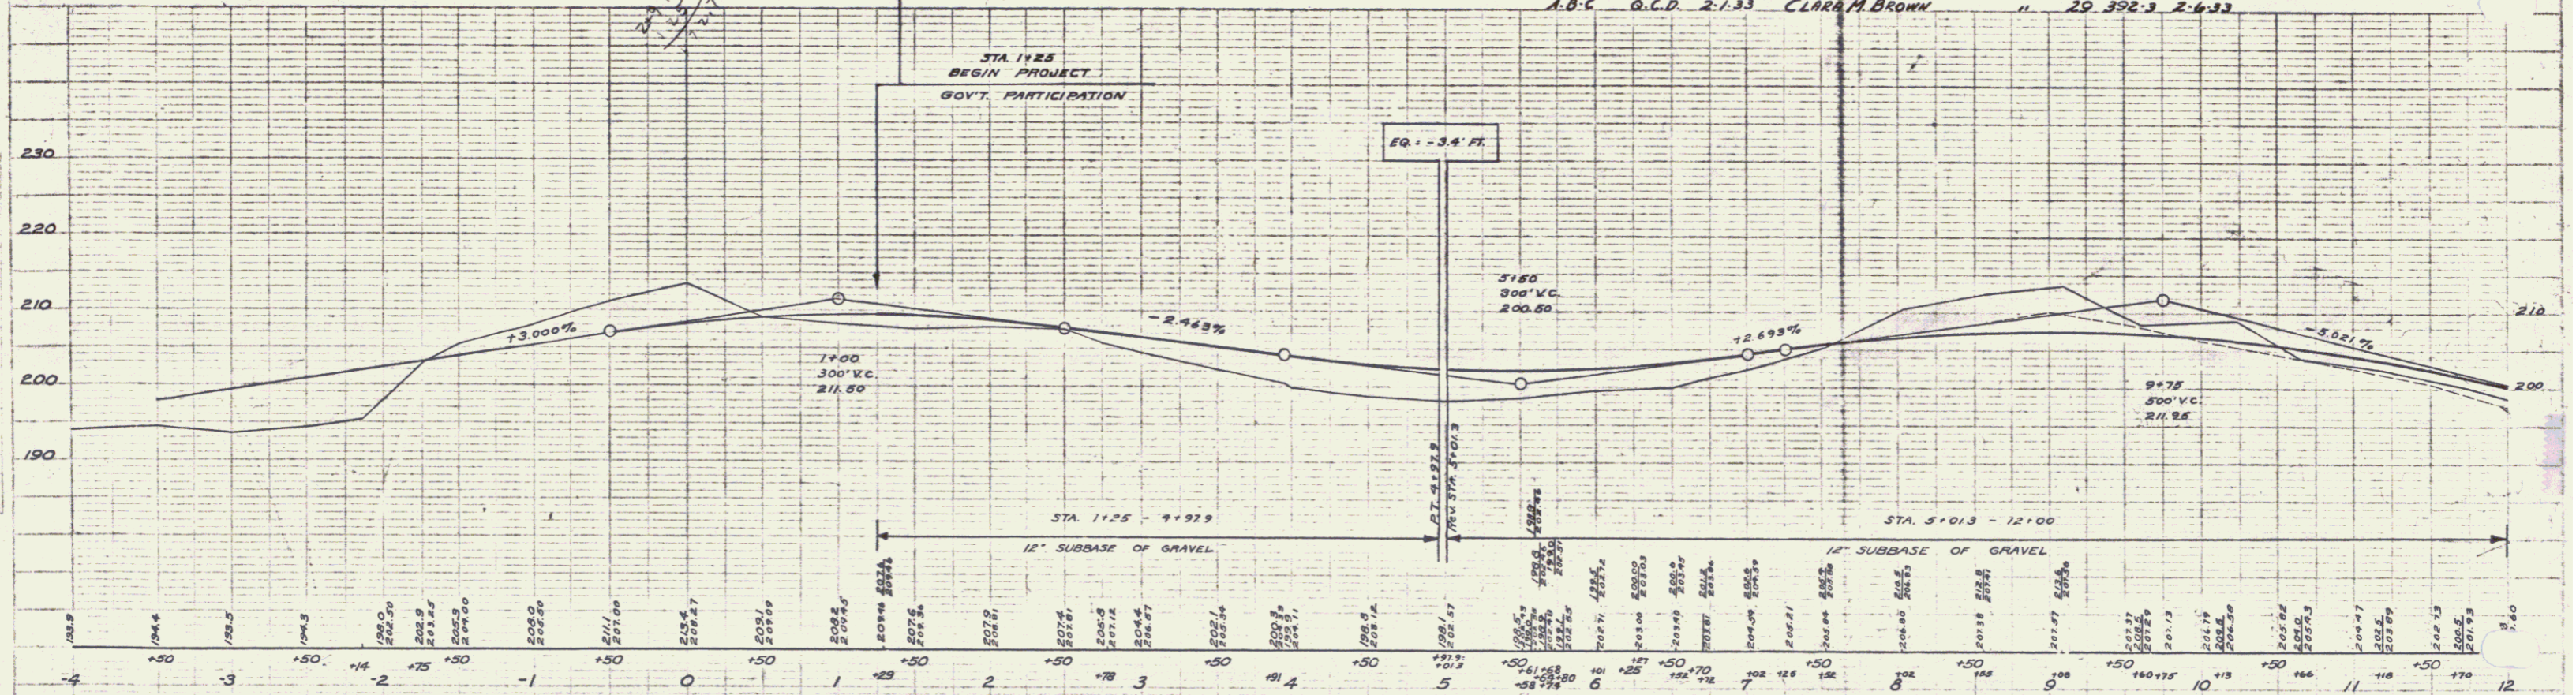

B.M. #1 SPIKE IN ROOT OF 20' MAPLE 31 FT. LT. STA. 5+79 ELEV. 200.00  
 B.M. #2 SPIKE IN ROOT OF 14" YELLOW BIRCH 52 FT. LT. STA. 10+21 ELEV. 207.17

SERIES F No. E 63D  
 SHEET 7 OF 12