


PLAN
 DATE: 10/1/01
 DRAWN BY: [illegible]
 CHECKED BY: [illegible]
 PROJECT NO.: [illegible]

PROFILE
 DATE: 10/1/01
 DRAWN BY: [illegible]
 CHECKED BY: [illegible]
 PROJECT NO.: [illegible]



ALL DRIVES AS INDICATED ON PLANS ARE SUBJECT TO PERMITS PURSUANT TO TITLE 19, V.S.A. SECTION 43

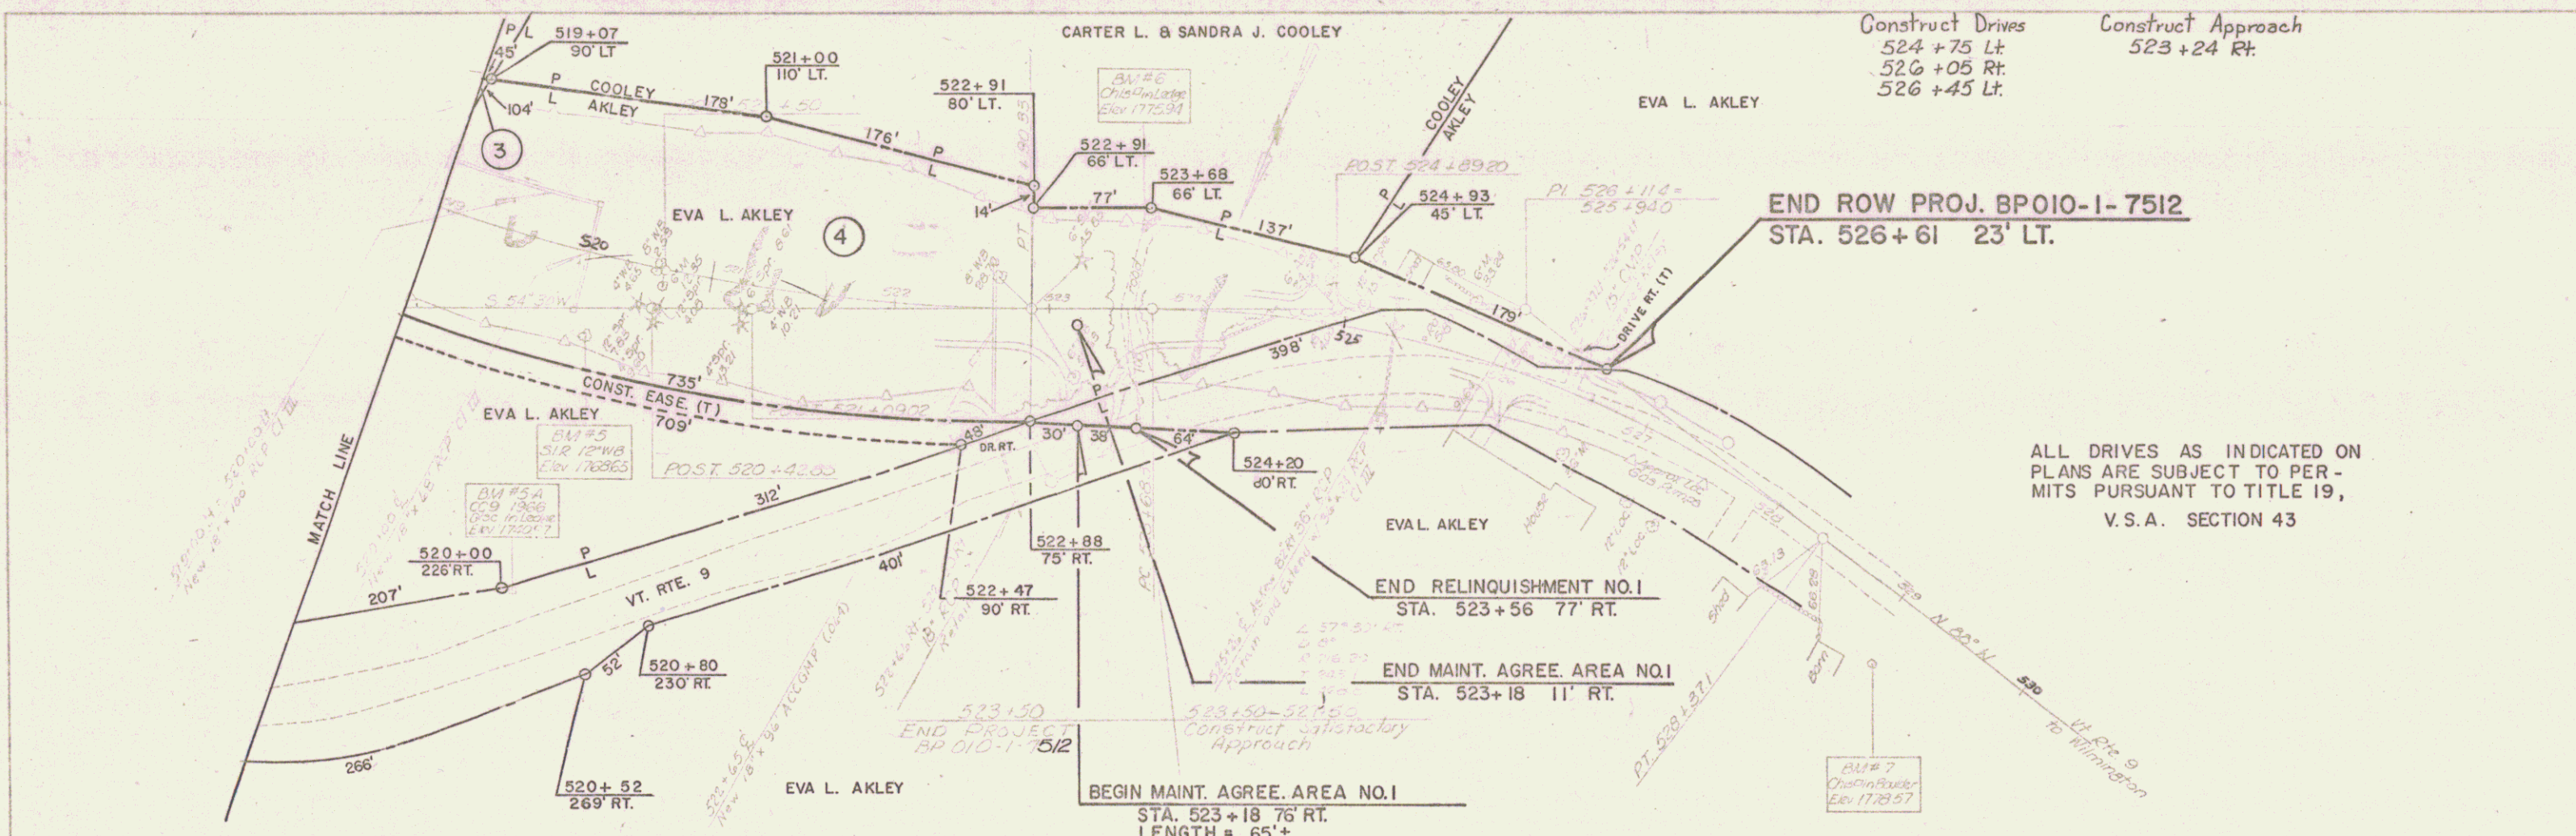