

#12 IN
LOOK IN SIZE

NEED
DOCUMENT

✓ Sell Off to CERASOLI
NOT IN DEED BOOK
KNOWN FROM
MP 0132 7/16

392+2
119' LT.

29'

392+21
90' LT.

FORMERLY PARCEL NO. 40F

TOTAL AREA 0.18A±

ACQUIRED AS PARCEL NO. 40F FROM ROGER CERASOLI, D/B/A CERASOLI & CERASOLI, BY CONDEMNATION ON JULY 18, 1972 & RECORDED IN BOOK 92 PAGE 461 ON JULY 20, 1972.

392+74
140' LT.

TO BERLIN STREET

SMITH STREET

229'

276'

FORMERLY PARCEL NO. 39D

ACQUIRED AS PARCEL NO. 39D FROM THE D.M. MILES COAL CO. INC. BY W.D. DATED MAY 30, 1972 & RECORDED IN BOOK 92, PAGE 177, ON JUNE 1, 1972.

394+37
90' LT.

TO BLACKWELL STREET



MP 0312


TO BERLIN ST

392

393

394

TO MAIN ST. 395

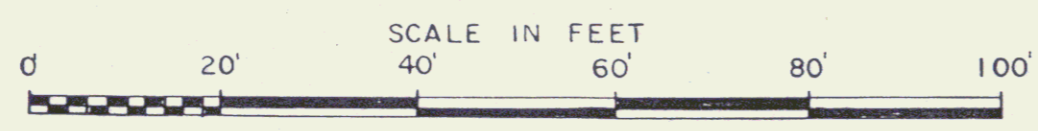

REF. SHEETS 34 & 35 OF 63

STATE OF VERMONT
DEPT. OF HIGHWAYS

Sheet 334

CITY OF BARRE

PROJECT BERLIN-BARRE F026-1(7)

APPROX. SCALE 1"=20' DATE 1/26/78 DRAWN BY A.G.S.