


Parcel	Kind of Instrument	Date	Grantor	Grantee	Recorded Book Page	Date	Remarks
944+90	G.C.D.	6-2-37	Stoddard	Stoddard	16	201	6-2-37 949+00

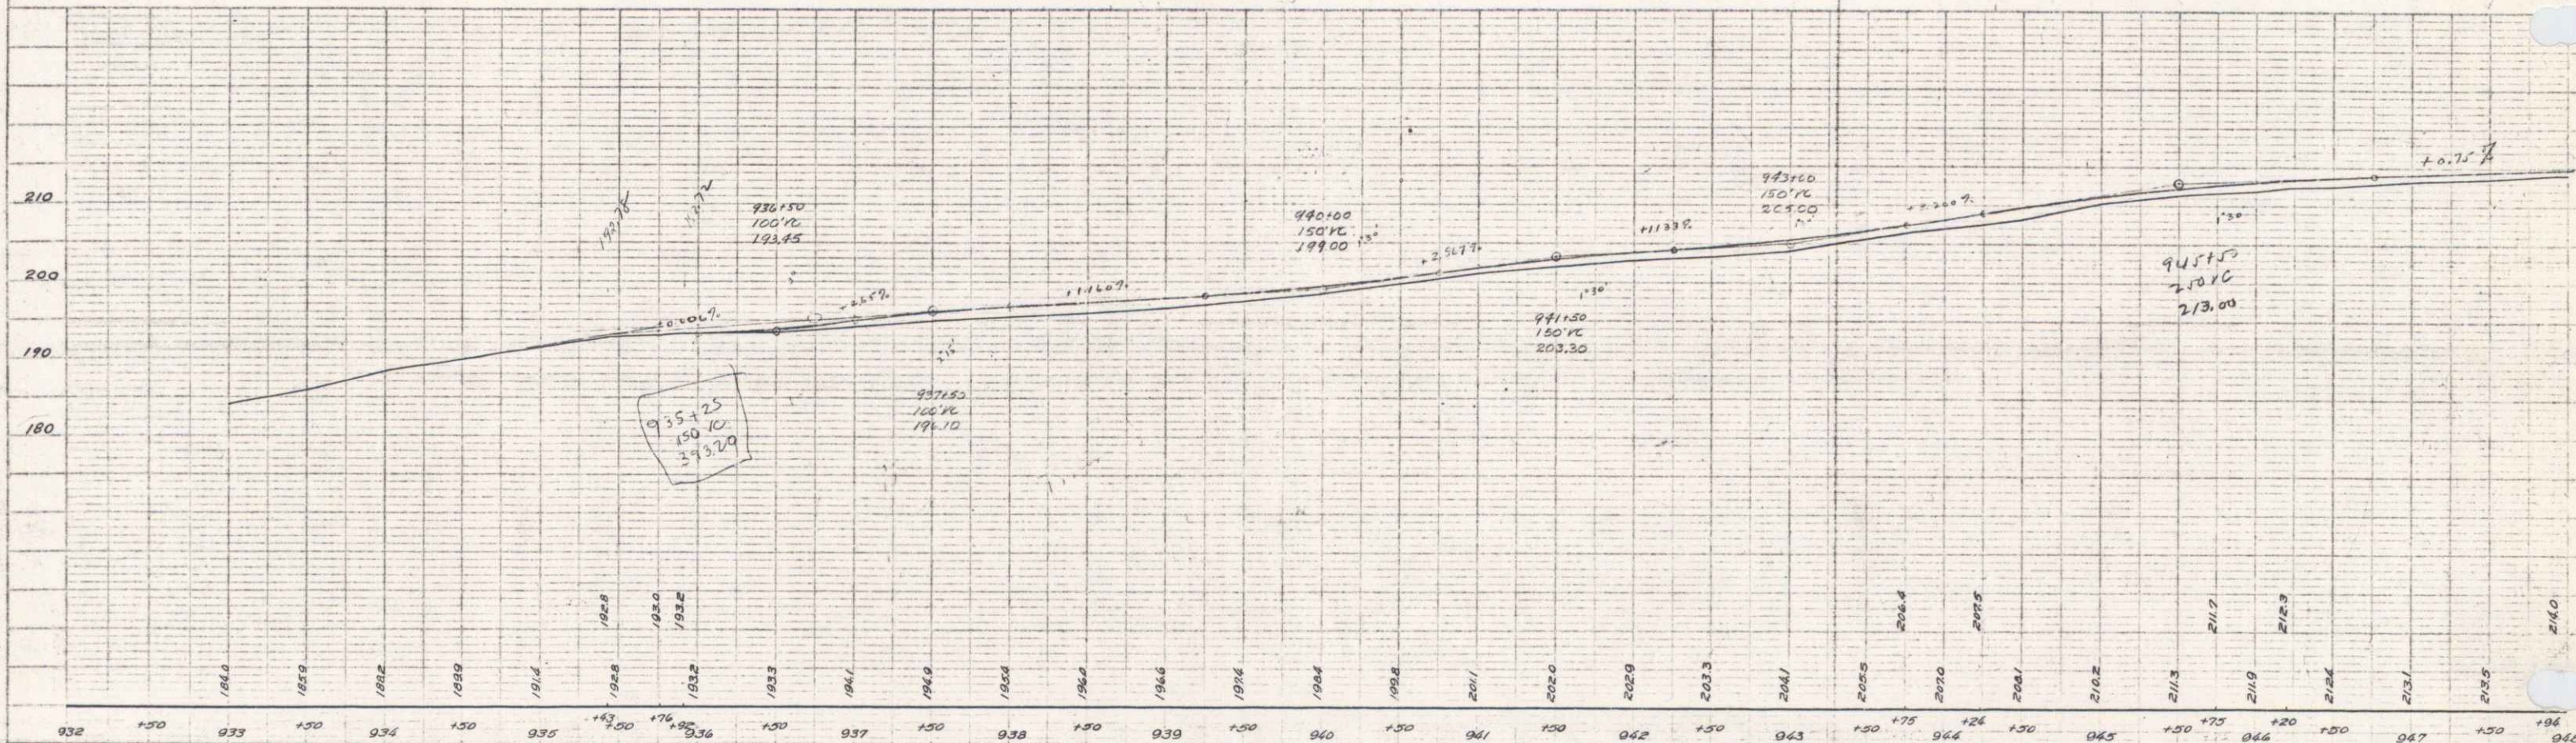

B.M. #35 SPIKE IN TRUNK 12" ELM 22 FT. RT STA 946+56 ELEV. 213.24  
 Δ.M. #36 TOP CONCRETE BRIDGE RAIL 105 FT. RT. STA 935+75 ELEV. 196.90

SERIES No. E 101 F  
 SHEET 2 OF 2