


PARCEL	KIND OF DISE OF INSTRUMENT	GRANTOR	GRANTEE	RECORDED BOOK	RECORDED DATE	REMARKS
A-B-C-D-E-F-G	Q.C.D.	12-23-32	MELVIN COLTON	57847	17 32	1-23-33 106+50
H-I	Q.C.D.	12-23-32	LILLIAN M. TOWNE	"	17 38	1-23-33

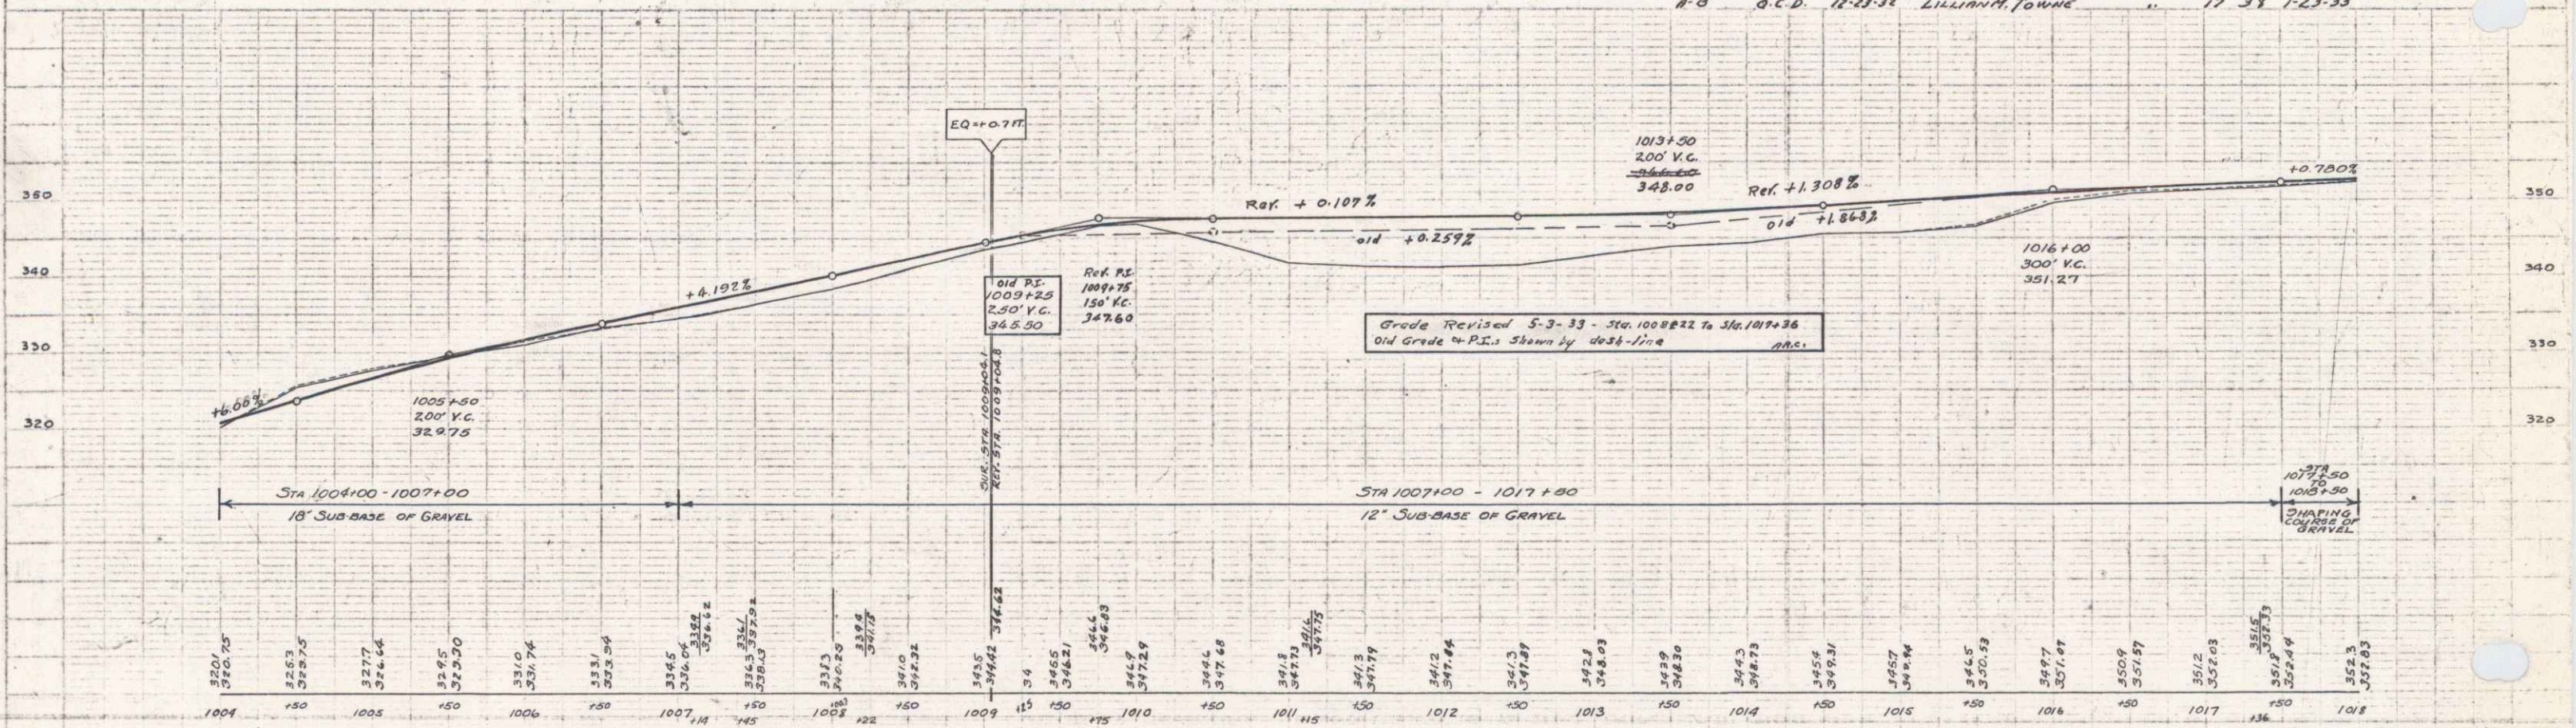

PLAN
 1" = 40'
 1" = 40'

PROFILE
 1" = 10'
 1" = 100'

31 #26 SPIKE IN ROOT 36" ELH. 19 FT. LT. STA. 1012+32 ELEV. 343.43
 31 #27 SPOT ON 8 FT. BOULDER 20 FT. LT. STA. 1005+50 ELEV. 336.34

SERIES I No. E101F
 SHEET 7 OF 53

7