


WHITE RIVER

REV CURVE DATA  
Δ 61° 42' LT  
D 9'  
R 6366  
T 3303  
L 6336  
L 1049  
Bank 2 per 4'

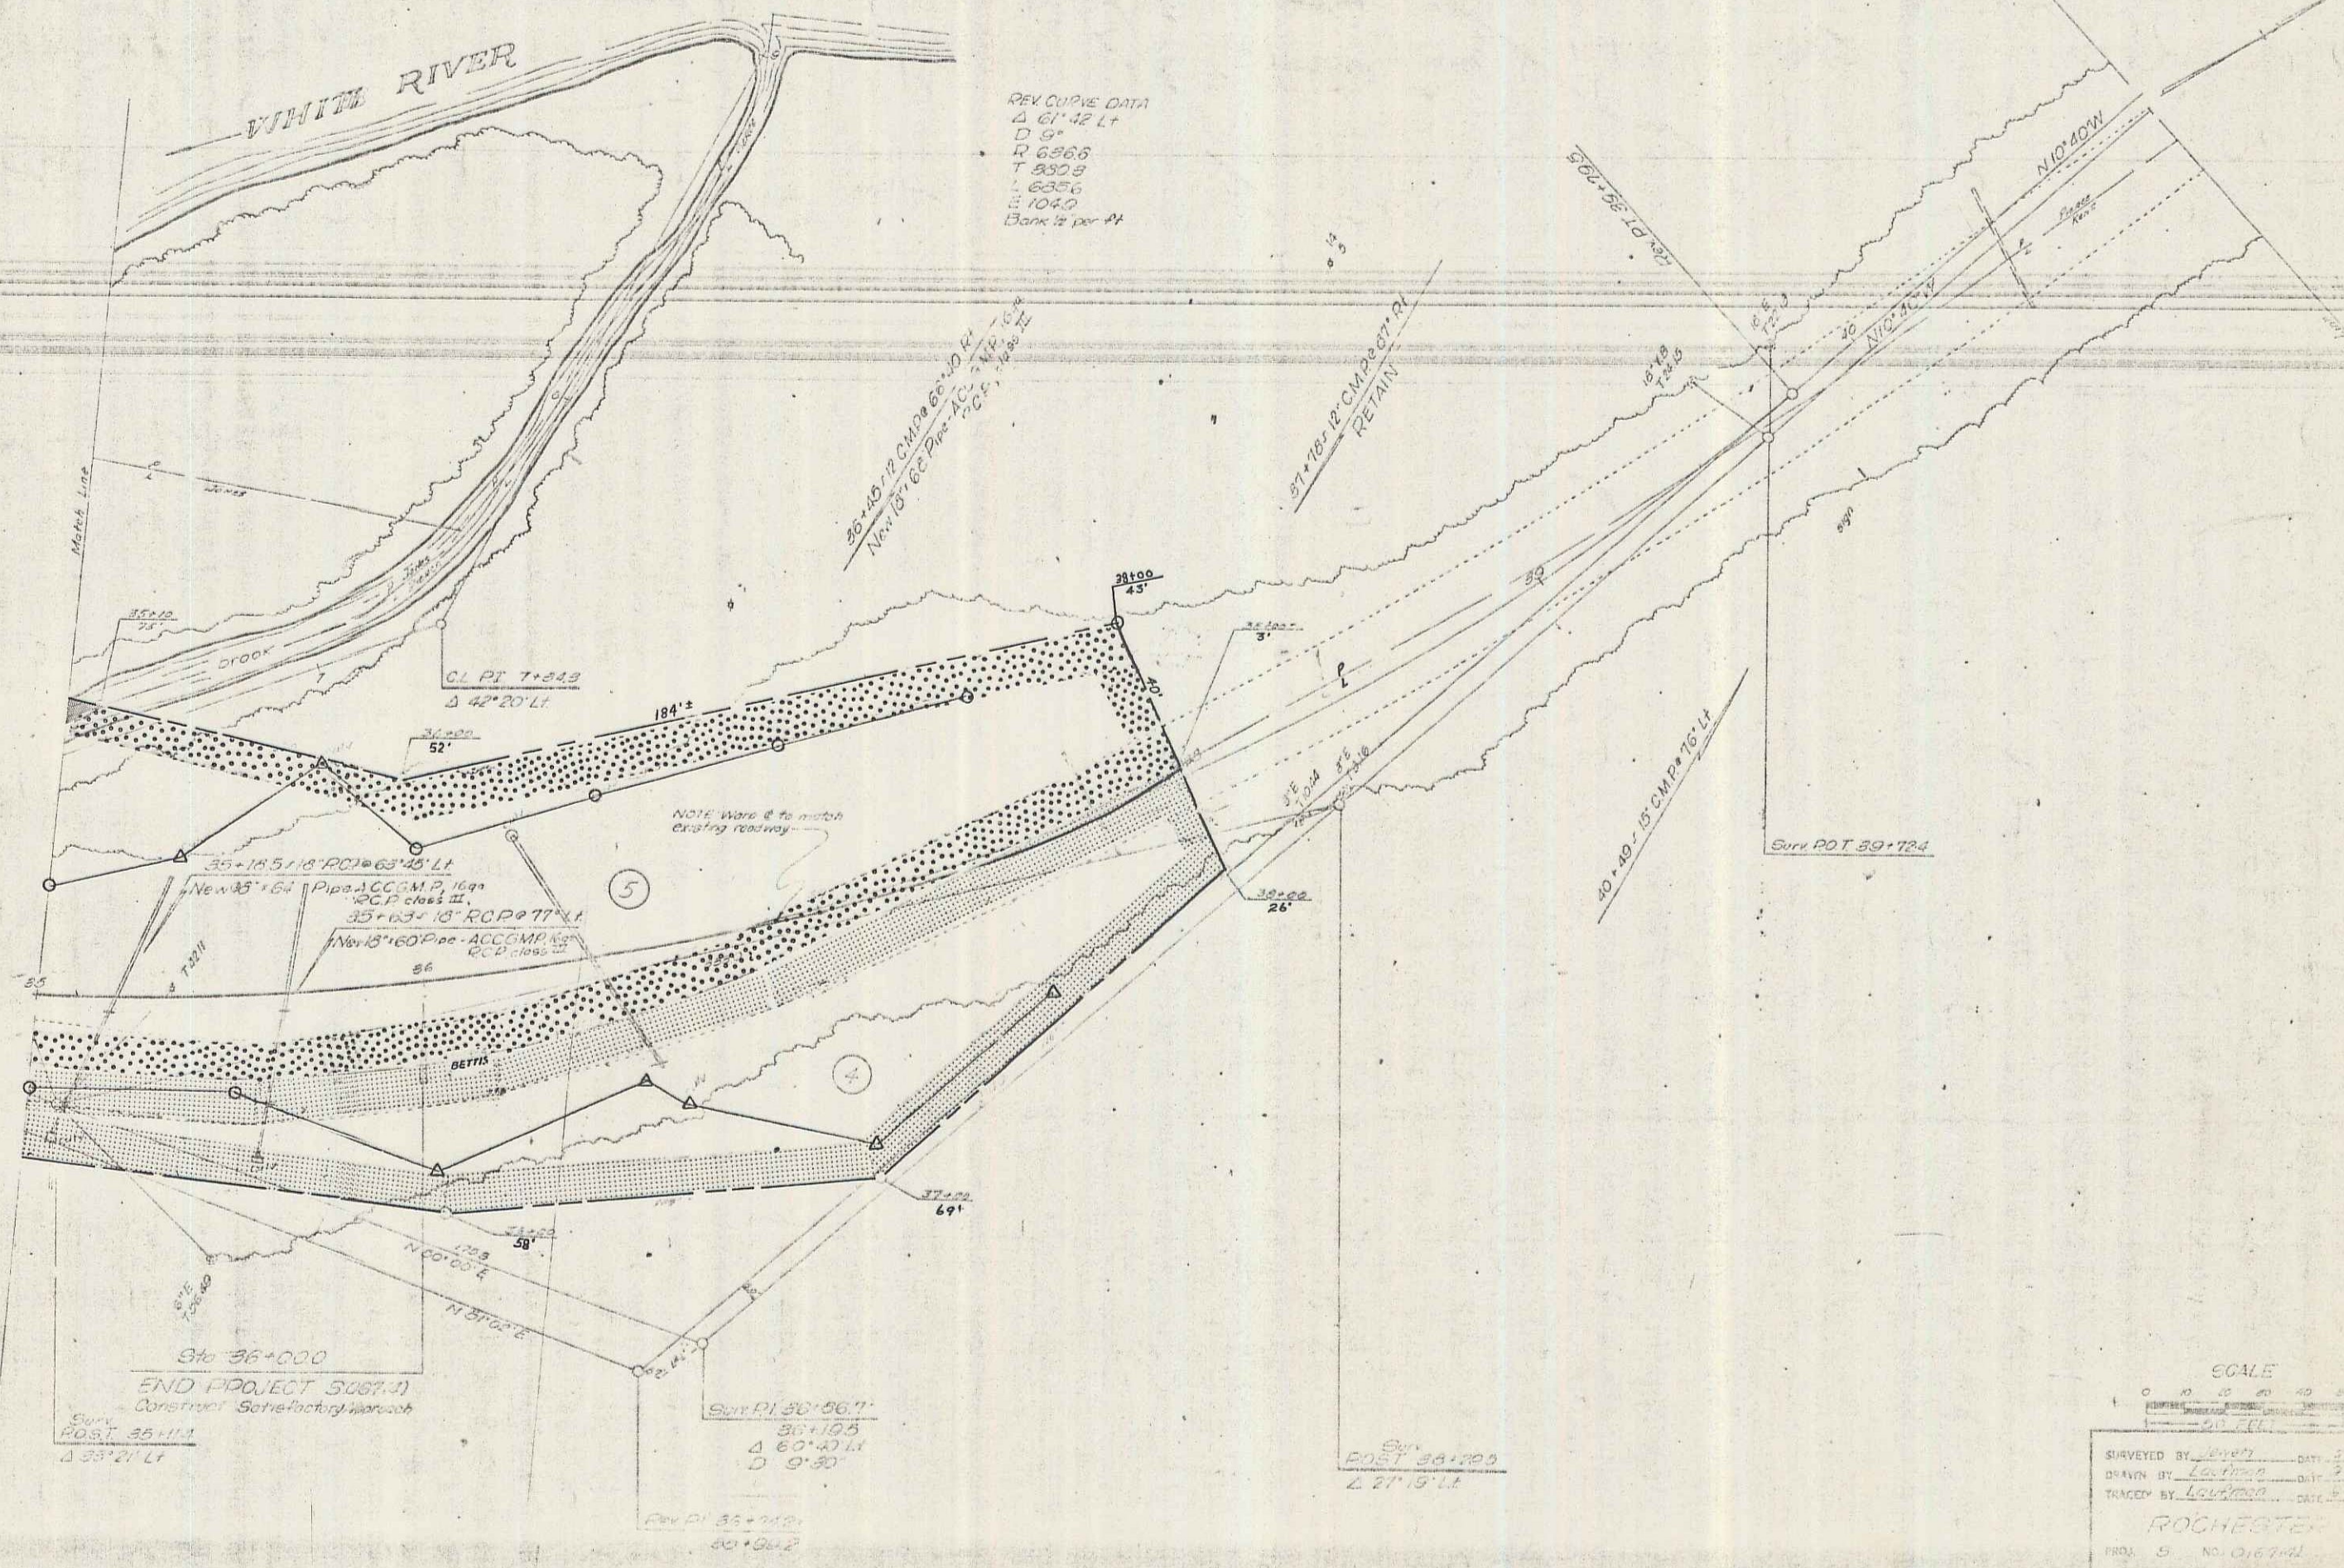

Sta 36+000  
END PROJECT 5087-1  
Construct Retaining walls

Sum PI 30+06.71  
30+10.5  
Δ 60° 47' LT  
D 9' 30"

POST 35+00  
2 27' 15" LT

SCALE  
0 10 20 30 40 50  
SURVEYED BY Lowrey DATE 2-27  
DRAWN BY Lowrey DATE 3-1  
TRACED BY Lowrey DATE 3-1  
ROCHESTER  
PROJ. NO. 0167-41  
SHEET 5 OF 51

9A 7