


1-30
 2-30
 3-30
 100-30

1-31
 2-31
 3-31
 100-31

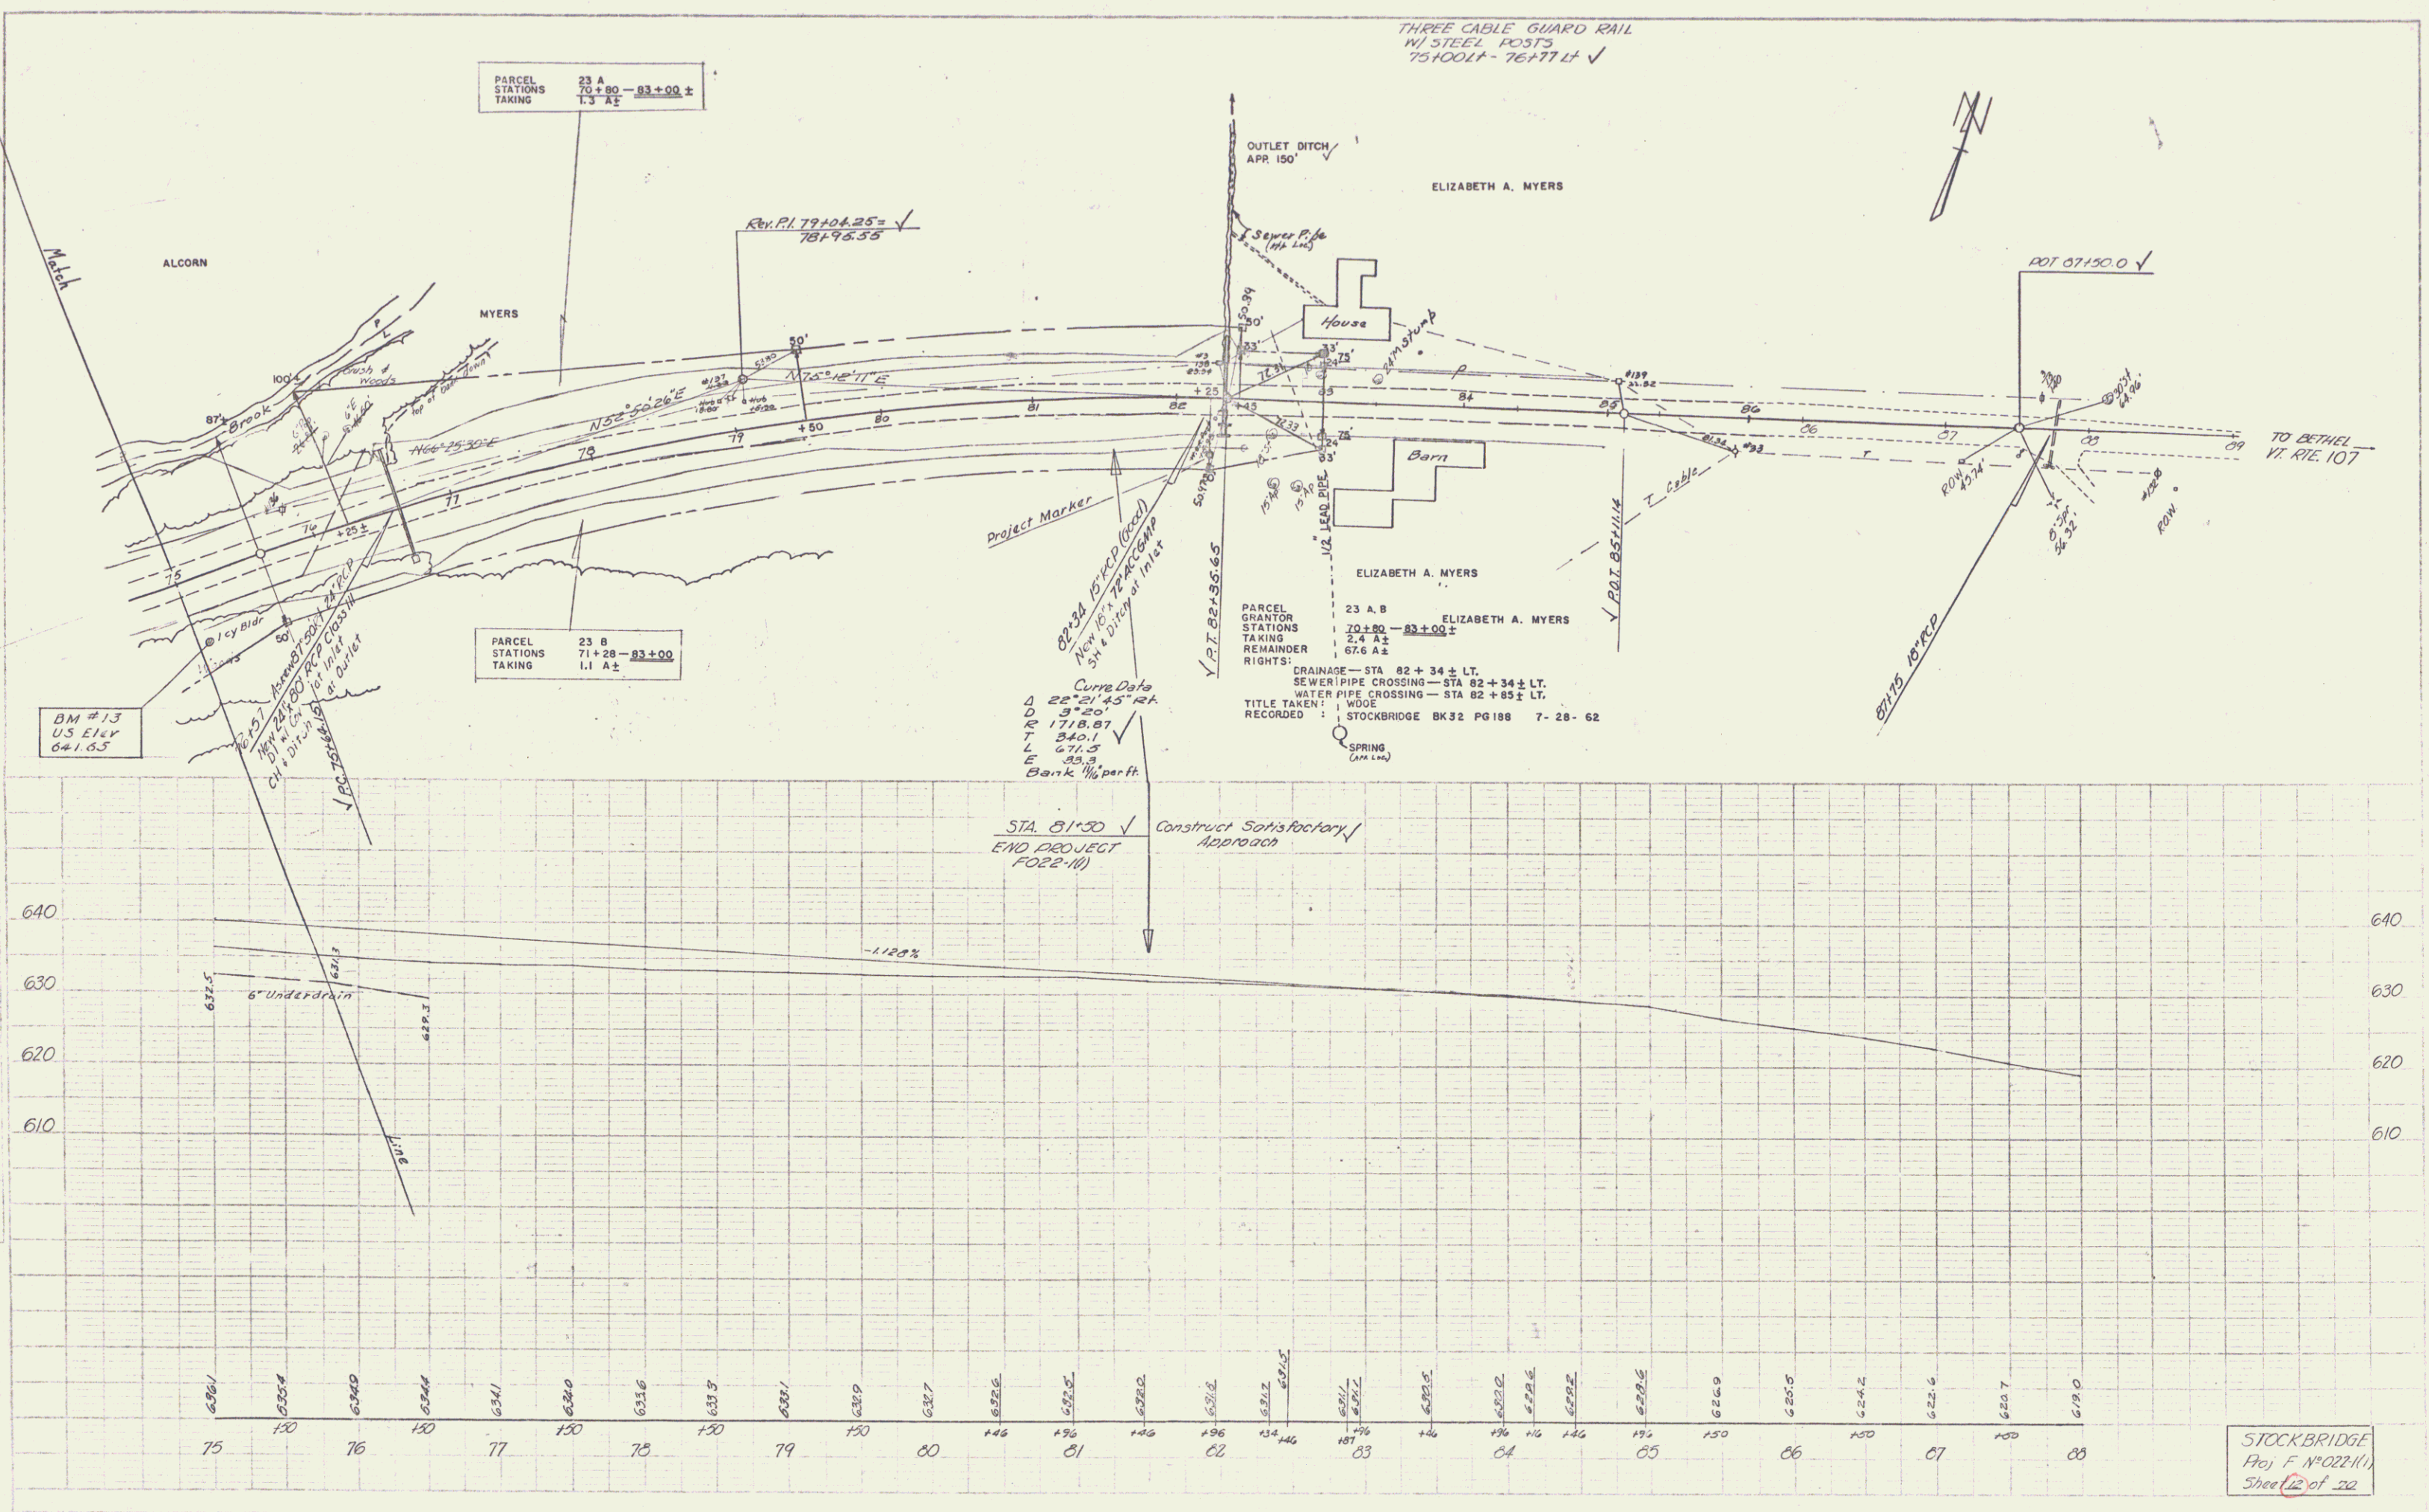

PARCEL
 STATIONS
 TAKING
 23 A
 70+80 - 83+00 ±
 1.3 A ±

PARCEL
 STATIONS
 TAKING
 23 B
 71+28 - 83+00
 1.1 A ±

ELIZABETH A. MYERS
 PARCEL
 GRANTOR
 STATIONS
 TAKING
 REMAINDER
 RIGHTS:
 CRAINAGE - STA 82+34 ± LT.
 SEWER PIPE CROSSING - STA 82+34 ± LT.
 WATER PIPE CROSSING - STA 82+83 ± LT.
 TITLE TAKEN: WDOE
 RECORDED: STOCKBRIDGE BK 32 PG 188 7-28-62
 SPRING (AM L&A)

Curve Data
 D 26° 21' 45" 124'
 R 97+20'
 T 1718.87'
 L 340.1'
 E 671.3'
 Bank 1/2 part ft

STA. 81+50
 END PROJECT
 F022-11) Construct Satisfactory
 Approach

STOCKBRIDGE
 Proj. F. N° 022(11)
 Sheet 12 of 22