


P.I. 86+55.37  
86+19.55

TN 27

Halifax BMA 6221  
Ut. Rte 112  
(District Job)

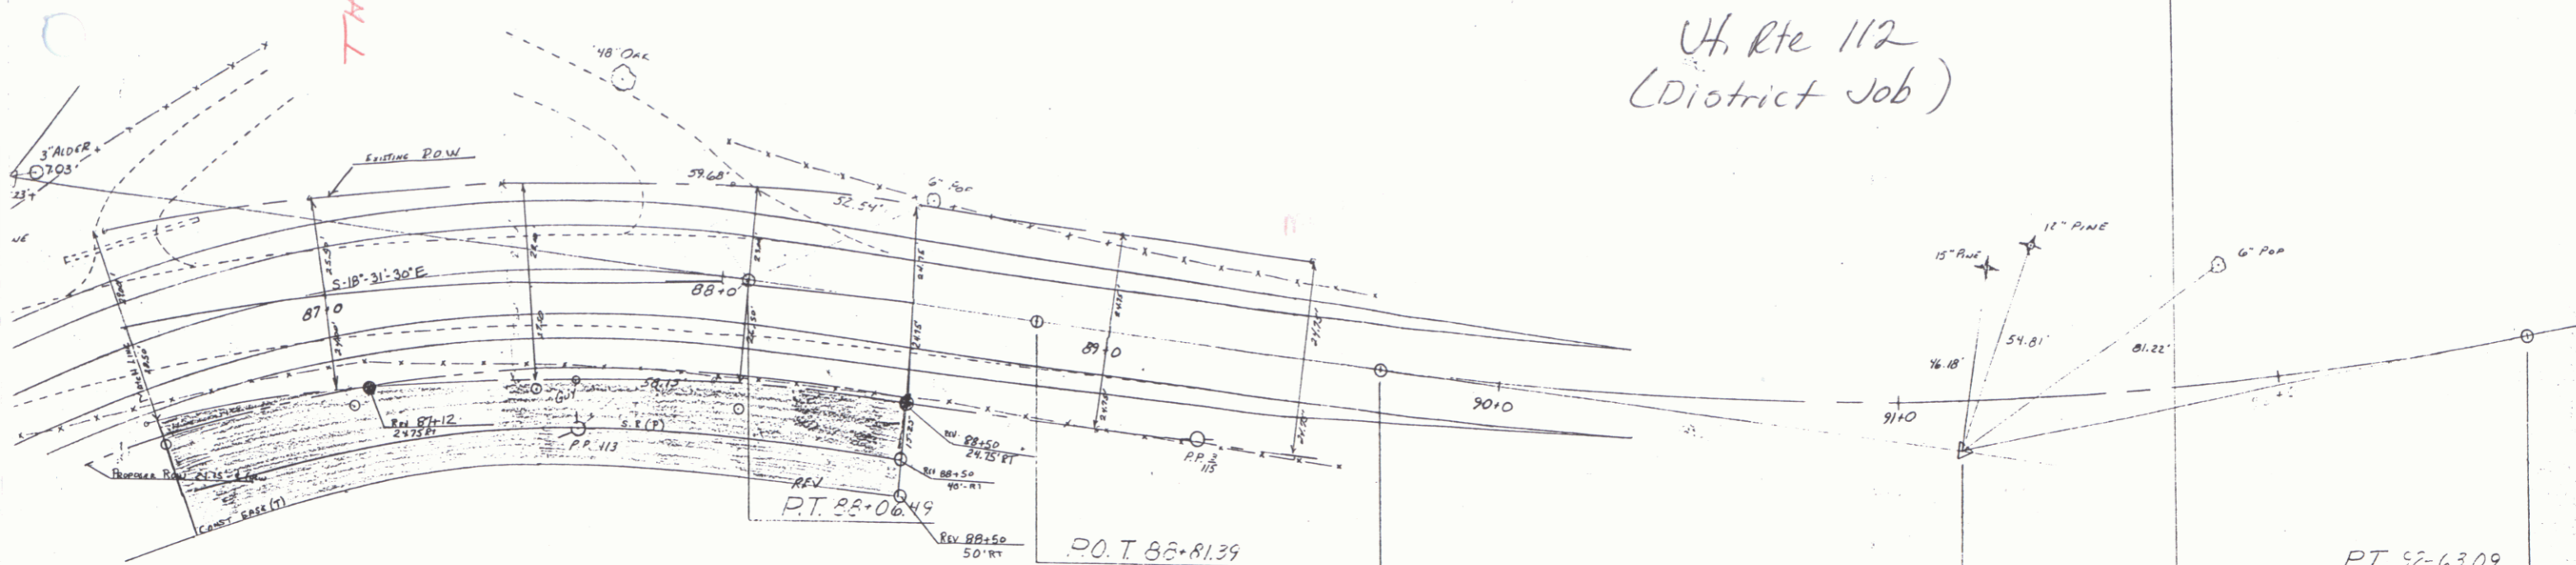

Δ 60°-51' Rt  
D 18°-0'  
R 318.31  
T 186.94  
L 338.06  
E 50.83

Δ 19°-02'-30' Lt  
D 6°-30'  
R 881.46  
T 147.83  
L 292.95  
E 12.31

P.T. 92-63.09  
RIGHT-OF-WAY DIVISION  
TOWN FILE  
PERPETUAL

Town of \_\_\_\_\_  
(To Be Returned To R.O.W. Division)

