


INDEX OF SHEETS

1. TITLE SHEET
2. QUANTITY SHEET
3. SUPERSTRUCTURE DETAILS
4. SUPERSTRUCTURE AND APPROACH SLAB DETAILS
5. ABUTMENT DETAILS
6. PIER DETAILS
7. REINFORCING SCHEDULE
8. STD. DWG. SCB-D6-67 DET. A, DET. D, Apr. 28, 70R.
9. STD. DWG. SB-R4-69 Apr. 15, 71R
10. STD. DWG. E-16 Dec. 18, 64 R
11. STD. DWG. E-33 MAY 6, 71 R
12. STD. DWG. E-34 MAY 6, 71 R
13. STD. DWG. G-1b Apr. 29, 70R
14. STD. DWG. E-36 MAY 6, 71 R
15. SERIES F No. 104-A, Sh. 21 of 28  
(FOR REFERENCE ONLY)

FOR GENERAL NOTES SEE SH. 4  
RECORD PLANS  
BRIDGE WIDENING


GRAVEL BACKFILL FOR STRUCTURES—WOODARD CONST. CO., PIT  
—ARLINGTON, VT.  
POLYURETHANE JOINT SEALER, EPOXY BONDING COMPOUND &  
EPOXY MORTAR COMPOUND—DURAL  
INTERNATIONAL CORP.—DEER PARK, N.Y.  
CONCRETE CLASS AA & B—WILLIAM E.  
DAILEY, INC.—N. BENNINGTON, VT.  
REINFORCING STEEL—PIONEER VALLEY STEEL CO., INC.—GREENFIELD, MA.  
STRUCTURAL STEEL—BENNINGTON IRON WORKS, INC.—BENNINGTON, VT.  
PRESTRESSED CONCRETE MEMBERS—UNISTRESS CORP.—PITTSFIELD, MA.  
WATER REPELLENT—C. L. WHITE, INC.—  
BENNINGTON, VT.  
BOX BEAM GUARD RAIL & BRIDGE RAILING—O.W.  
HUBBELL & SONS, INC.—NEW HARTFORD, N.Y.  
CONCRETE W/ LATEX MODIFIER—W.E. DAILEY, INC.—SHAFTSBURY, VT.  
CONTRACTOR  
W.H. MORSE CONSTRUCTION CO.  
BENNINGTON, VT.  
RESIDENT ENGINEER—E.M. GIPSON, JR.  
RECORD PLANS—A.G. SPIDLE.  
CONTRACT  
DATED—AUGUST 10, 1971.  
STARTED—SEPTEMBER 2, 1971  
COMPLETED—SEPTEMBER 15, 1972  
ACCEPTED—SEPTEMBER 15, 1972.

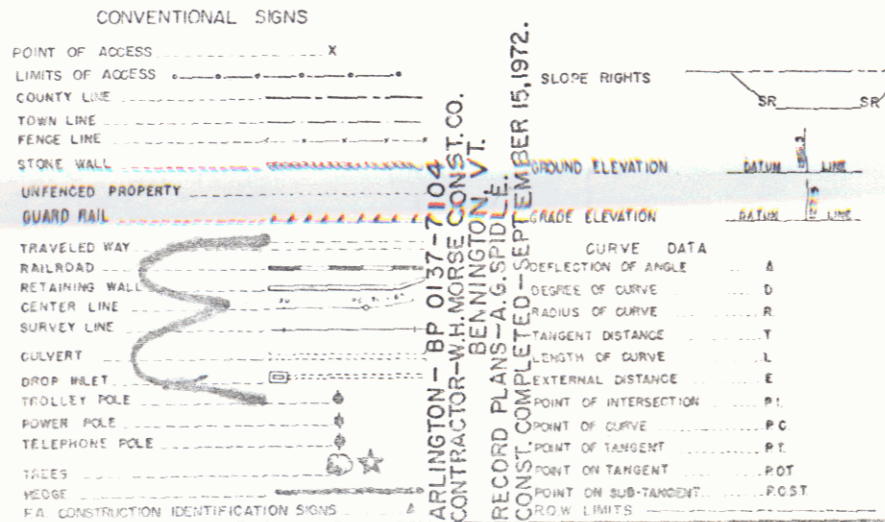

STATE OF VERMONT  
DEPARTMENT OF HIGHWAYS  
PROPOSED IMPROVEMENT

TOWN OF ARLINGTON  
VT Rte. 7A OVER BATTEN KILL (Br#16)

BEGINNING AT A POINT ON U.S. Rte 7 0.39 MILES SOUTH OF THE SUNDERLAND TOWN LINE AND CONTINUING SOUTH FOR 201.08 FT. PROJECT TO CONSIST OF WIDENING THE BRIDGE CARRYING U.S. Rte. 7 OVER THE BATTEN KILL AND ALL WORK NECESSARY TO ACHIEVE THIS, HAVING THE ENTIRE DECK, AND WIDENING AND FIXING THE BRIDGE APPROACH SLABS.

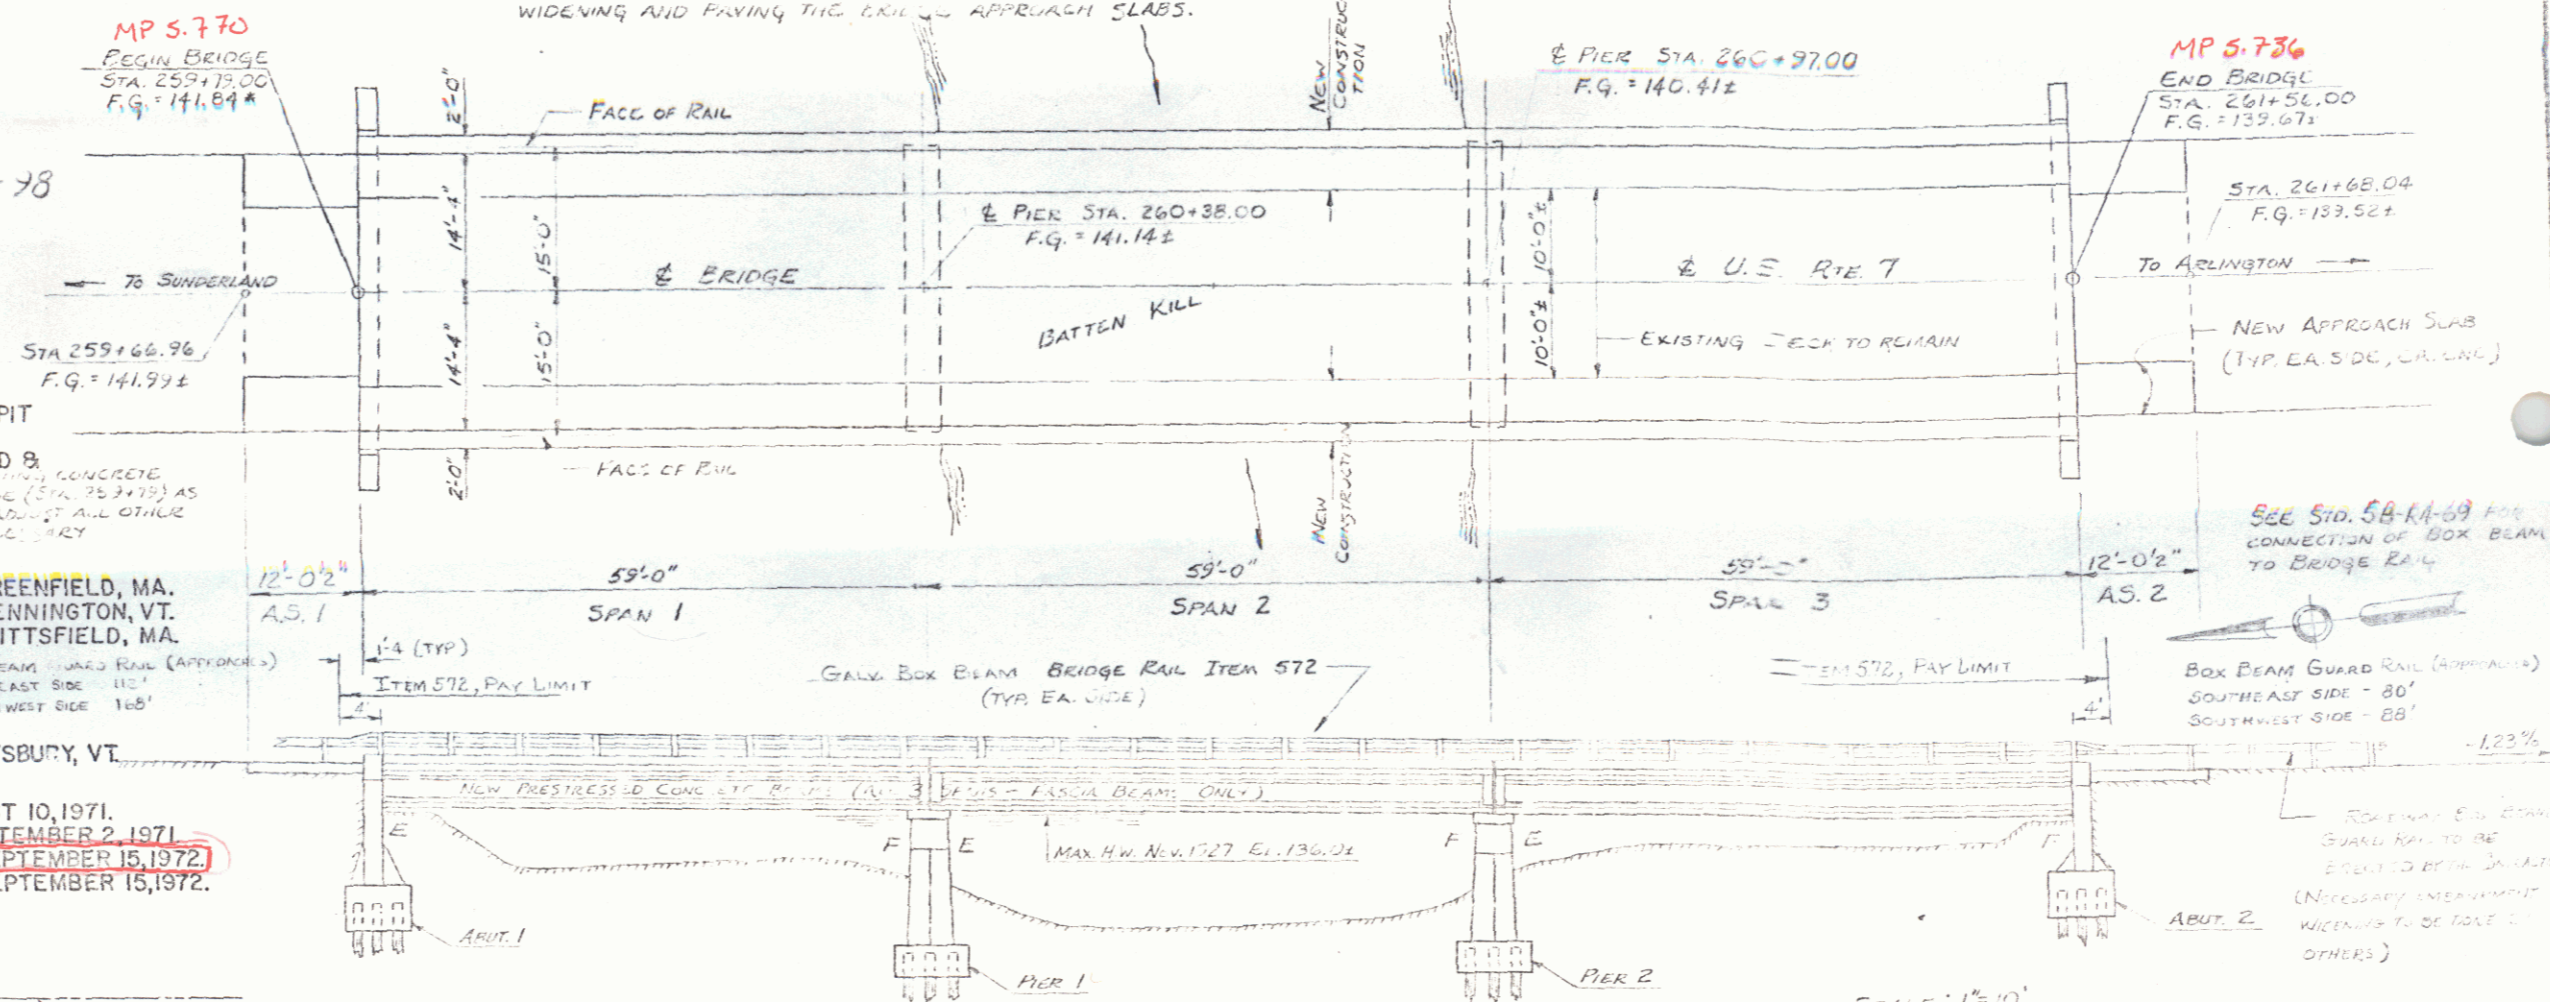

STATIONS AND FINISH GRADE ELEVATIONS ARE REFERENCED TO DATA AS SHOWN ON SH. 11—SERIES F No. 104-A, Sh. 21 of 28

NOTE: ANY DIMENSIONS OR FINISH ELEVATIONS SHOWN ON THESE PLANS SHALL BE CHECKED AGAINST EITHER THE FIELD BOOKS OR THE ESTIMATE FILE.

THESE PLANS ARE SUBJECT TO REVISIONS AS MAY BE REQUIRED BY THE COMMISSIONER OF HIGHWAYS.  
CONSTRUCTION IS TO BE ACCORDANCE WITH THESE PLANS AND THE STANDARD SPECIFICATIONS FOR HIGHWAY AND BRIDGE CONSTRUCTION DATED APRIL 1964, AS AMENDED BY THE BOARD OF PUBLIC ROADS ON OCTOBER 12, 1964. ALL SUBSEQUENT APPROVED REVISIONS AND SUCH SPECIAL PROVISIONS AND SPECIAL PROVISIONS AS ARE INCORPORATED IN THESE PLANS.

APPROVED _____ DISTRICT ENGINEER	APPROVED _____ CONSTRUCTION ENGINEER	APPROVED _____ BRIDGE ENGINEER	APPROVED _____ TRUCK ENGINEER	APPROVED _____ ASSISTANT ENGINEER	APPROVED _____ CHIEF ENGINEER
DATE _____	DATE _____	DATE _____	DATE _____	DATE _____	DATE _____

Town of ARLINGTON  
Section Supervisor: J. P. SHATTUCK  
Drawn by: J. F. SHATTUCK  
Checked by: J. TRIPP 12/67  
PROJECT BR No. 0157-70A  
SHEET 1 OF 1 SHEETS