


Water Main (4" C.I.P.)
Hit at Following Locations

| Sta. | 1/16 | 1/8 | 1/4 |
|-------|----------|----------|-----|
| 12+15 | 12+13.63 | 12+12.87 | |
| 14+10 | 14+10.33 | 14+11.17 | |
| 16+00 | 15+11.87 | 15+12.71 | |

Legend:
Boundary Markers []

Drives Constructed
Sta. Position
14+15 Kt.
22+00 Ac.

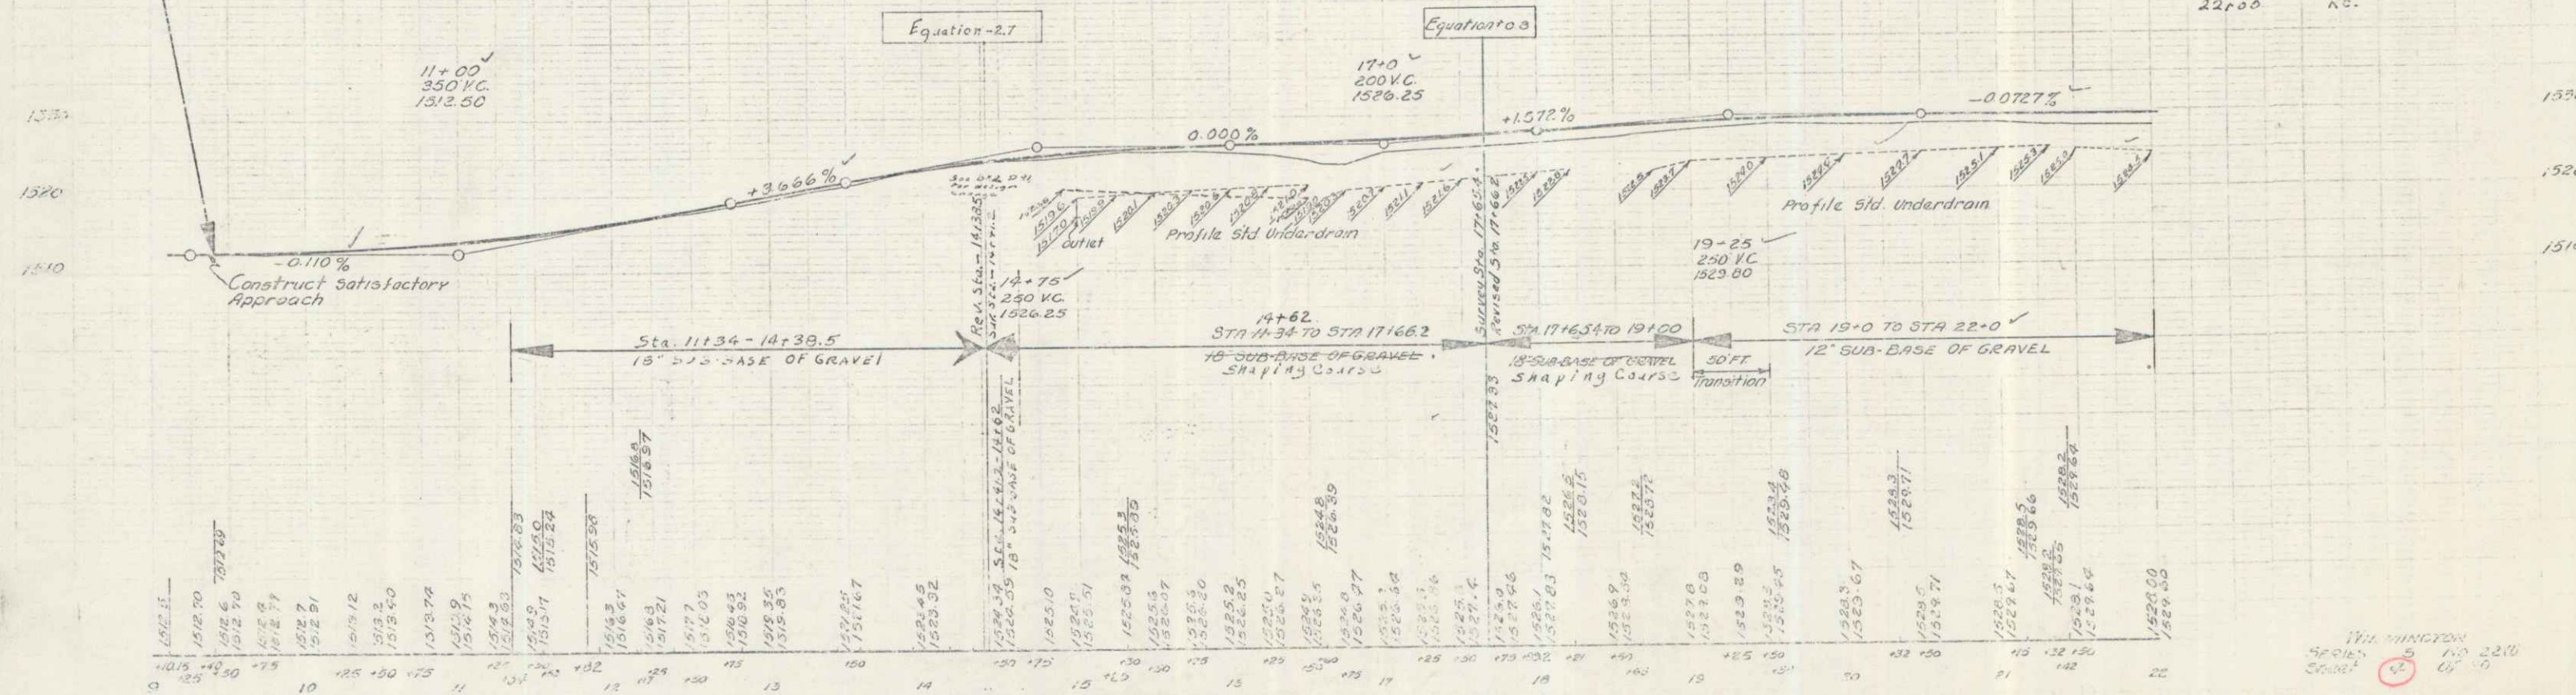

Sta. 3 Elev. 1519.12 Spot on Conc. Gas Found 22 ft from Sta 11+22
BM #4 Elev. 1531.31 Spot on Boulder 24.5 ft. N. Sta. 21+24

WILMINGTON
5621
22(1) 1946 4 30