



E.S. BARRETT
22 N. ROSELAND
WILM.

E.S. BARRETT
22 N. ROSELAND
WILM.

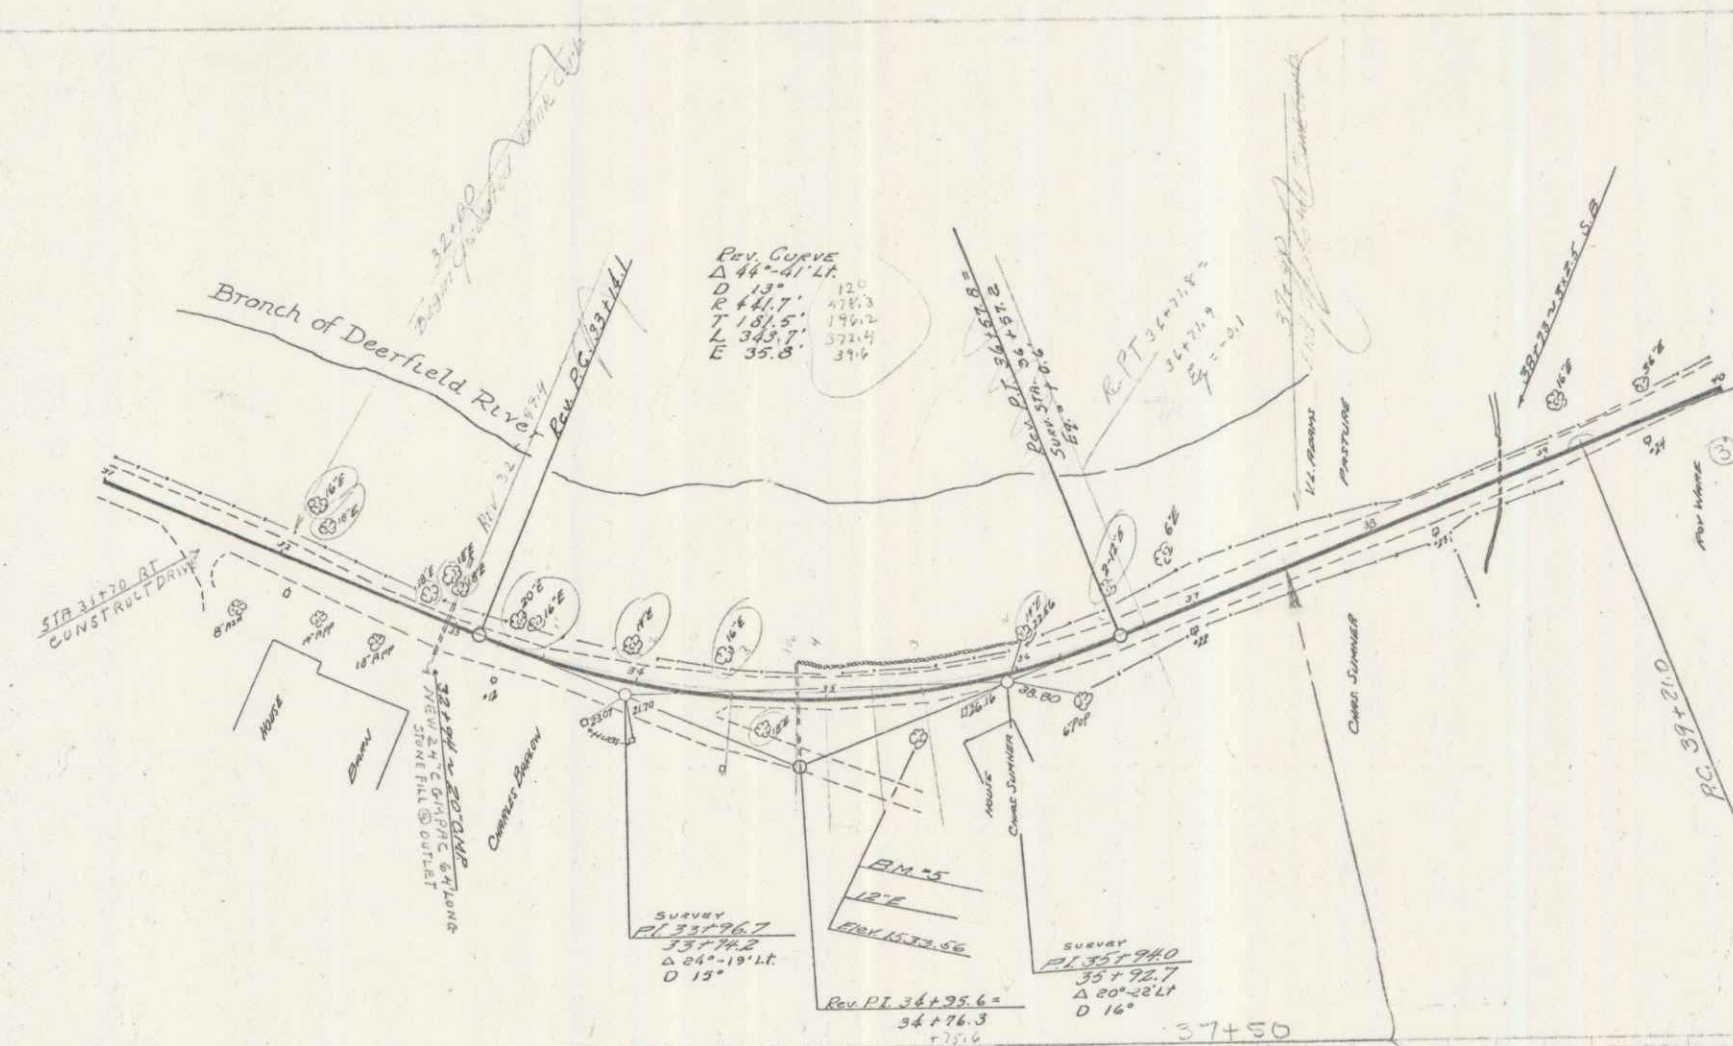

37+50
-9
28750
8000
37100

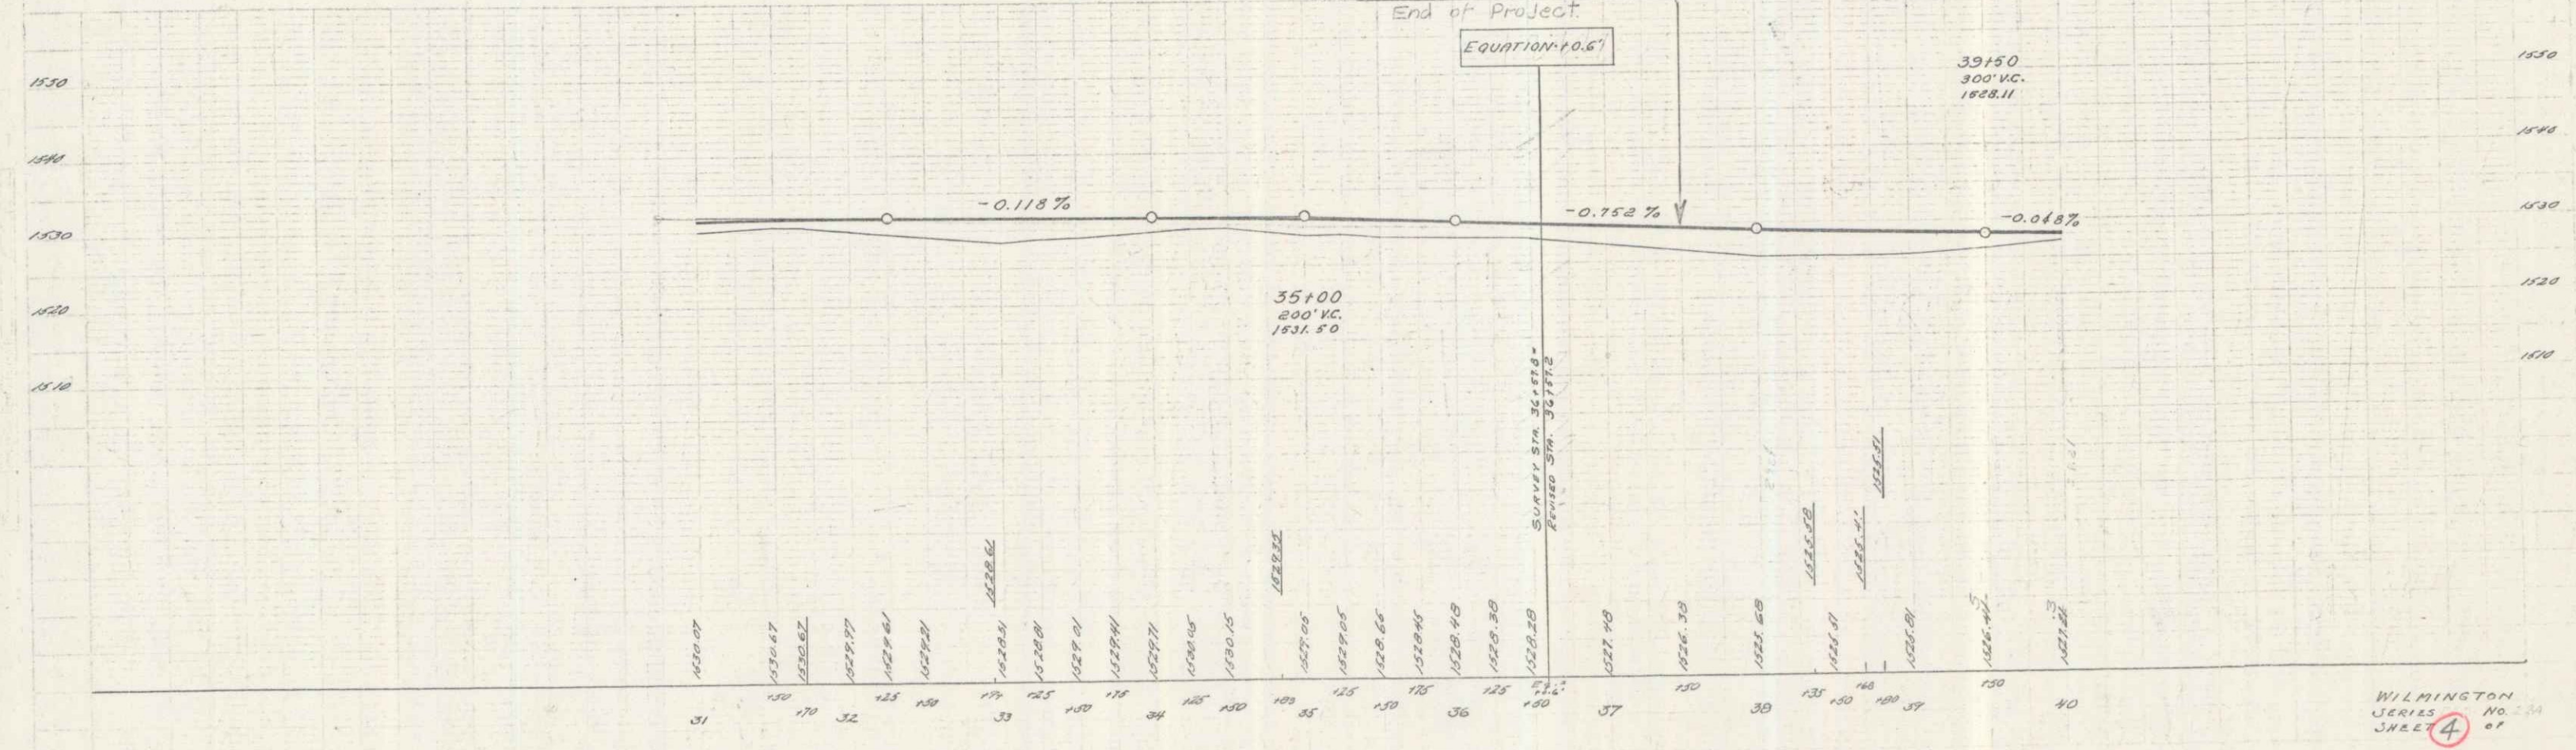

WILMINGTON
SERIES NO. 234
SHEET 4 OF 4