


E.S. ROBERTS
E.R. ROGERS
JUL 26
1926

E.S. ROBERTS
E.R. ROGERS
JUL 26
1926


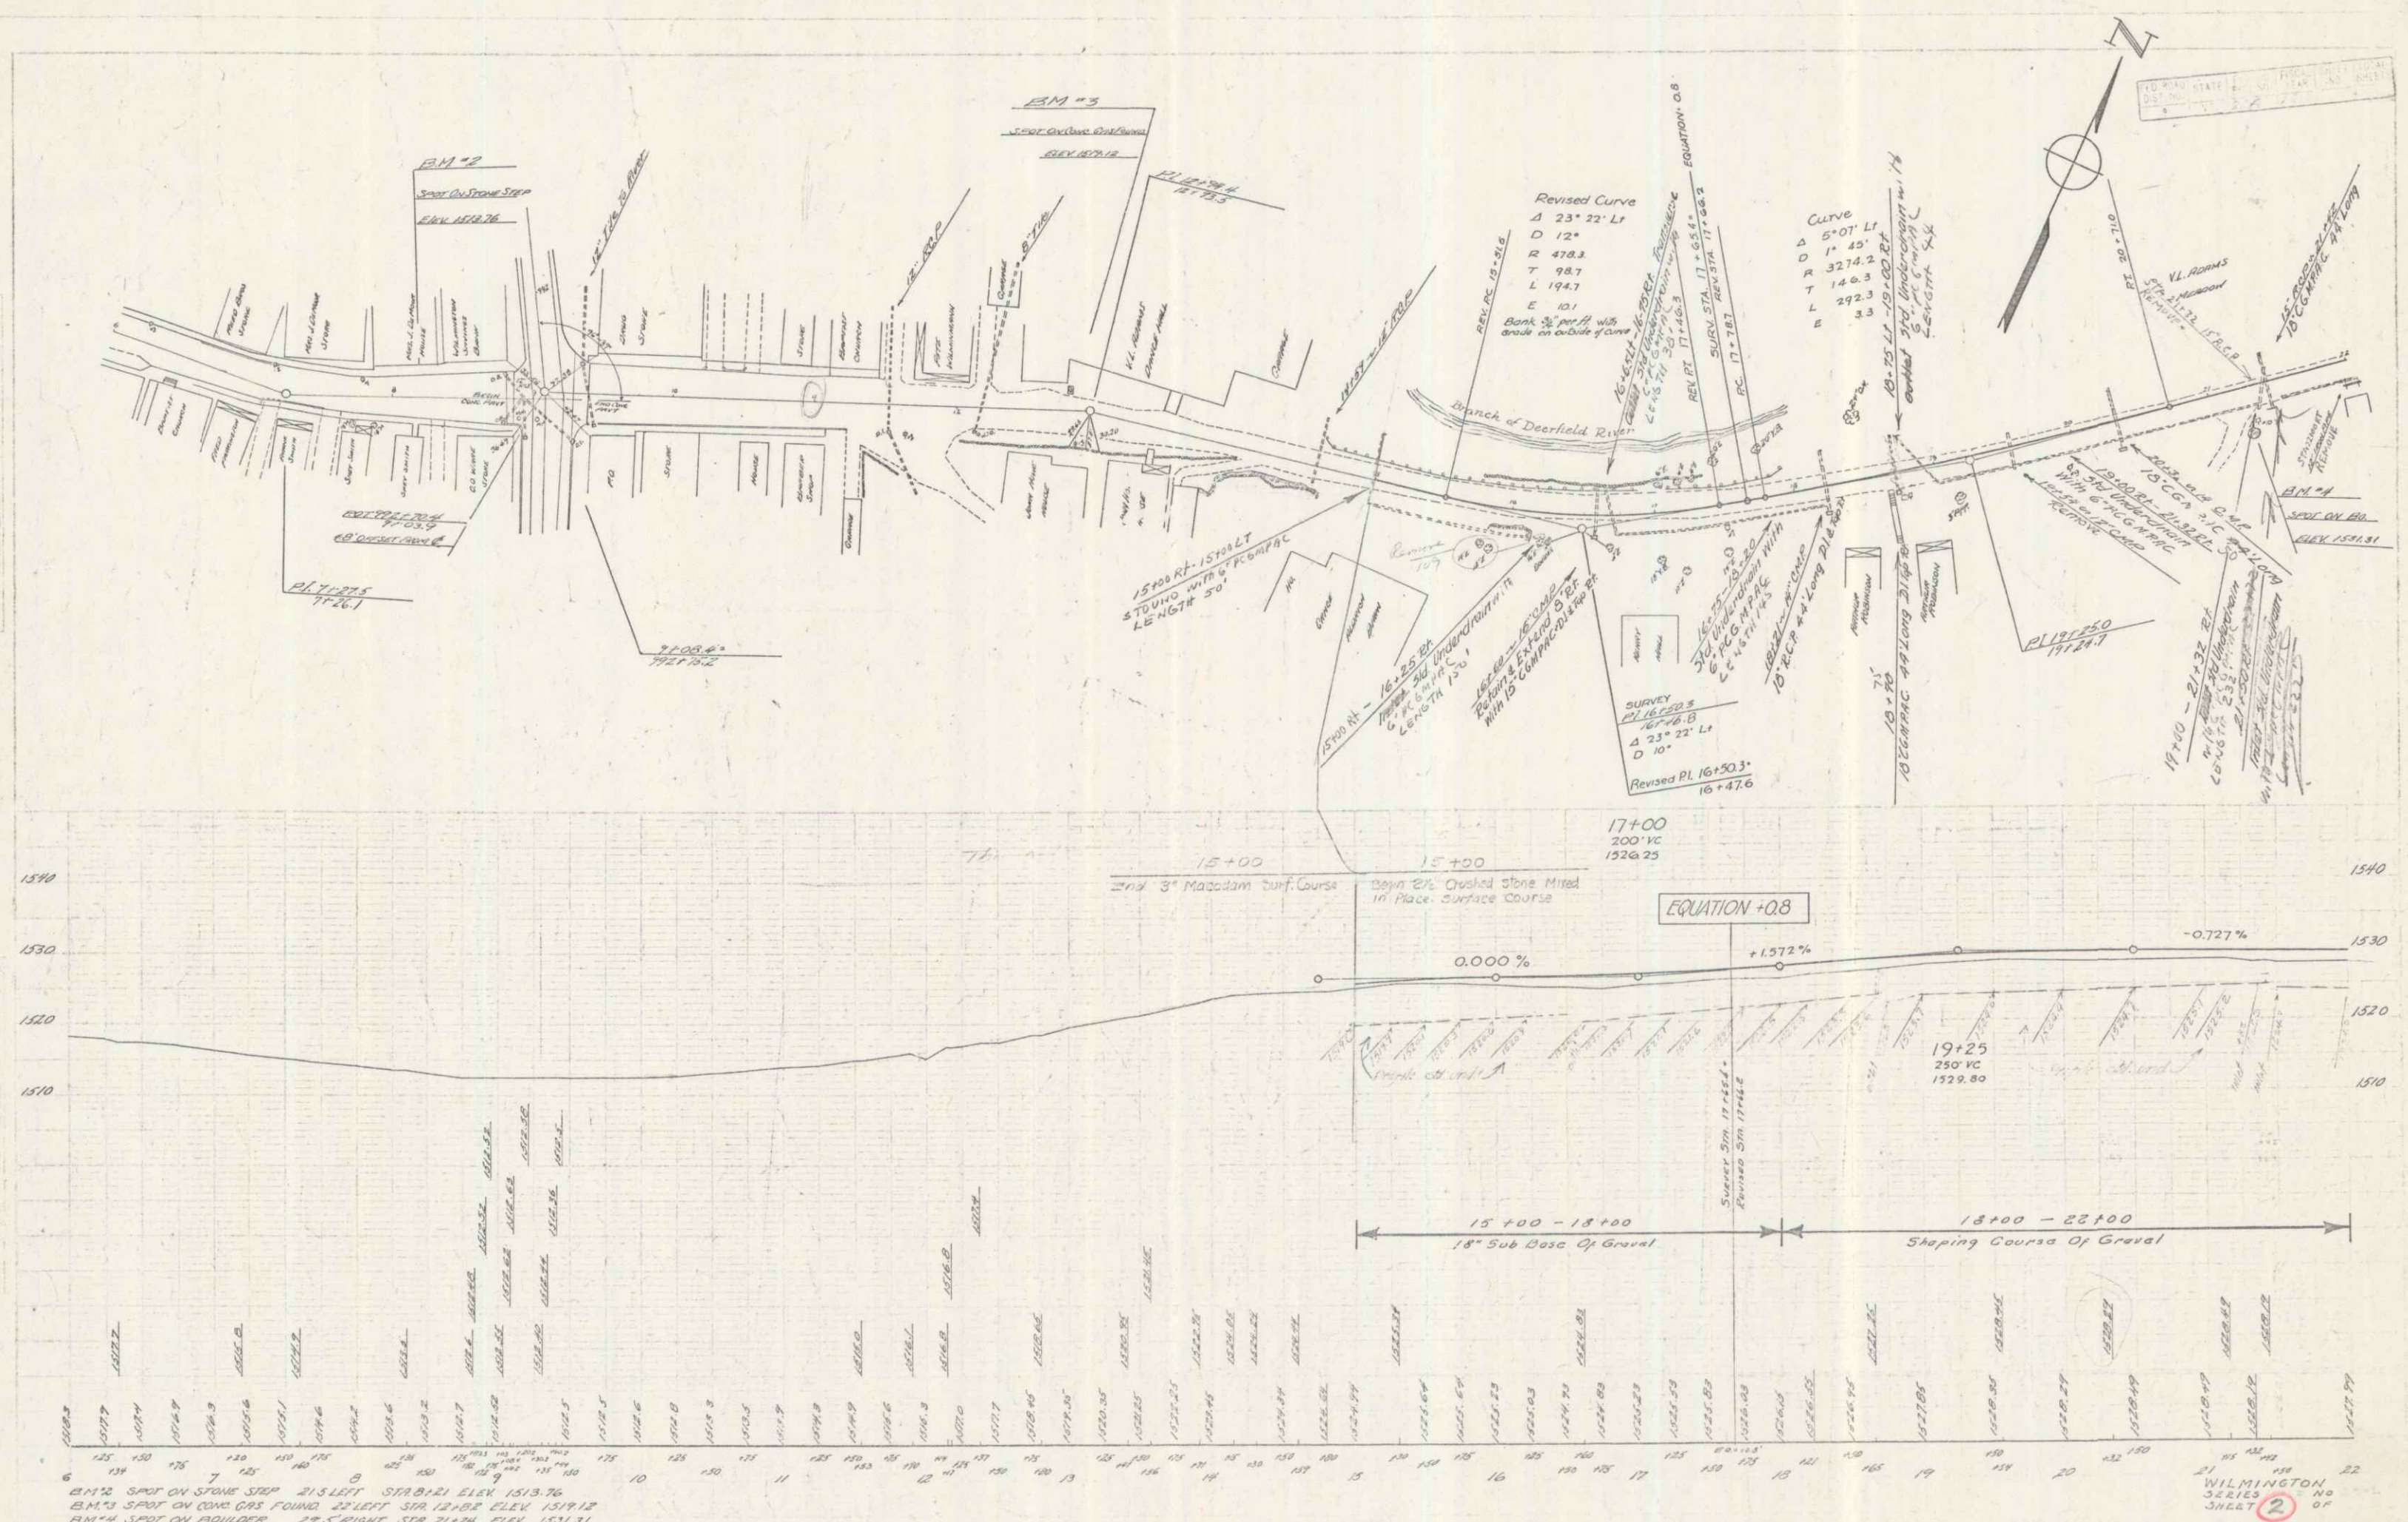


STATE OF MASSACHUSETTS
DEPARTMENT OF HIGHWAYS
PROJECT NO. 1000
SHEET NO. 2

WILMINGTON NO. 2
SERIES 1000
SHEET 2 OF 2

WILMINGTON SERIES No. 3 OF SHEET 3


F. S. BARRETT JUNIOR

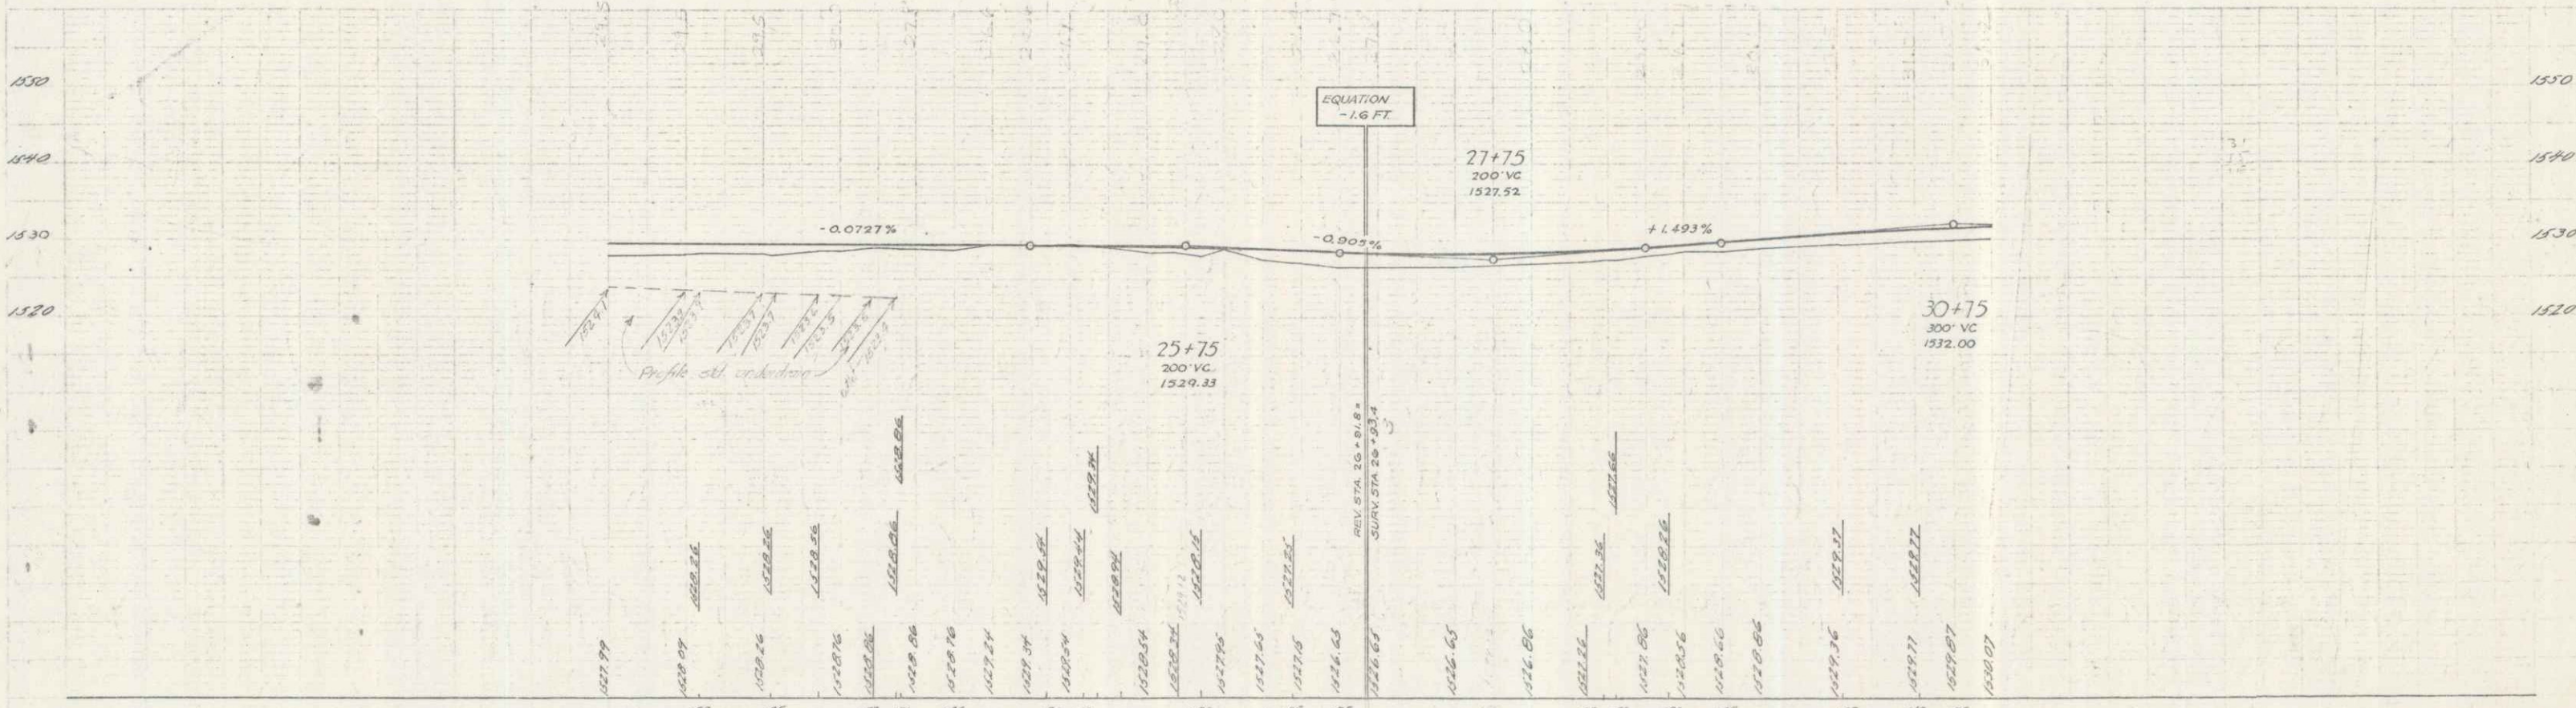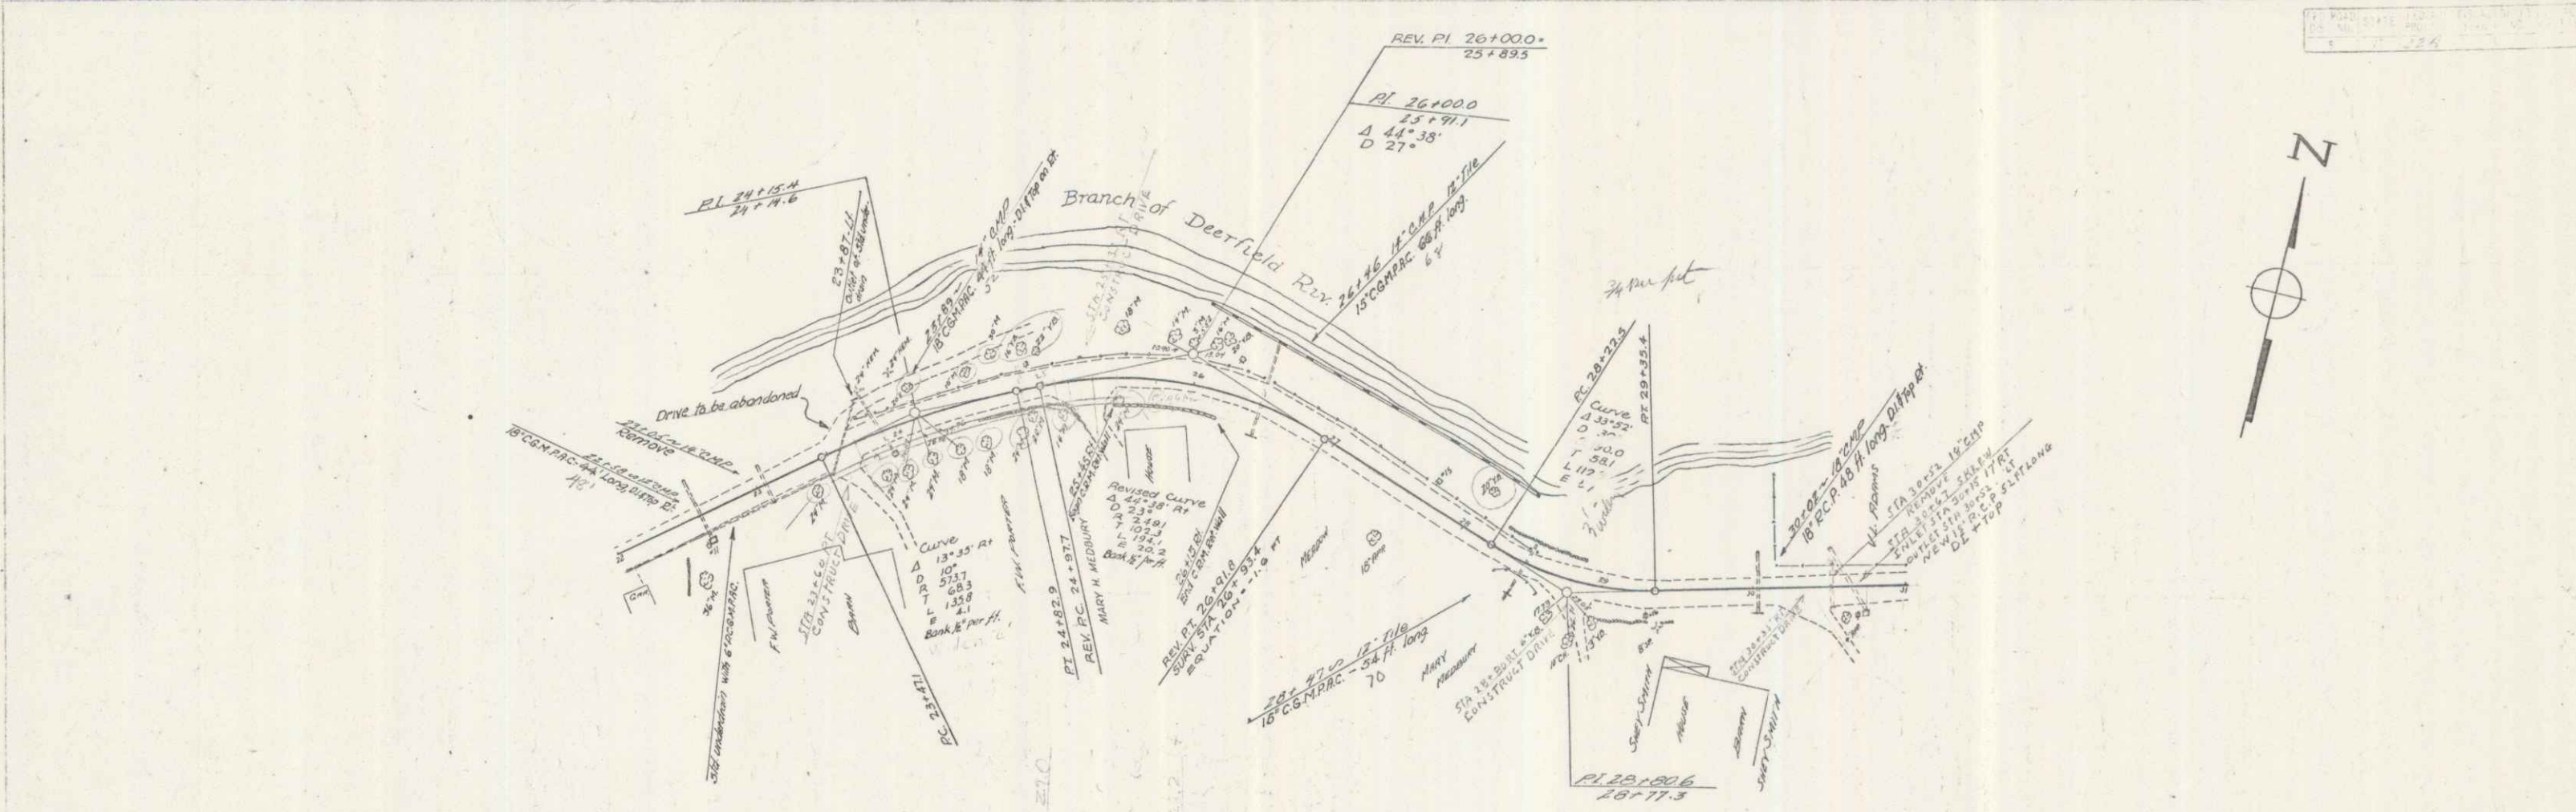


WILMINGTON SERIES No. 3 OF SHEET 3

E.S. BARRETT
224 ROGERS
S.W.M.
1914

E.S. BARRETT
224 ROGERS
S.W.M.
1914

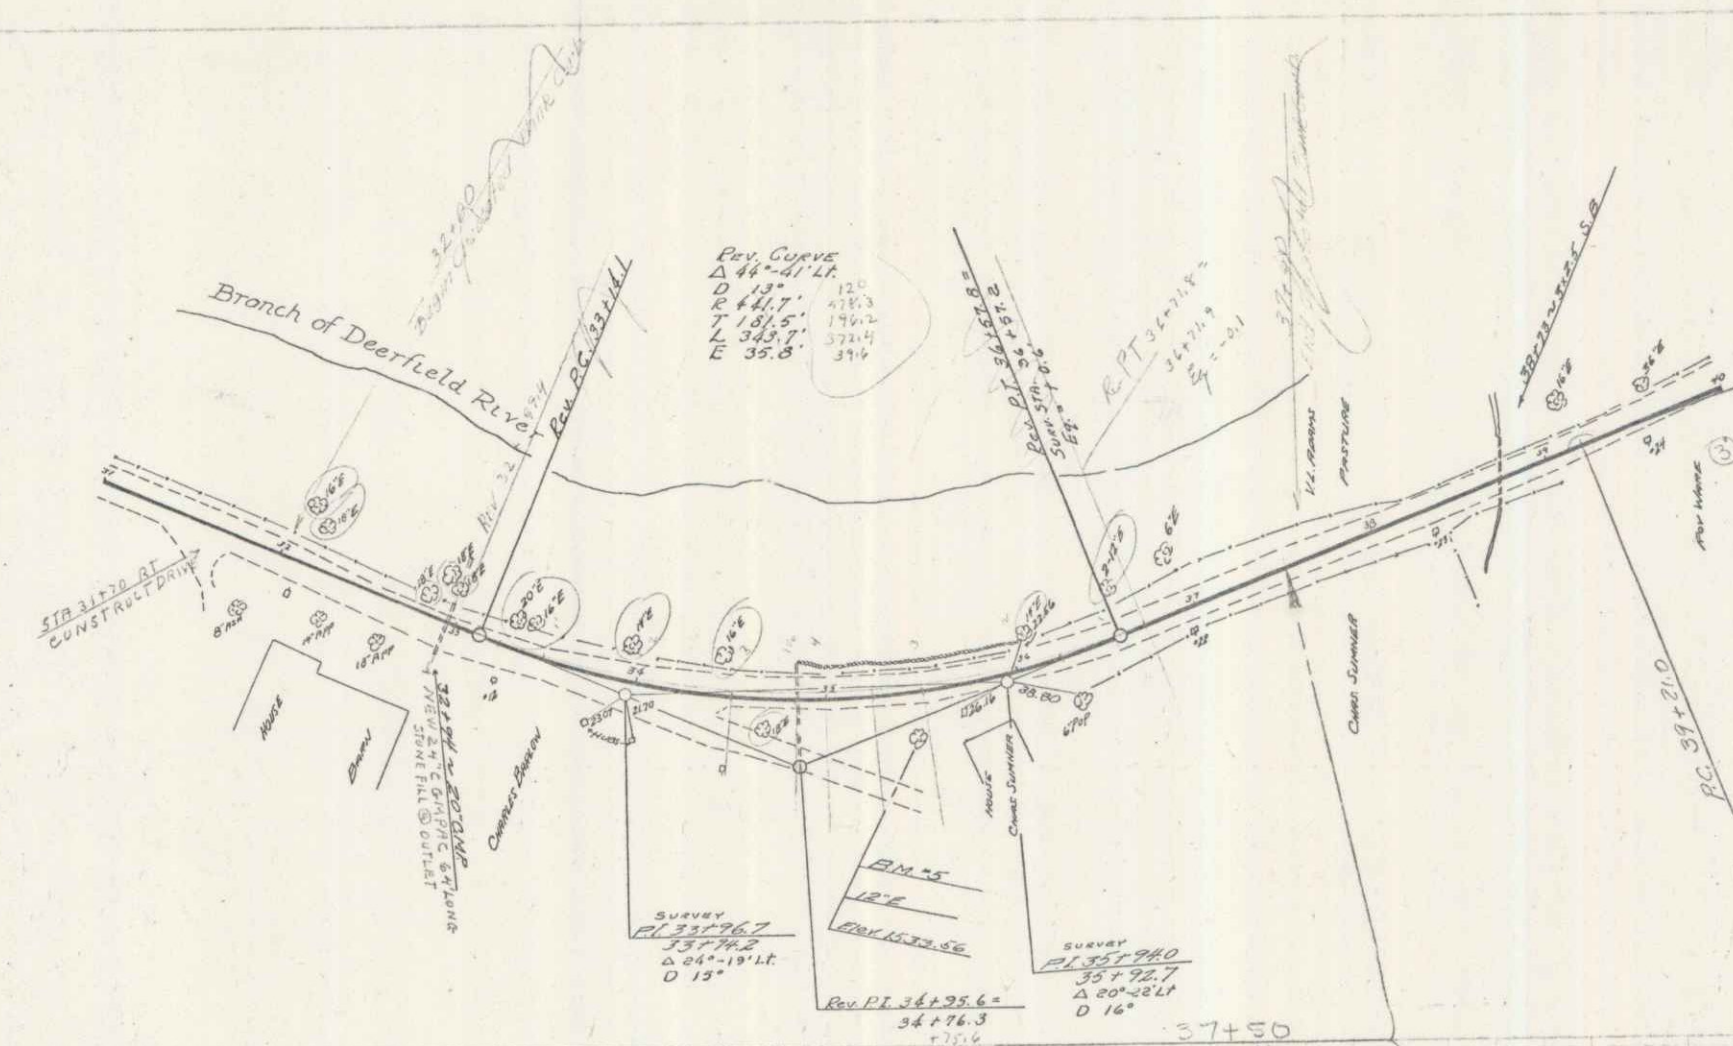

37+50
-9
28750
8000
37100


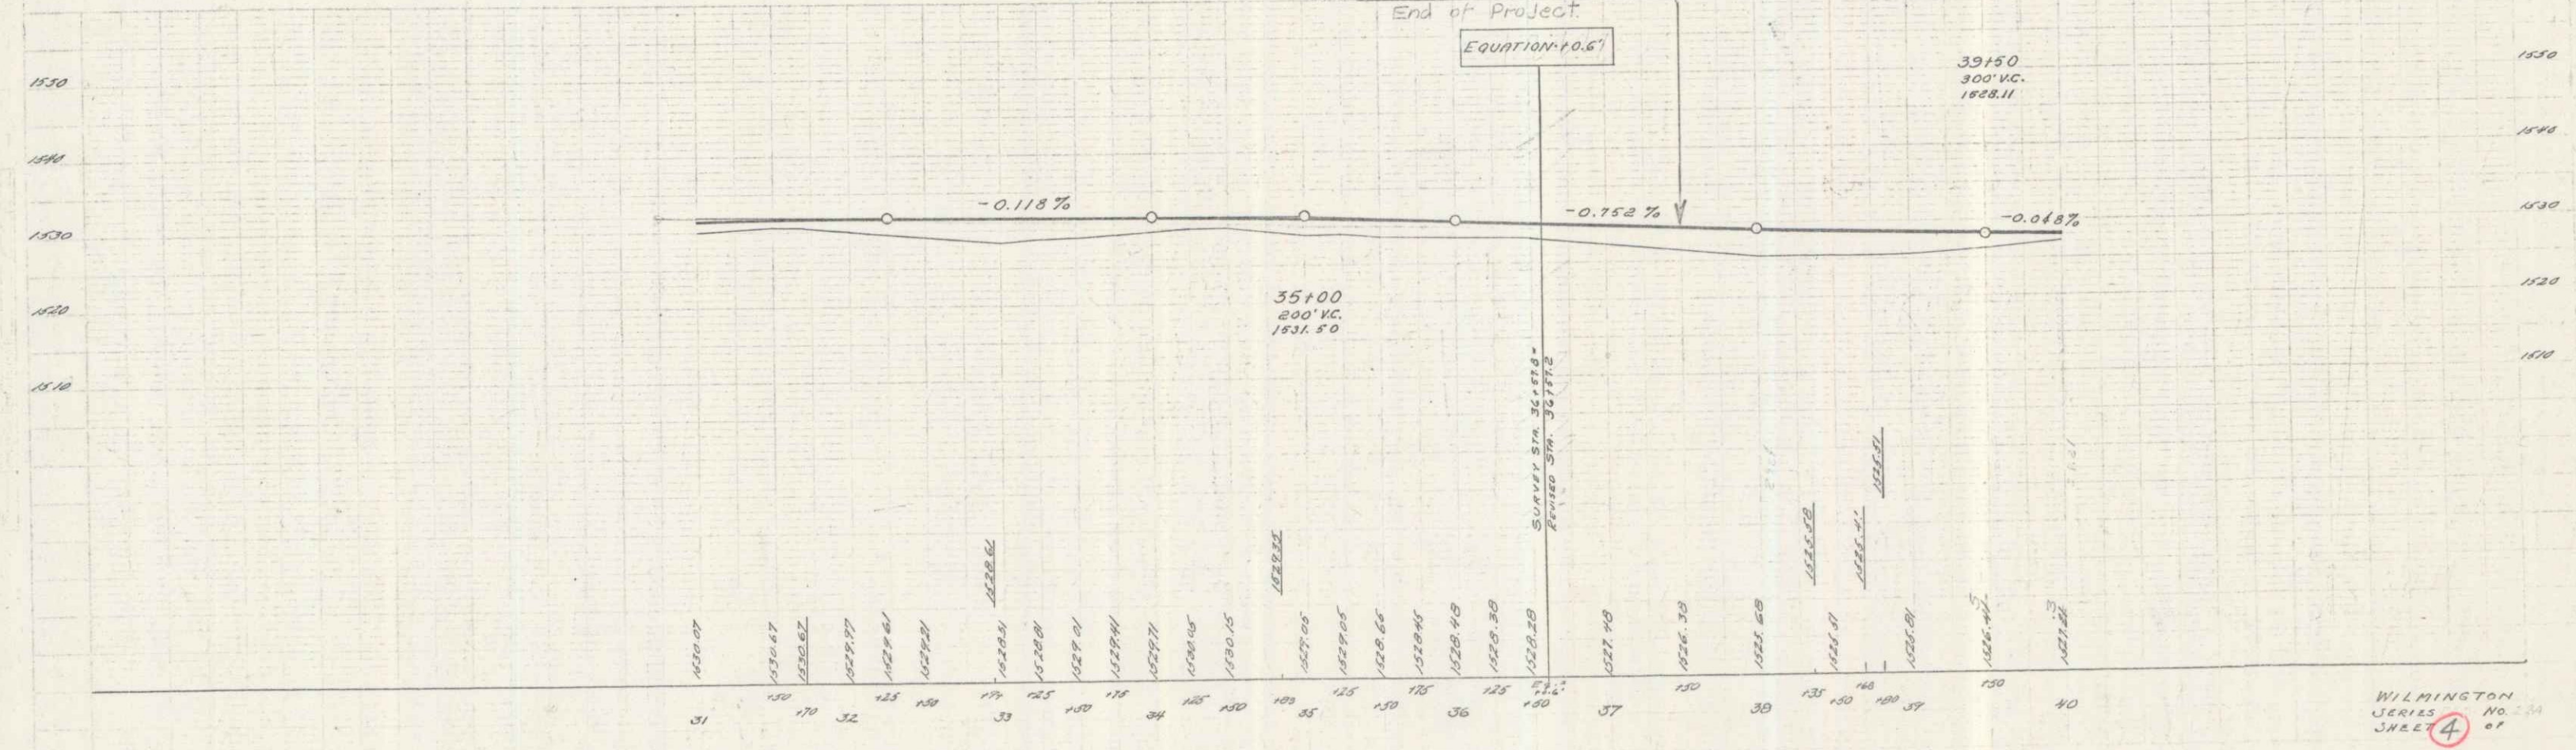


WILMINGTON
SERIES NO. 234
SHEET 4 OF 4

F.S. BARRETT
E.R. ROGERS

F.S. BARRETT
E.R. ROGERS

Δ 14-0817
D 1-95
K 329.2
T 405.7
L 007.6
E 250.

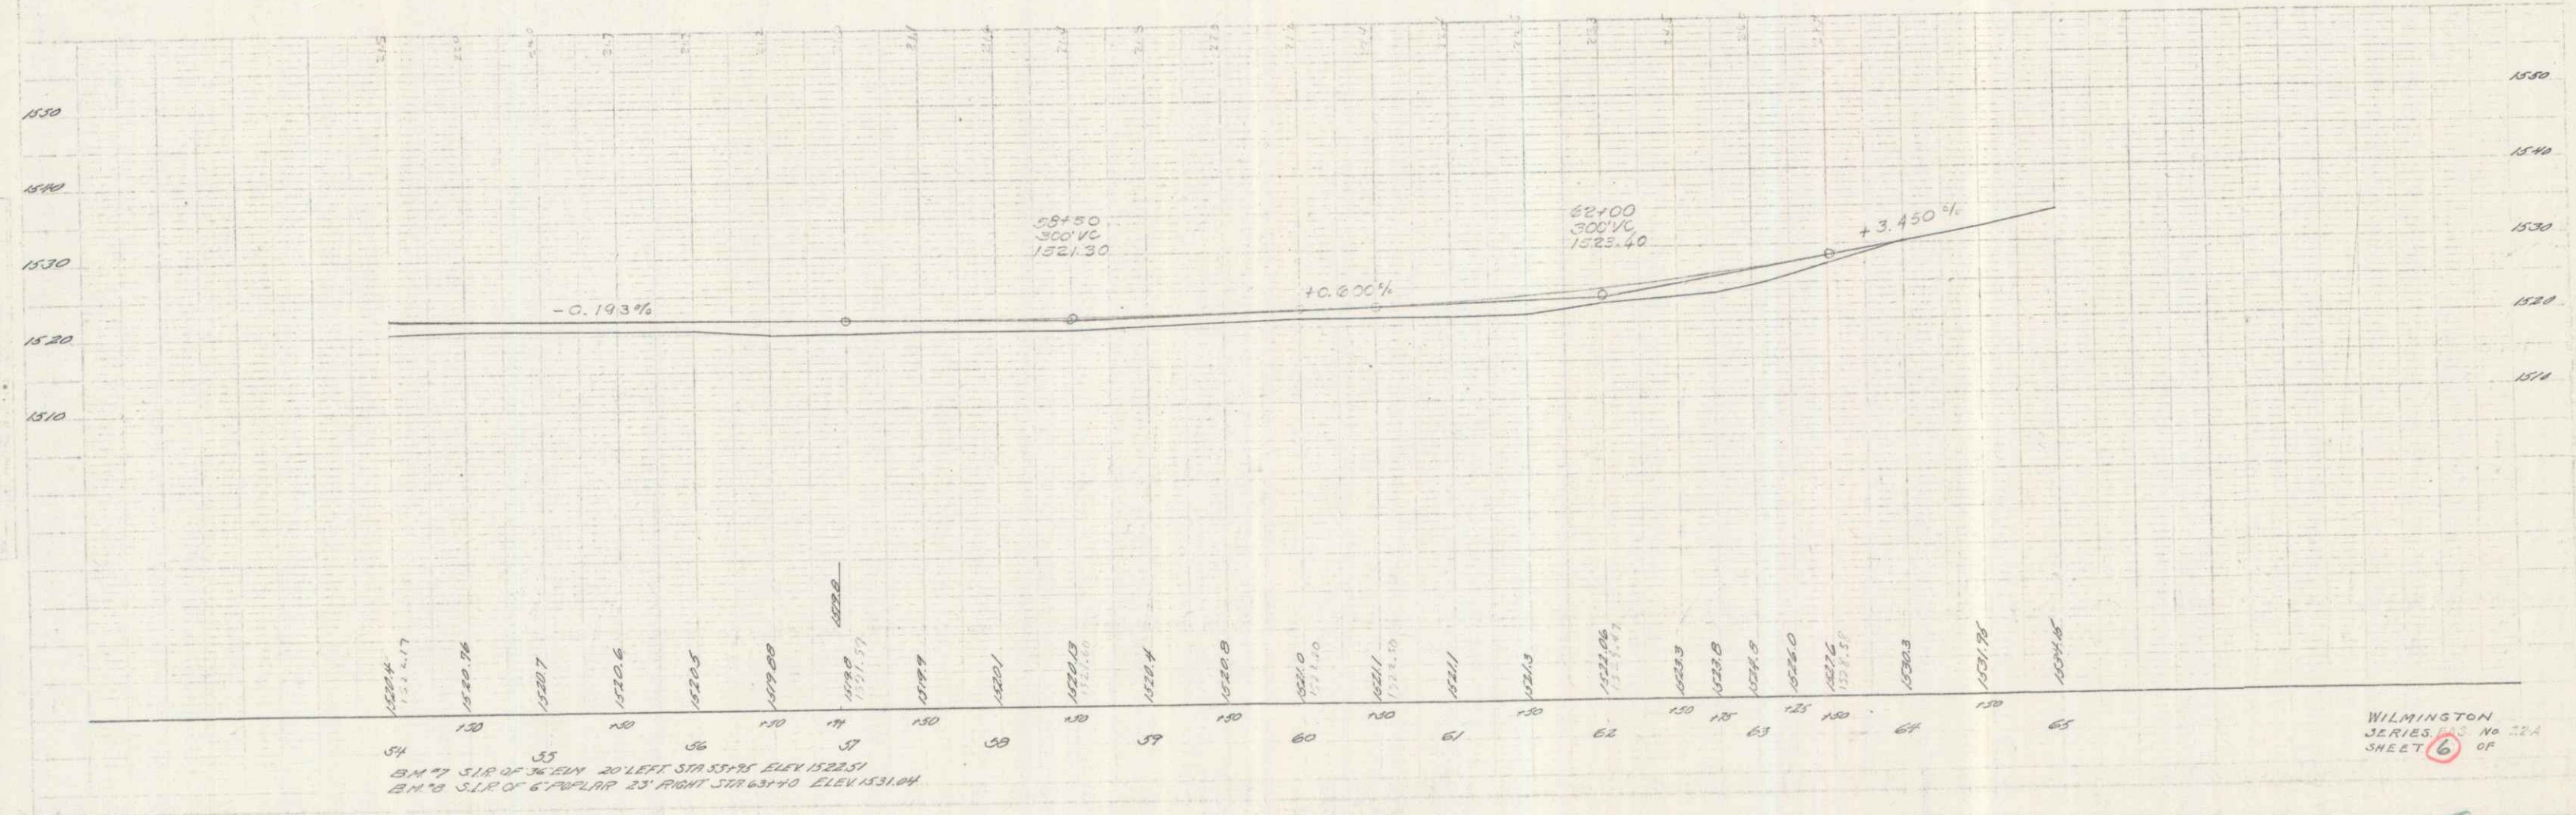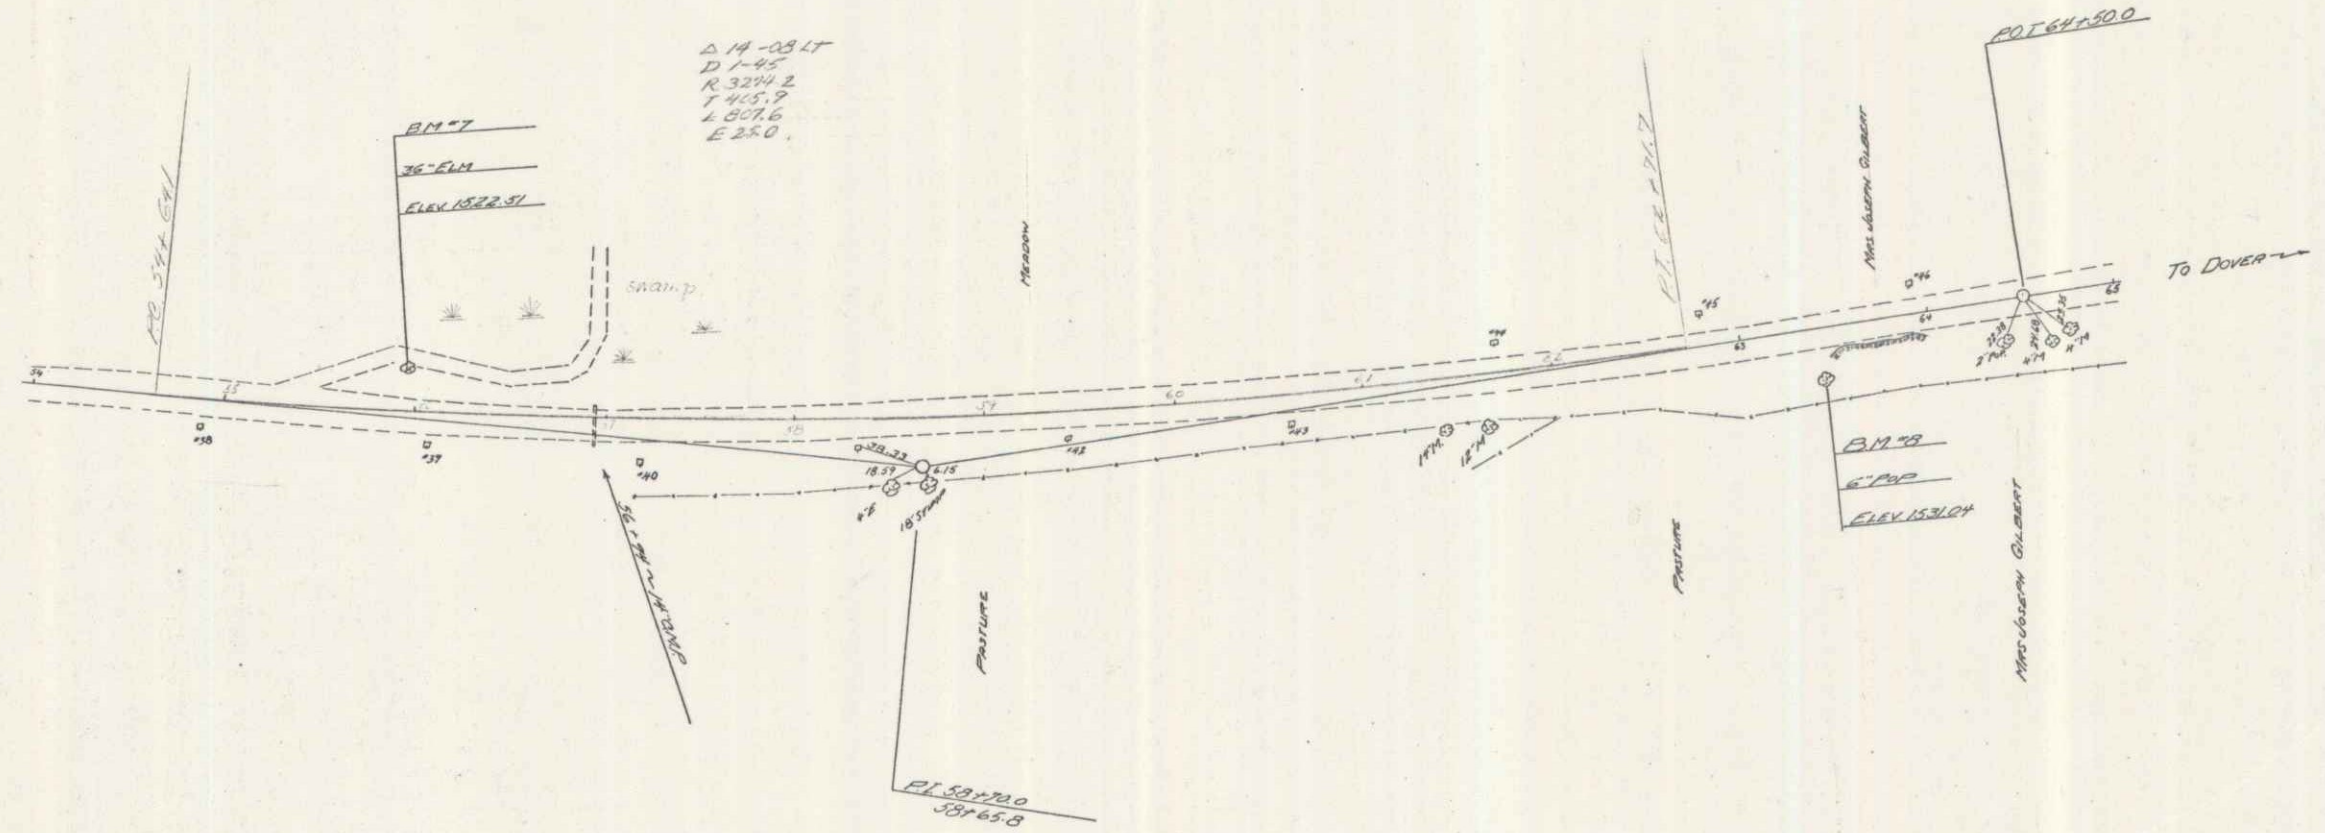

54 BM 7 SUR OF CURB 20' LEFT STA 55+75 ELEV 1522.51
55
56
57
58
59
60
61
62
63 BM 8 SUR OF CURB 25' RIGHT STA 63+10 ELEV 1523.40
64
65