



PLAN
 DRAWN BY
 CHECKED BY
 DATE
 NOTE BOOK
 NO. OF PAGES CHECKED
 10

Sta 33+0-51+0 Lt.
 Poor foundation material (Muck)
 to be disposed of as directed by
 the Engineer.

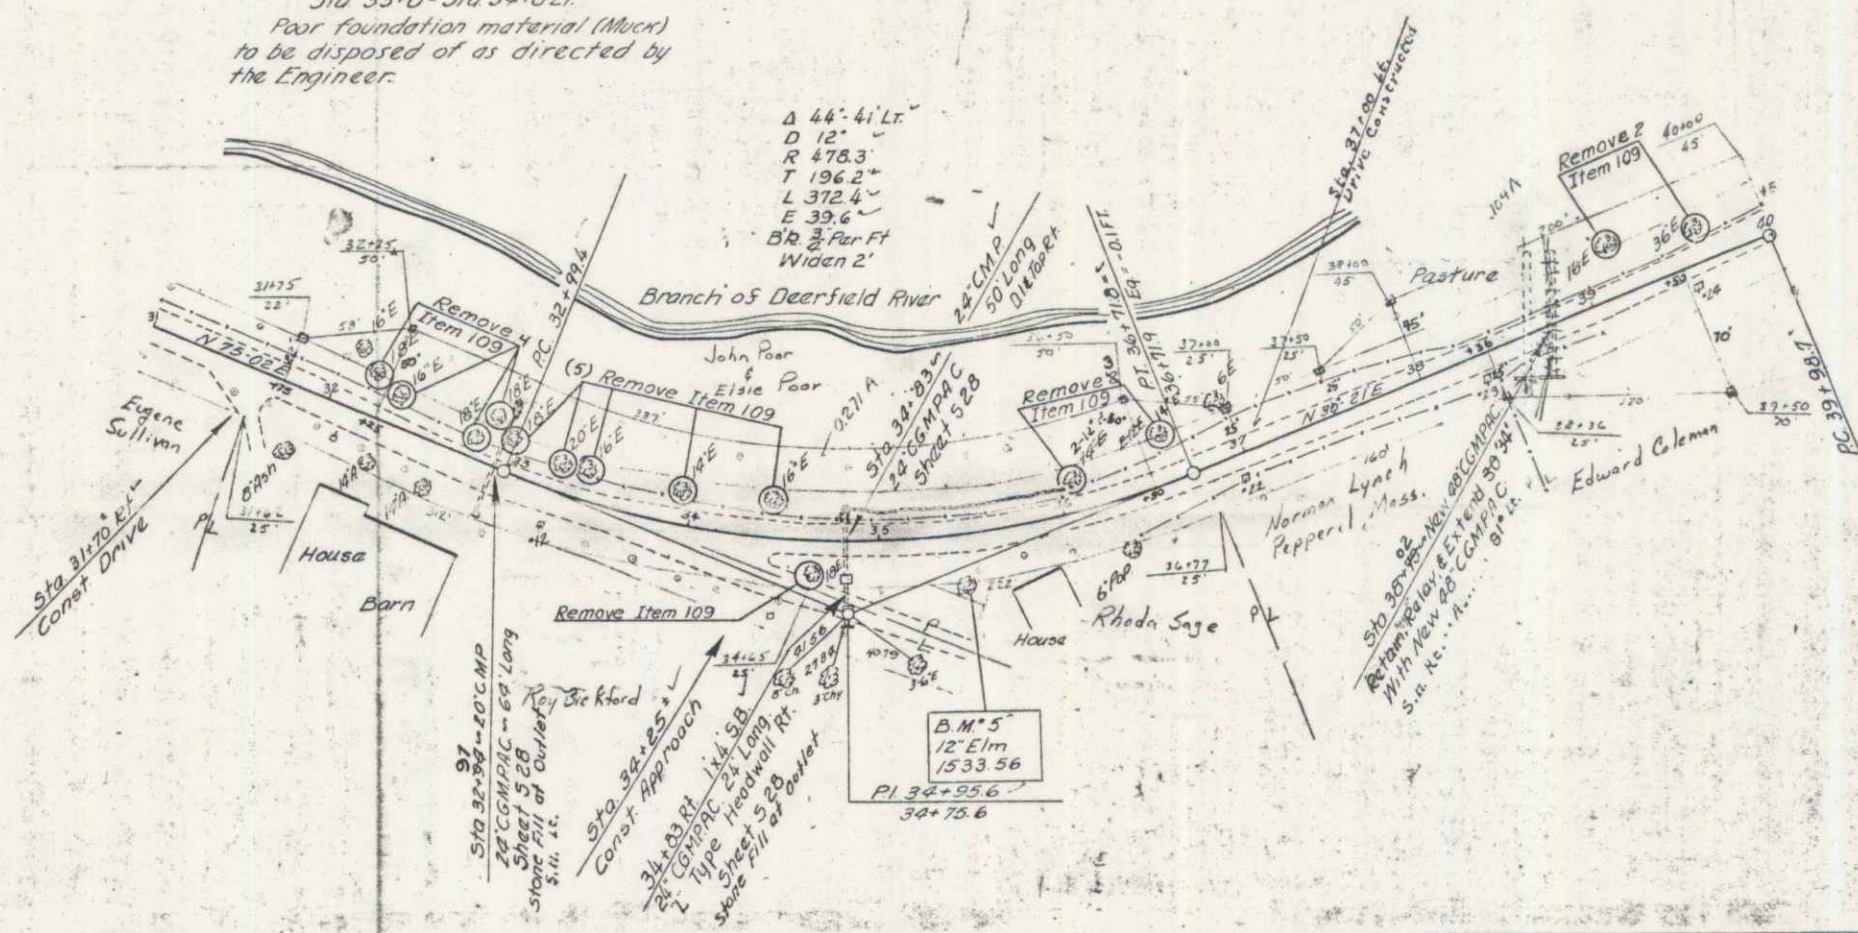

PLAN
 DRAWN BY
 CHECKED BY
 DATE
 NOTE BOOK
 NO. OF PAGES CHECKED
 10

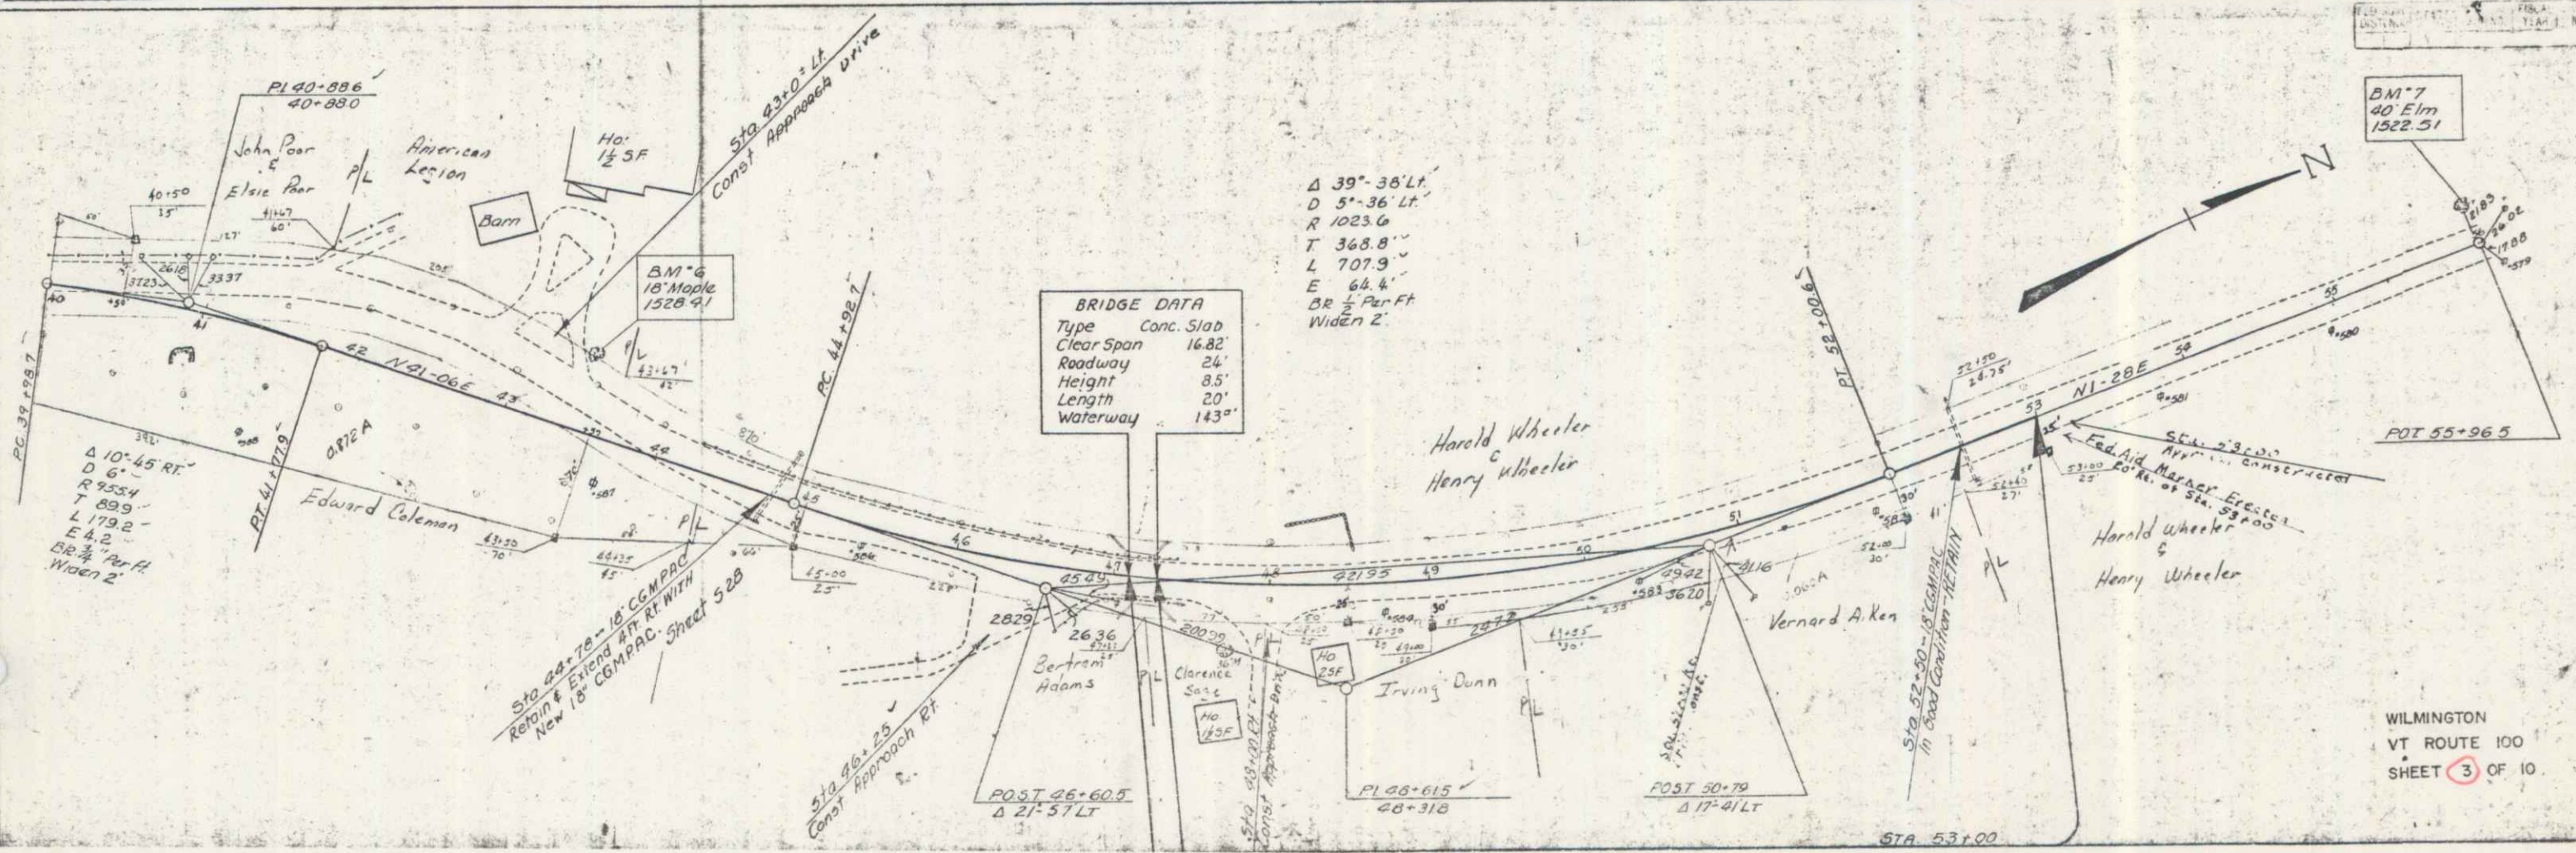

WILMINGTON
 VT ROUTE 100
 SHEET 3 OF 10.

3