


PLAN	DATE	BY	CHKD


PLAN	DATE	BY	CHKD

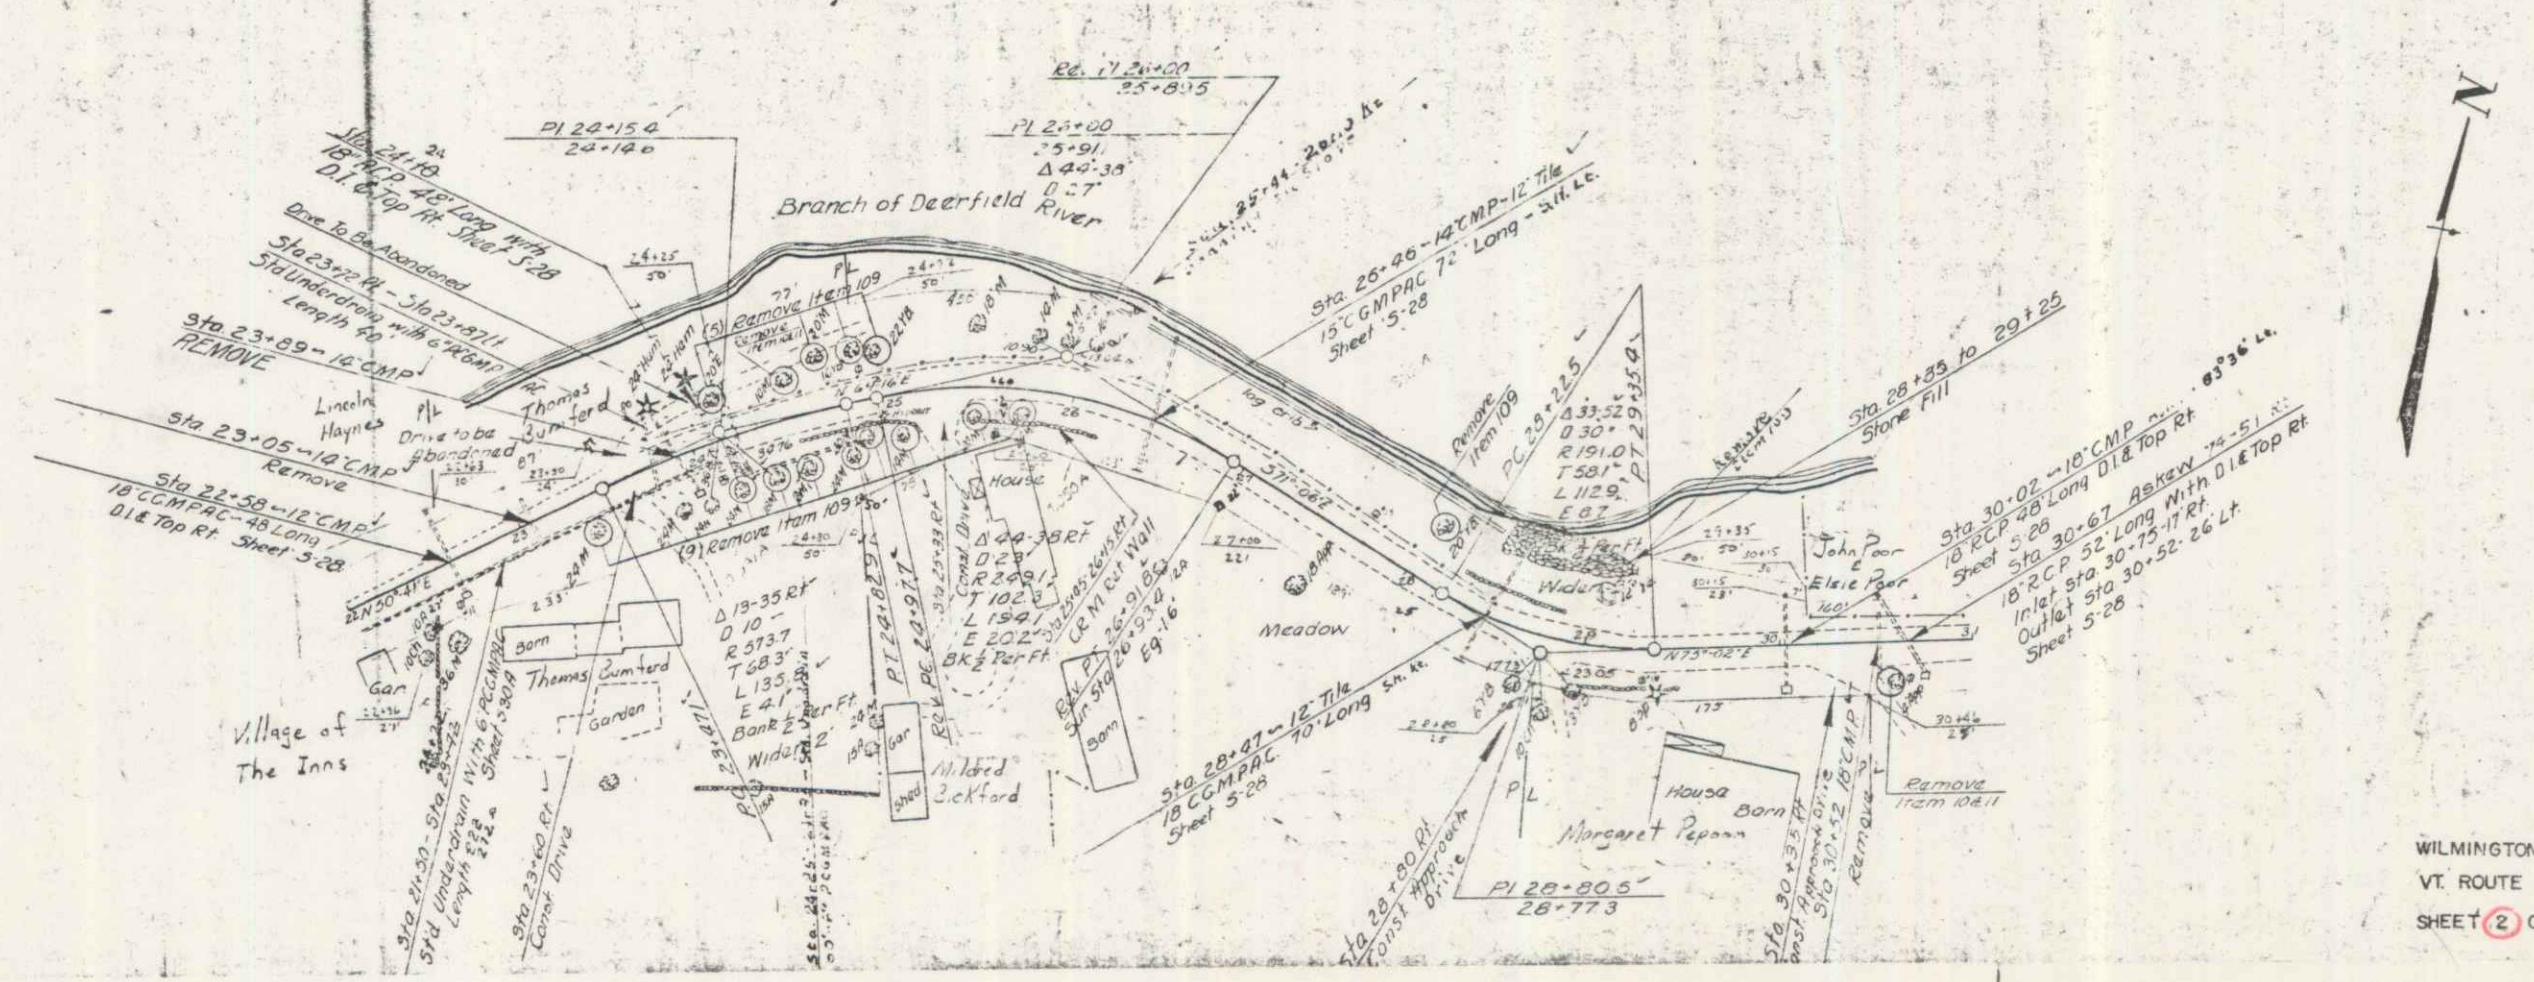


WILMINGTON  
VT ROUTE 100  
SHEET 2 OF 10

PLAN  
 REVISIONS  
 DATE  
 BY  
 CHECKED  
 DATE  
 BY  
 NOTE BOOK  
 NO. OF PAGES CHECKED  
 10

Sta 33+0-34+0 Lt.  
 Poor foundation material (Muck)  
 to be disposed of as directed by  
 the Engineer.

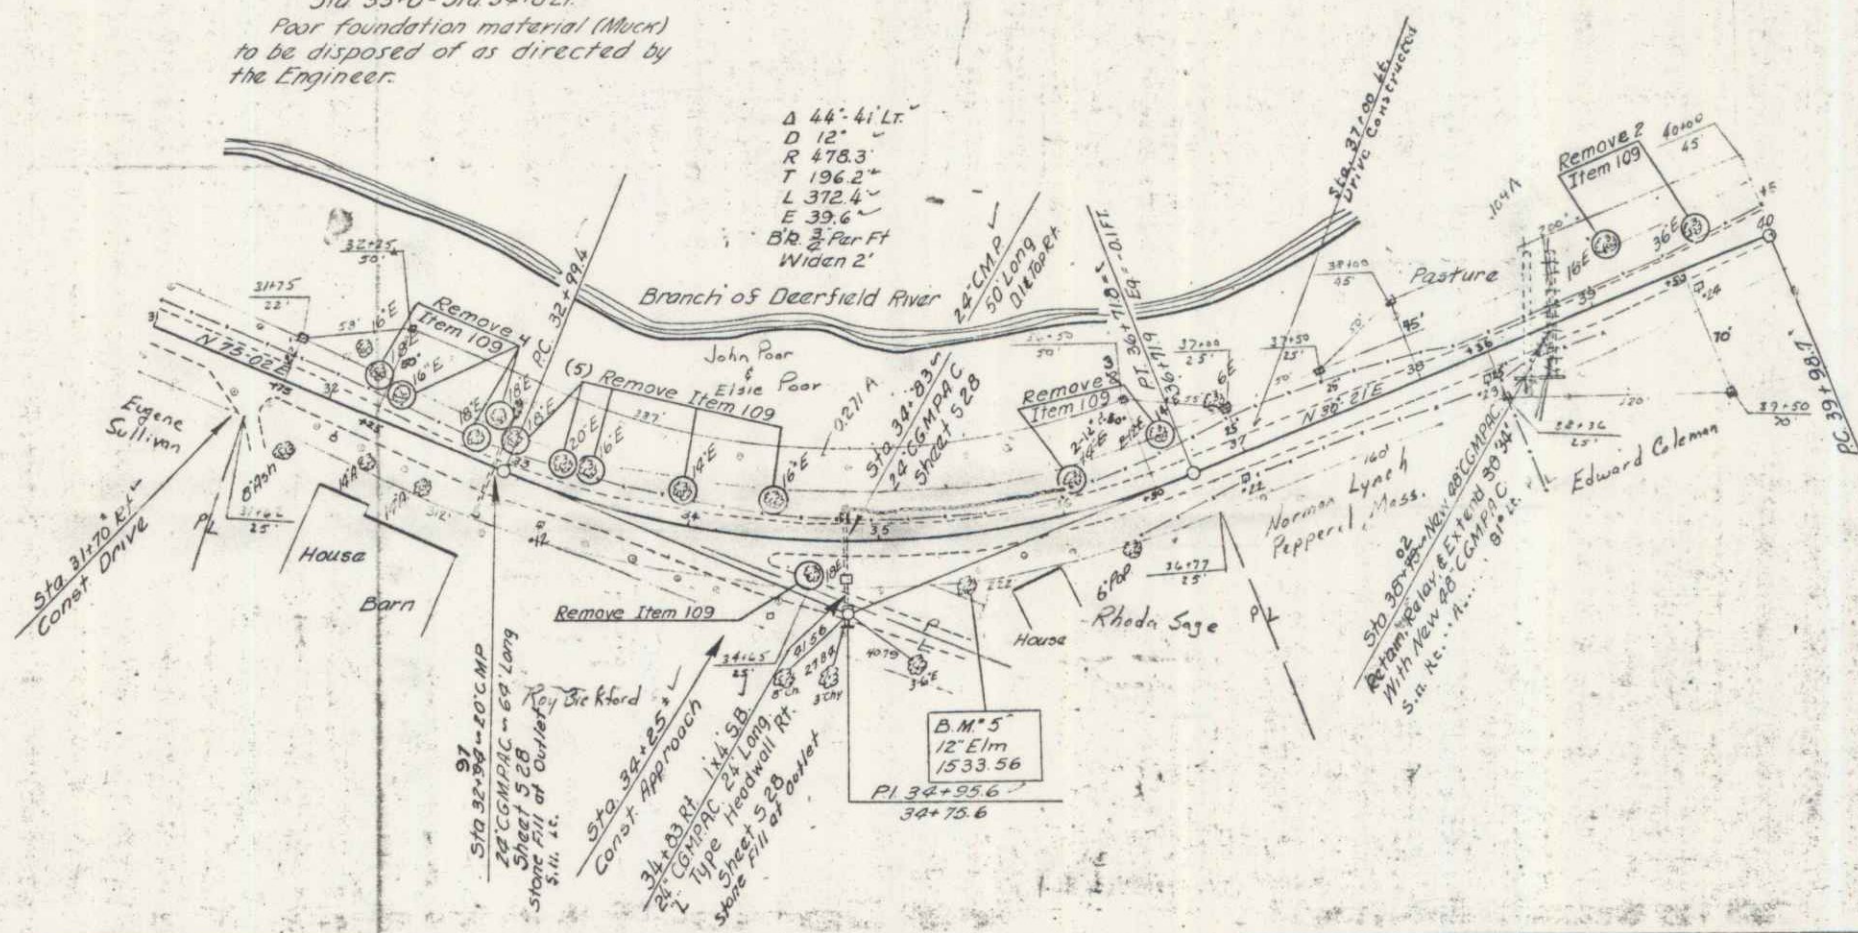

PLAN  
 REVISIONS  
 DATE  
 BY  
 CHECKED  
 DATE  
 BY  
 NOTE BOOK  
 NO. OF PAGES CHECKED  
 10


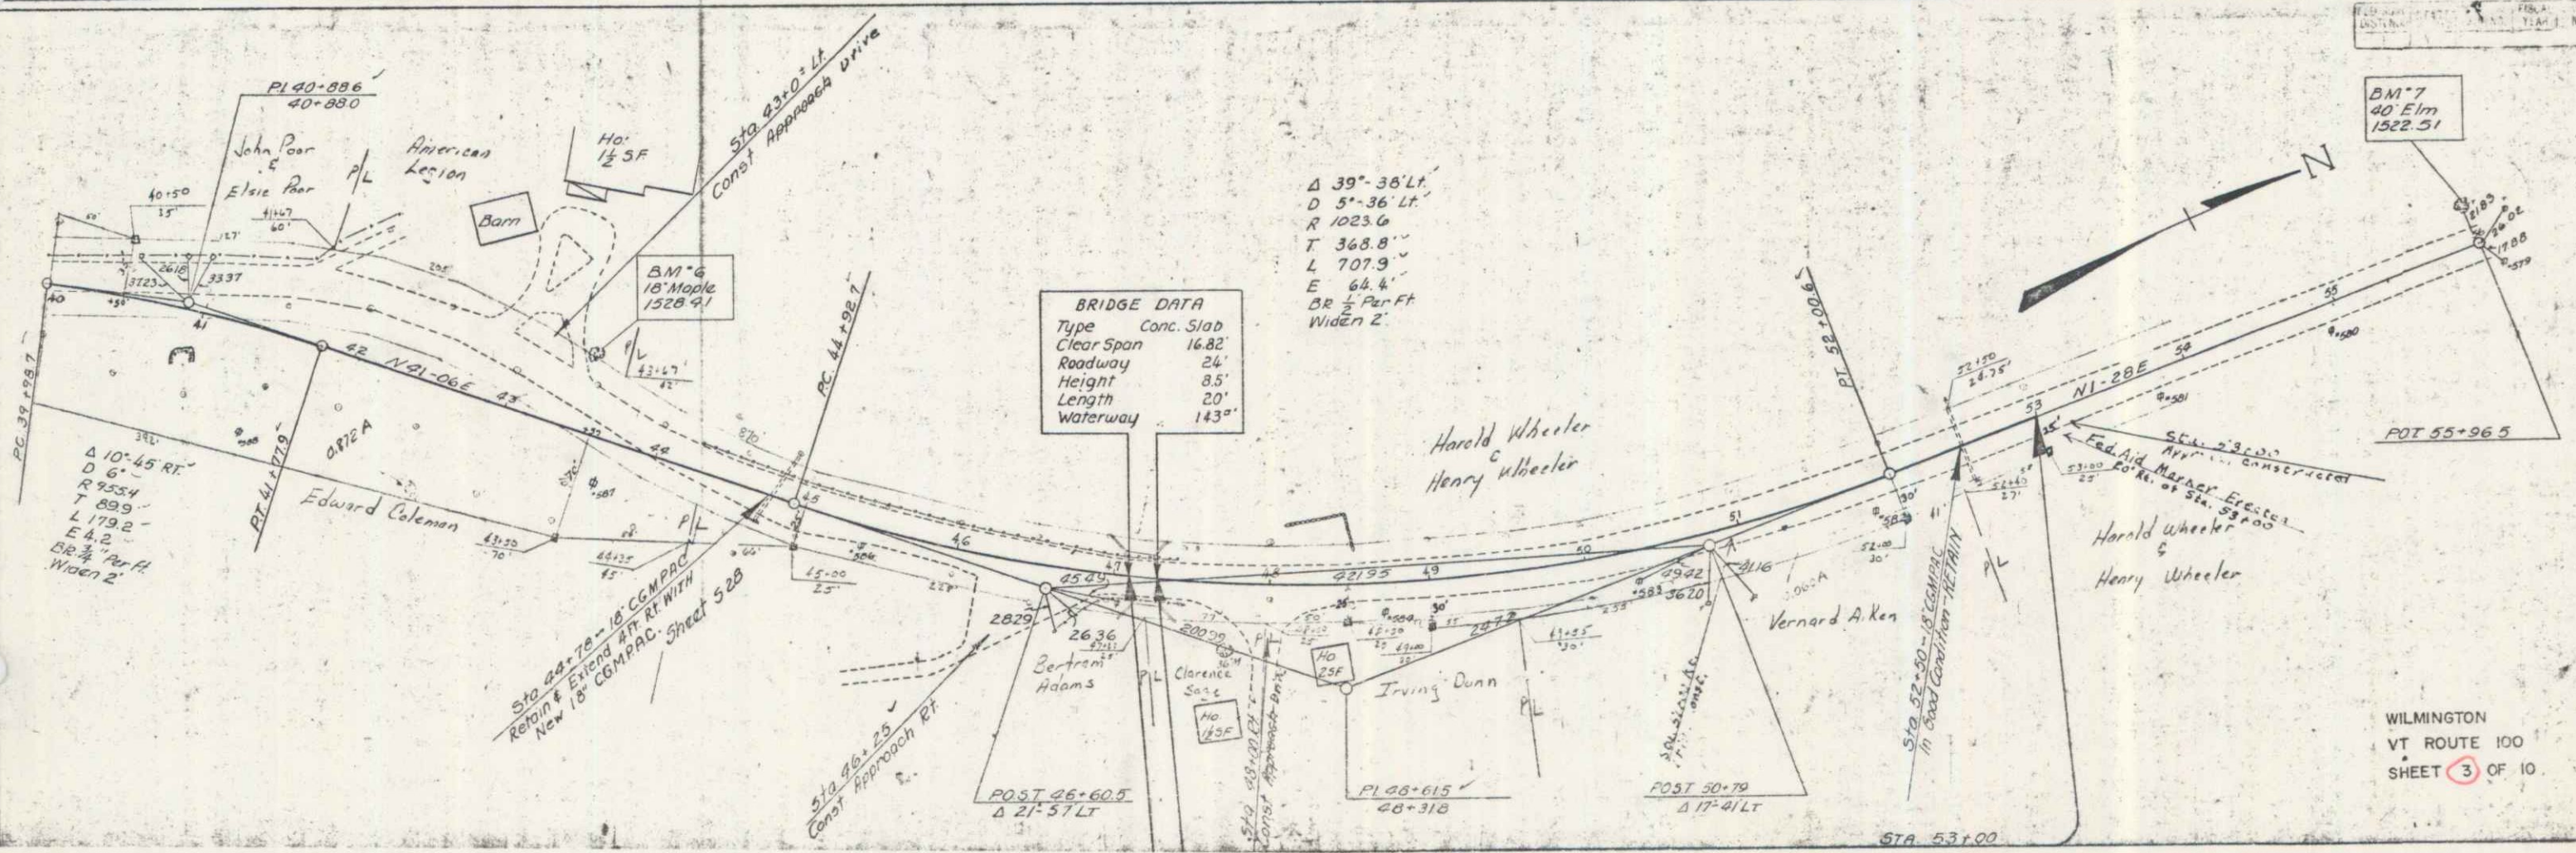


WILMINGTON  
 VT ROUTE 100  
 SHEET 3 OF 10.

Sta. 53+00.0  
 PROJ. 522(1)1946 ENDS



CURVE DATA  
 $\Delta$  11° 51' 30" LT  
 D 6'  
 R 10090  
 T 1034  
 L 3053  
 E 103

CURVE DATA  
 $\Delta$  5° 15' 30" RT  
 D 4'  
 R 1432.4  
 T 1034  
 L 2065  
 E 37

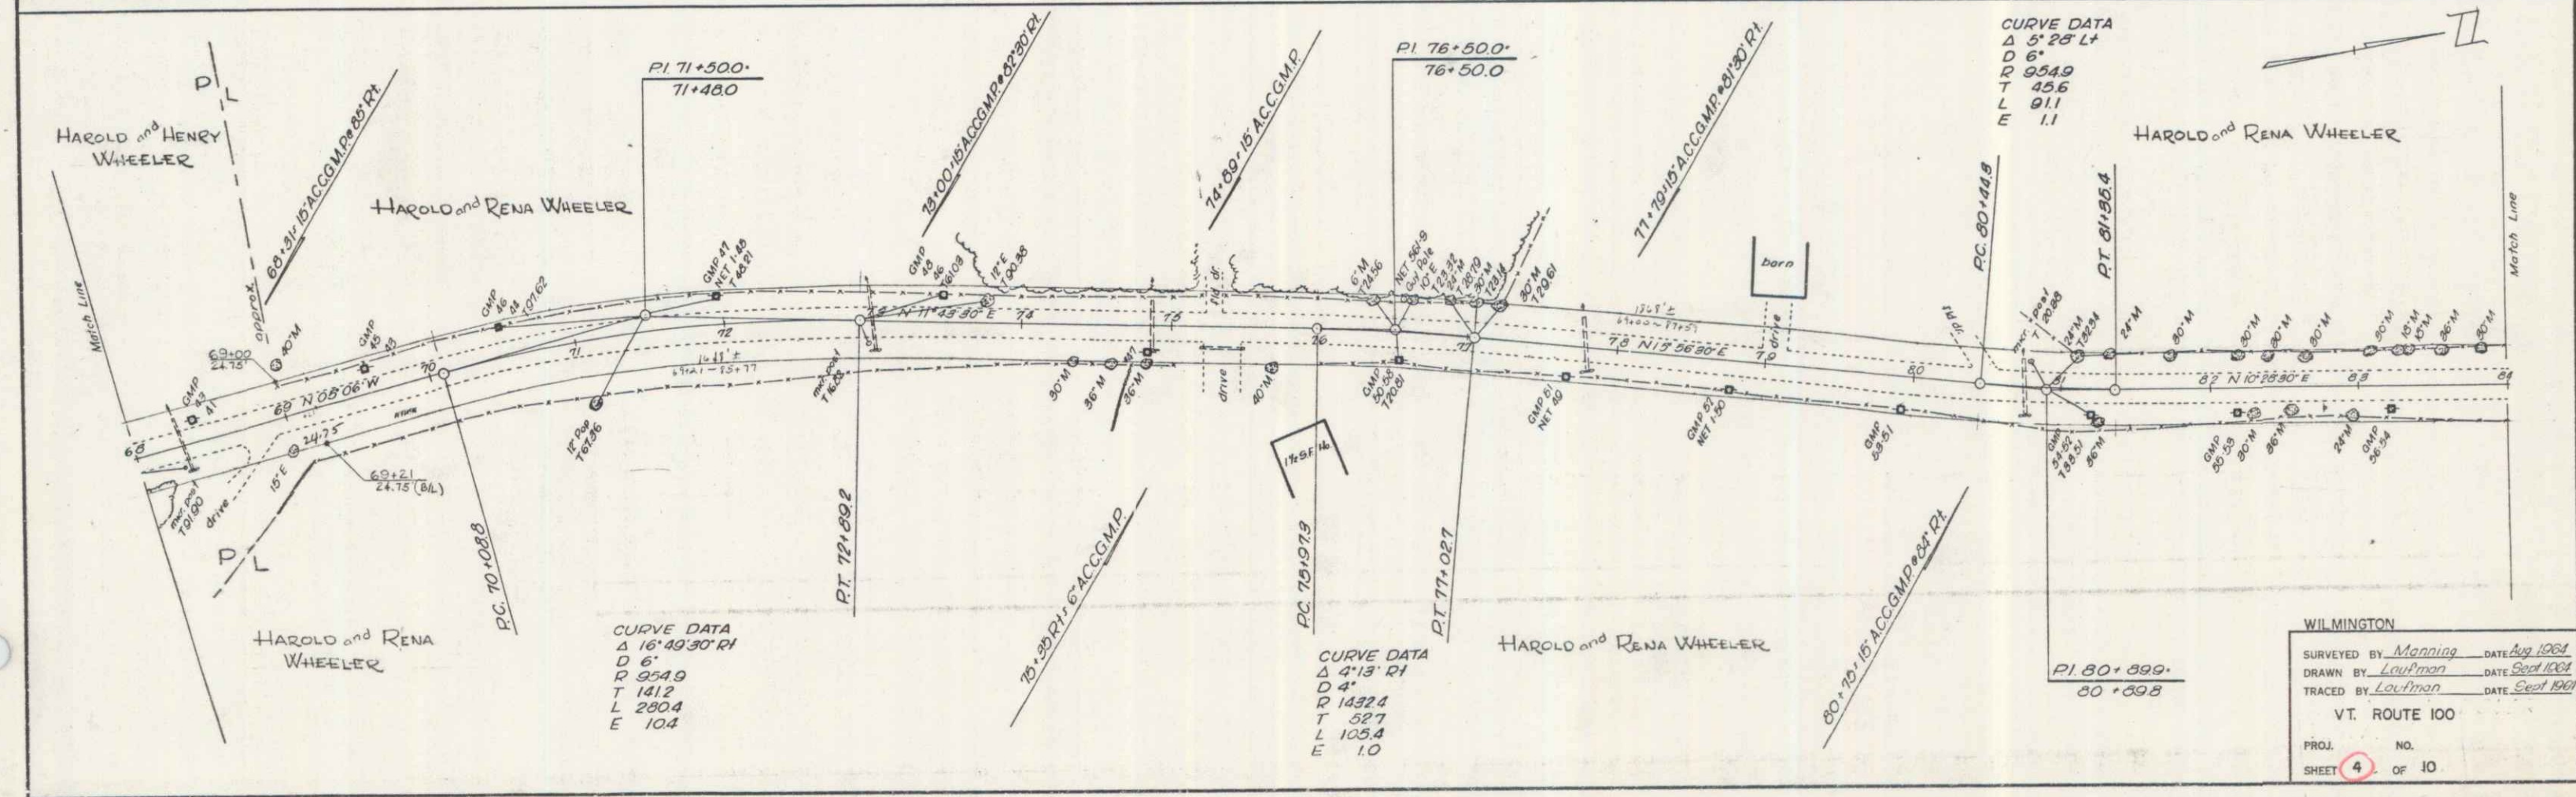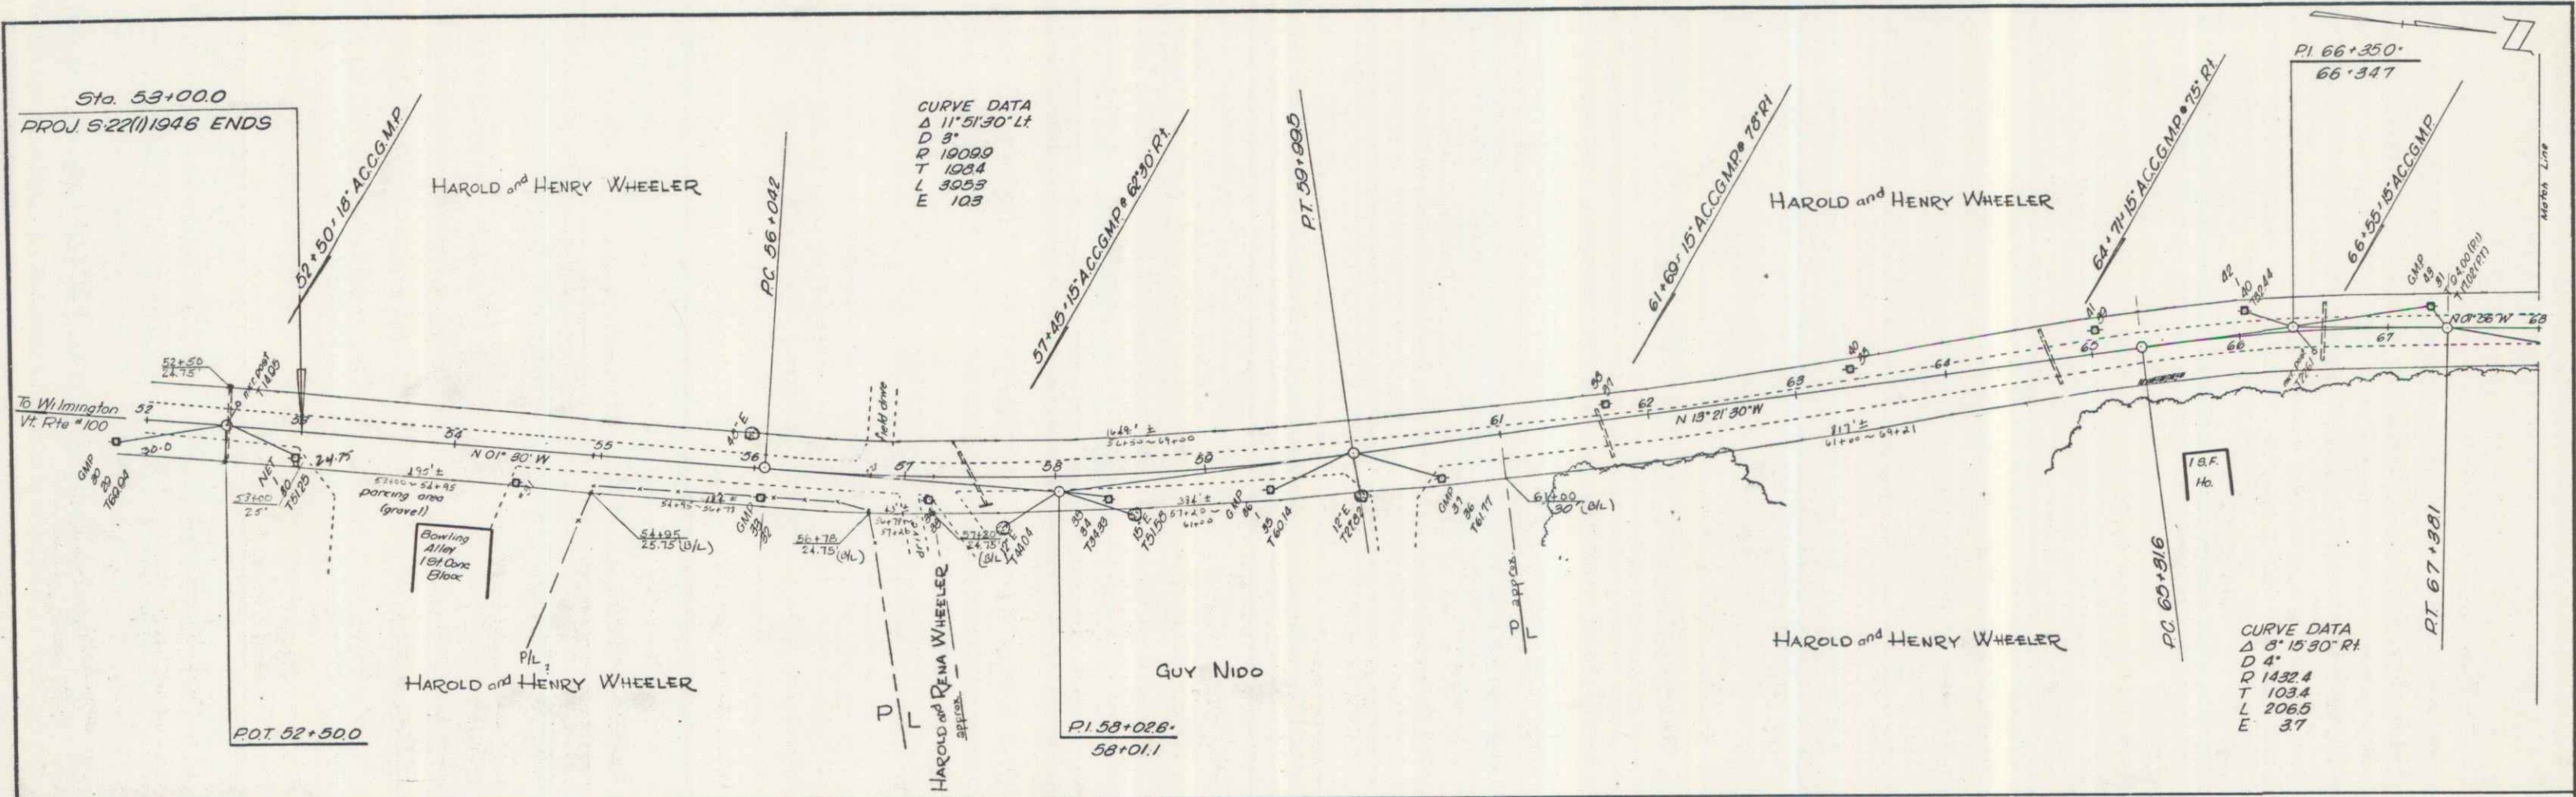

WILMINGTON  
 SURVEYED BY Manning DATE Aug 1964  
 DRAWN BY Loufman DATE Sept 1964  
 TRACED BY Loufman DATE Sept 1964  
 VT. ROUTE 100  
 PROJ. NO. \_\_\_\_\_  
 SHEET 4 OF 10



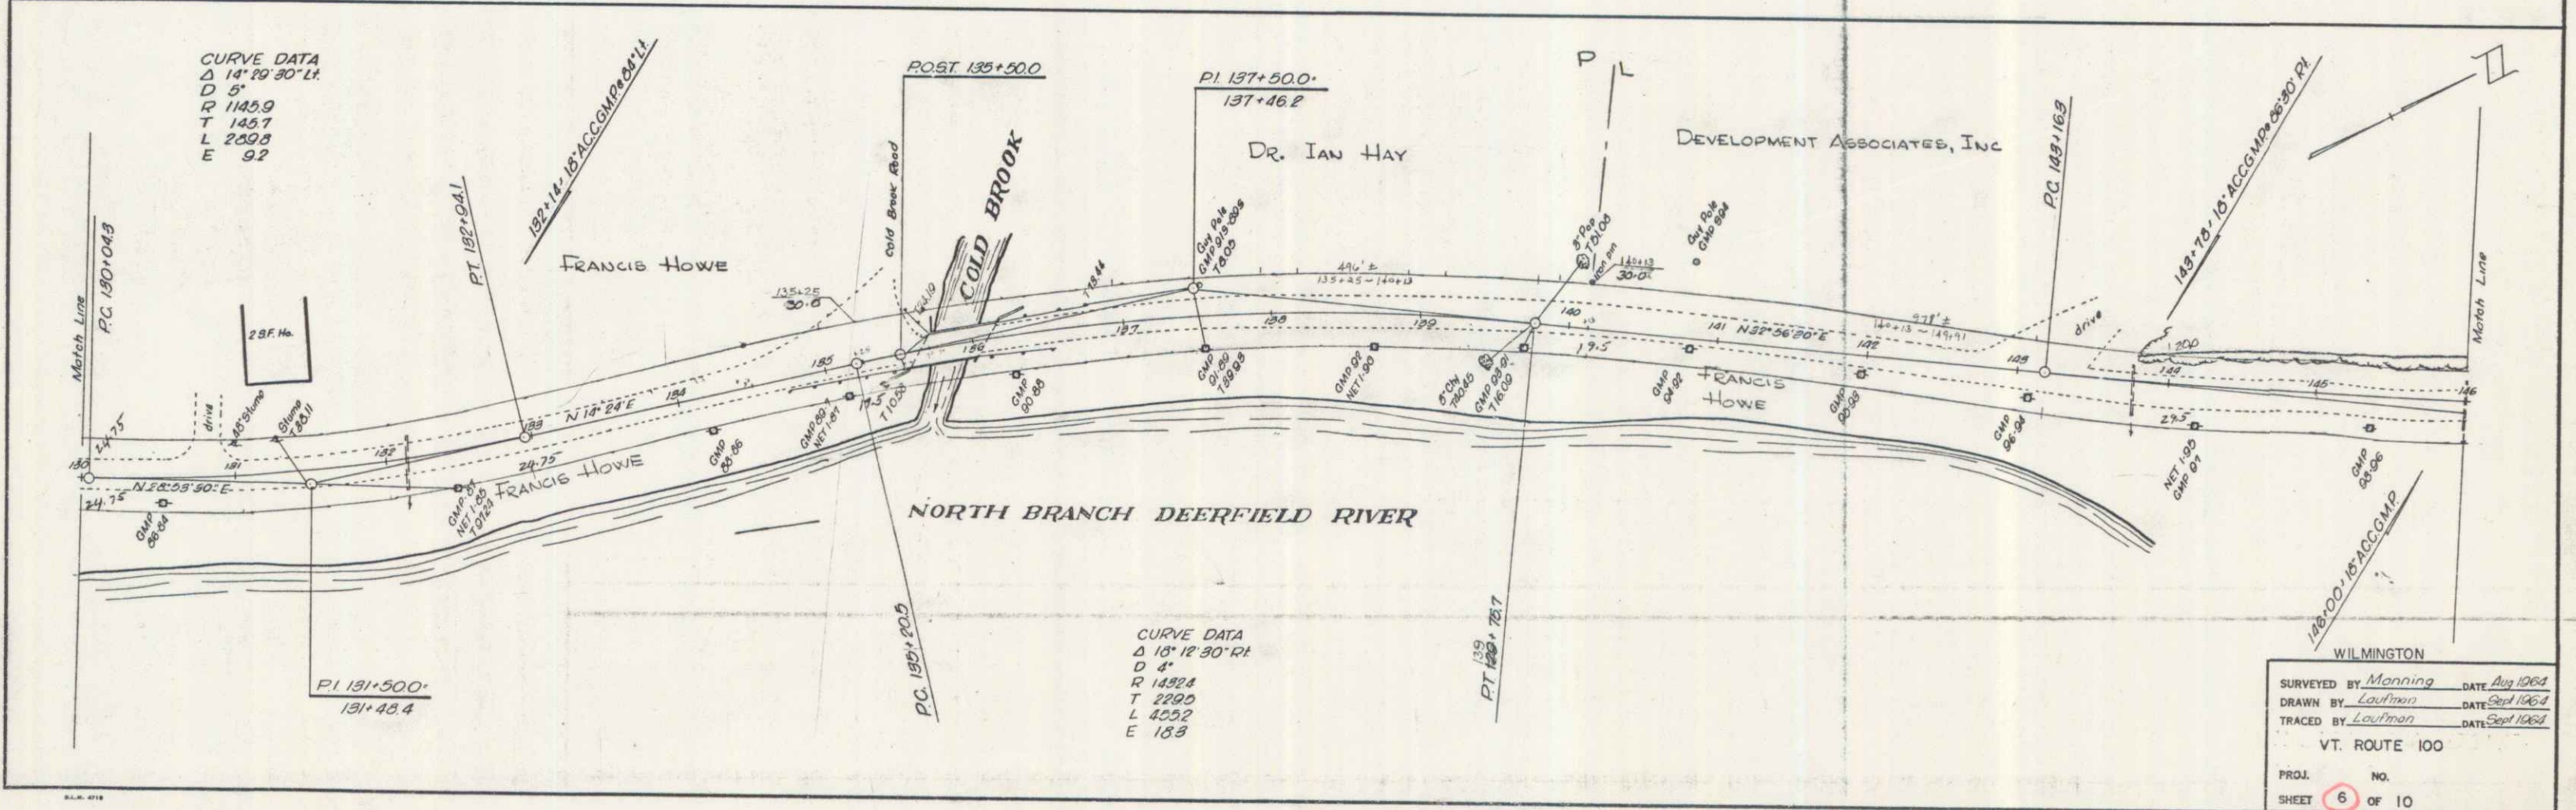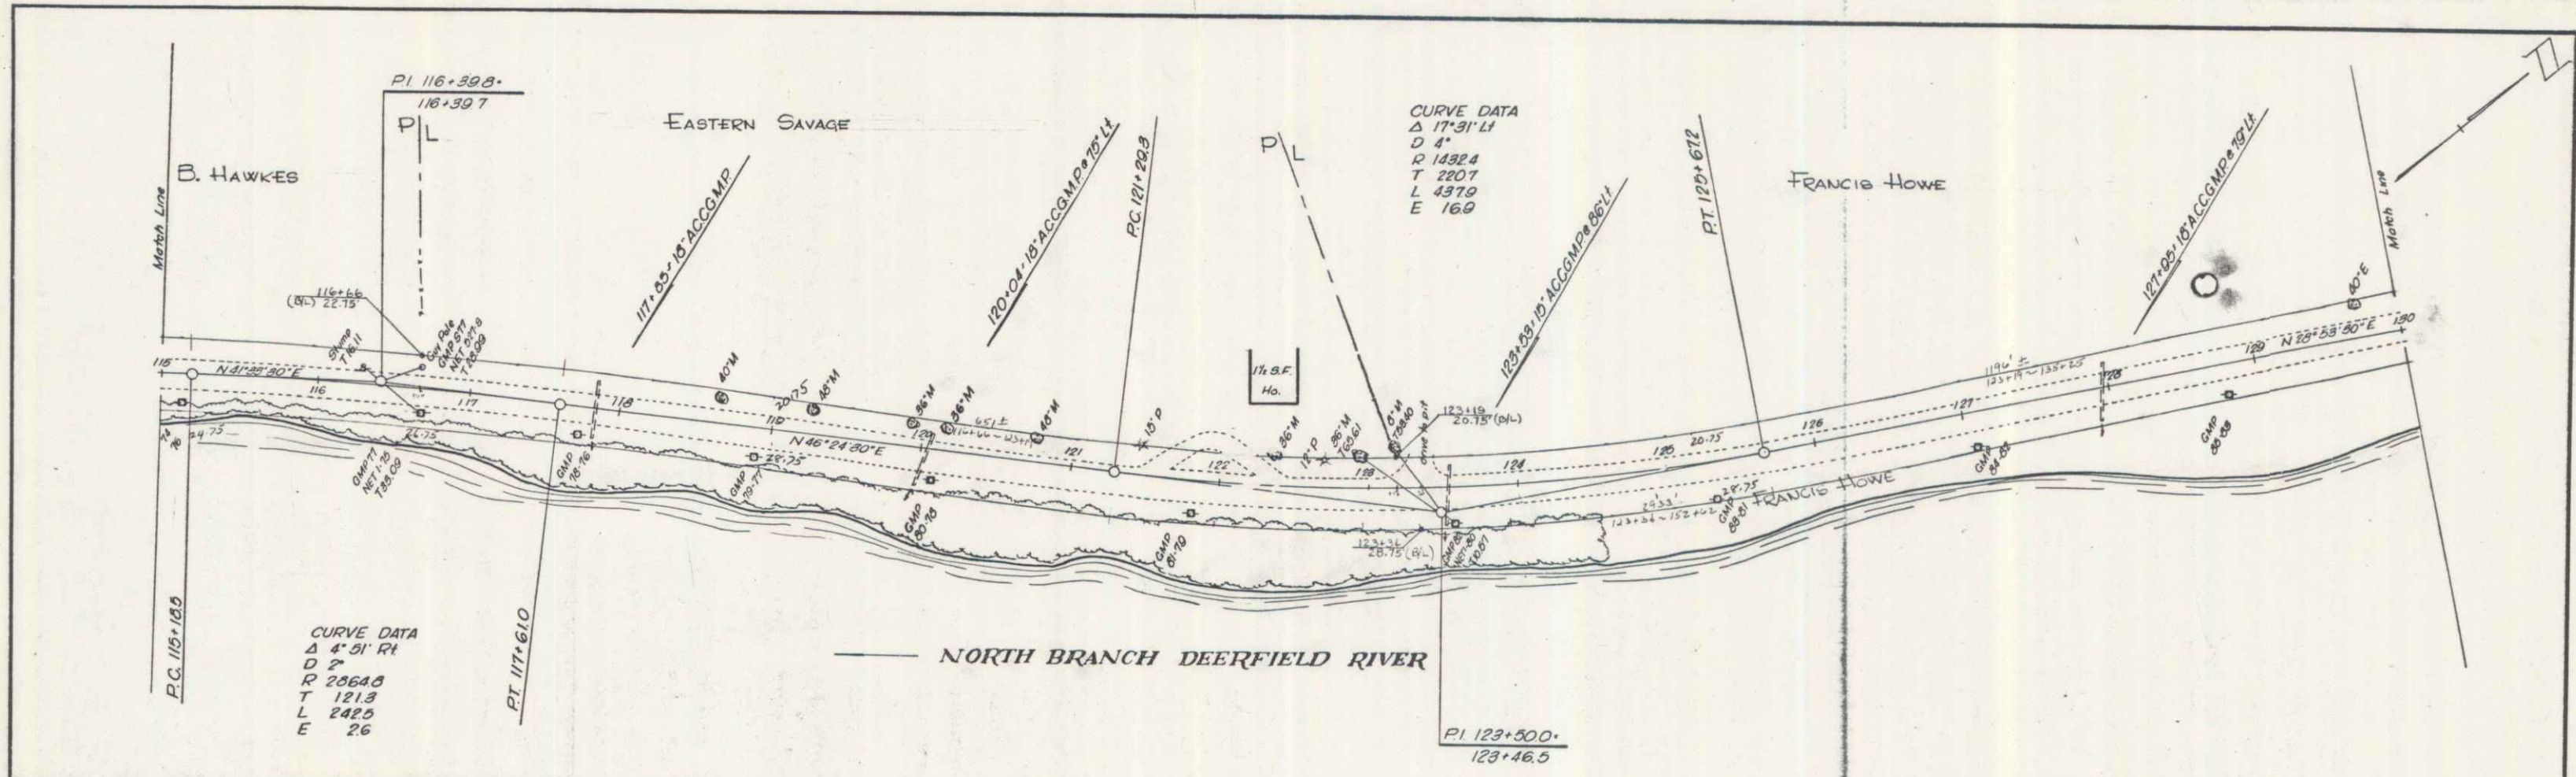


WILMINGTON

SURVEYED BY Manning DATE Aug 1964  
 DRAWN BY Loutman DATE Sept 1964  
 TRACED BY Loutman DATE Sept 1964

VT. ROUTE 100

PROJ. NO. 6  
 SHEET 6 OF 10



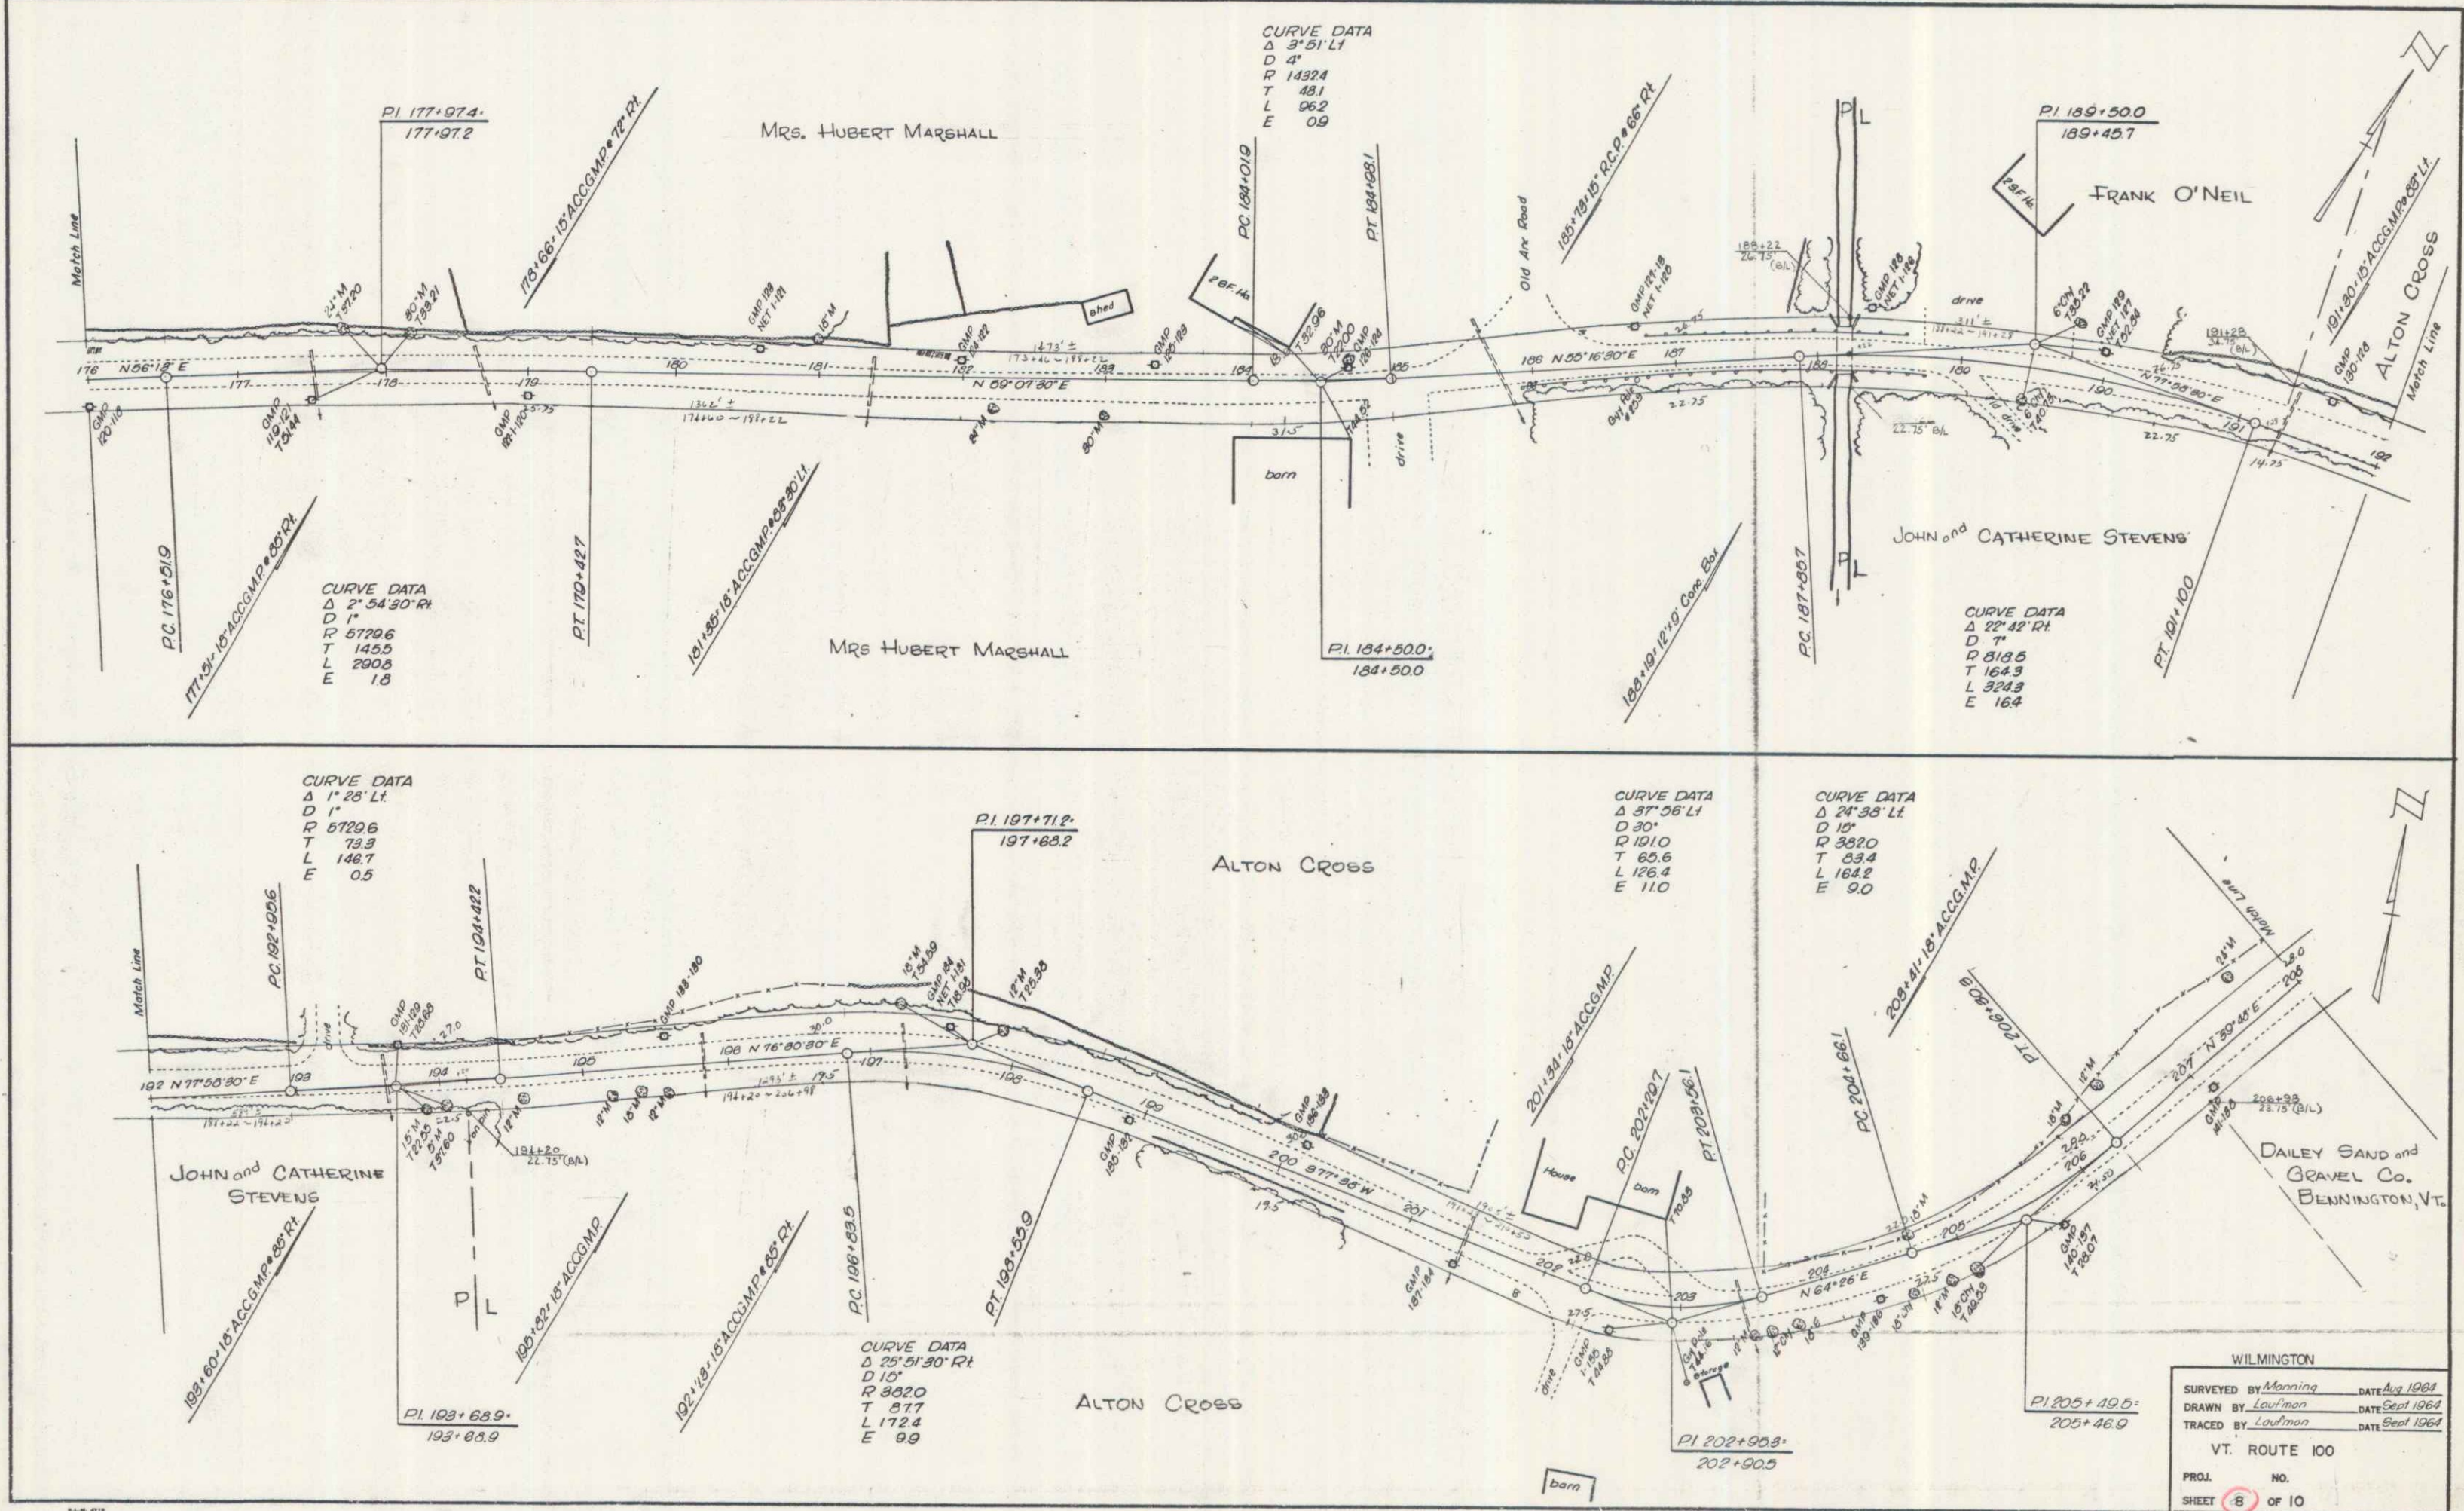

CURVE DATA  
 Δ 3° 51' Lt  
 D 4'  
 R 14324  
 T 481  
 L 962  
 E 09

CURVE DATA  
 Δ 2° 54' 30" Rt  
 D 1'  
 R 57206  
 T 1455  
 L 2903  
 E 18

CURVE DATA  
 Δ 22° 42' Rt  
 D 7'  
 R 8186  
 T 1643  
 L 3243  
 E 164


CURVE DATA  
 Δ 1° 28' Lt  
 D 1'  
 R 57206  
 T 73.9  
 L 148.7  
 E 05


CURVE DATA  
 Δ 37° 56' Lt  
 D 30'  
 R 1010  
 T 80.6  
 L 126.4  
 E 110

CURVE DATA  
 Δ 24° 38' Lt  
 D 15'  
 R 8820  
 T 83.4  
 L 164.2  
 E 9.0

CURVE DATA  
 Δ 25° 51' 30" Rt  
 D 15'  
 R 8820  
 T 97.7  
 L 172.4  
 E 9.9

WILMINGTON  
 SURVEYED BY Manning DATE Aug 1961  
 DRAWN BY Lauffman DATE Sept 1961  
 TRACED BY Lauffman DATE Sept 1961  
 VT. ROUTE 100  
 PROJ. NO. \_\_\_\_\_  
 SHEET 8 OF 10

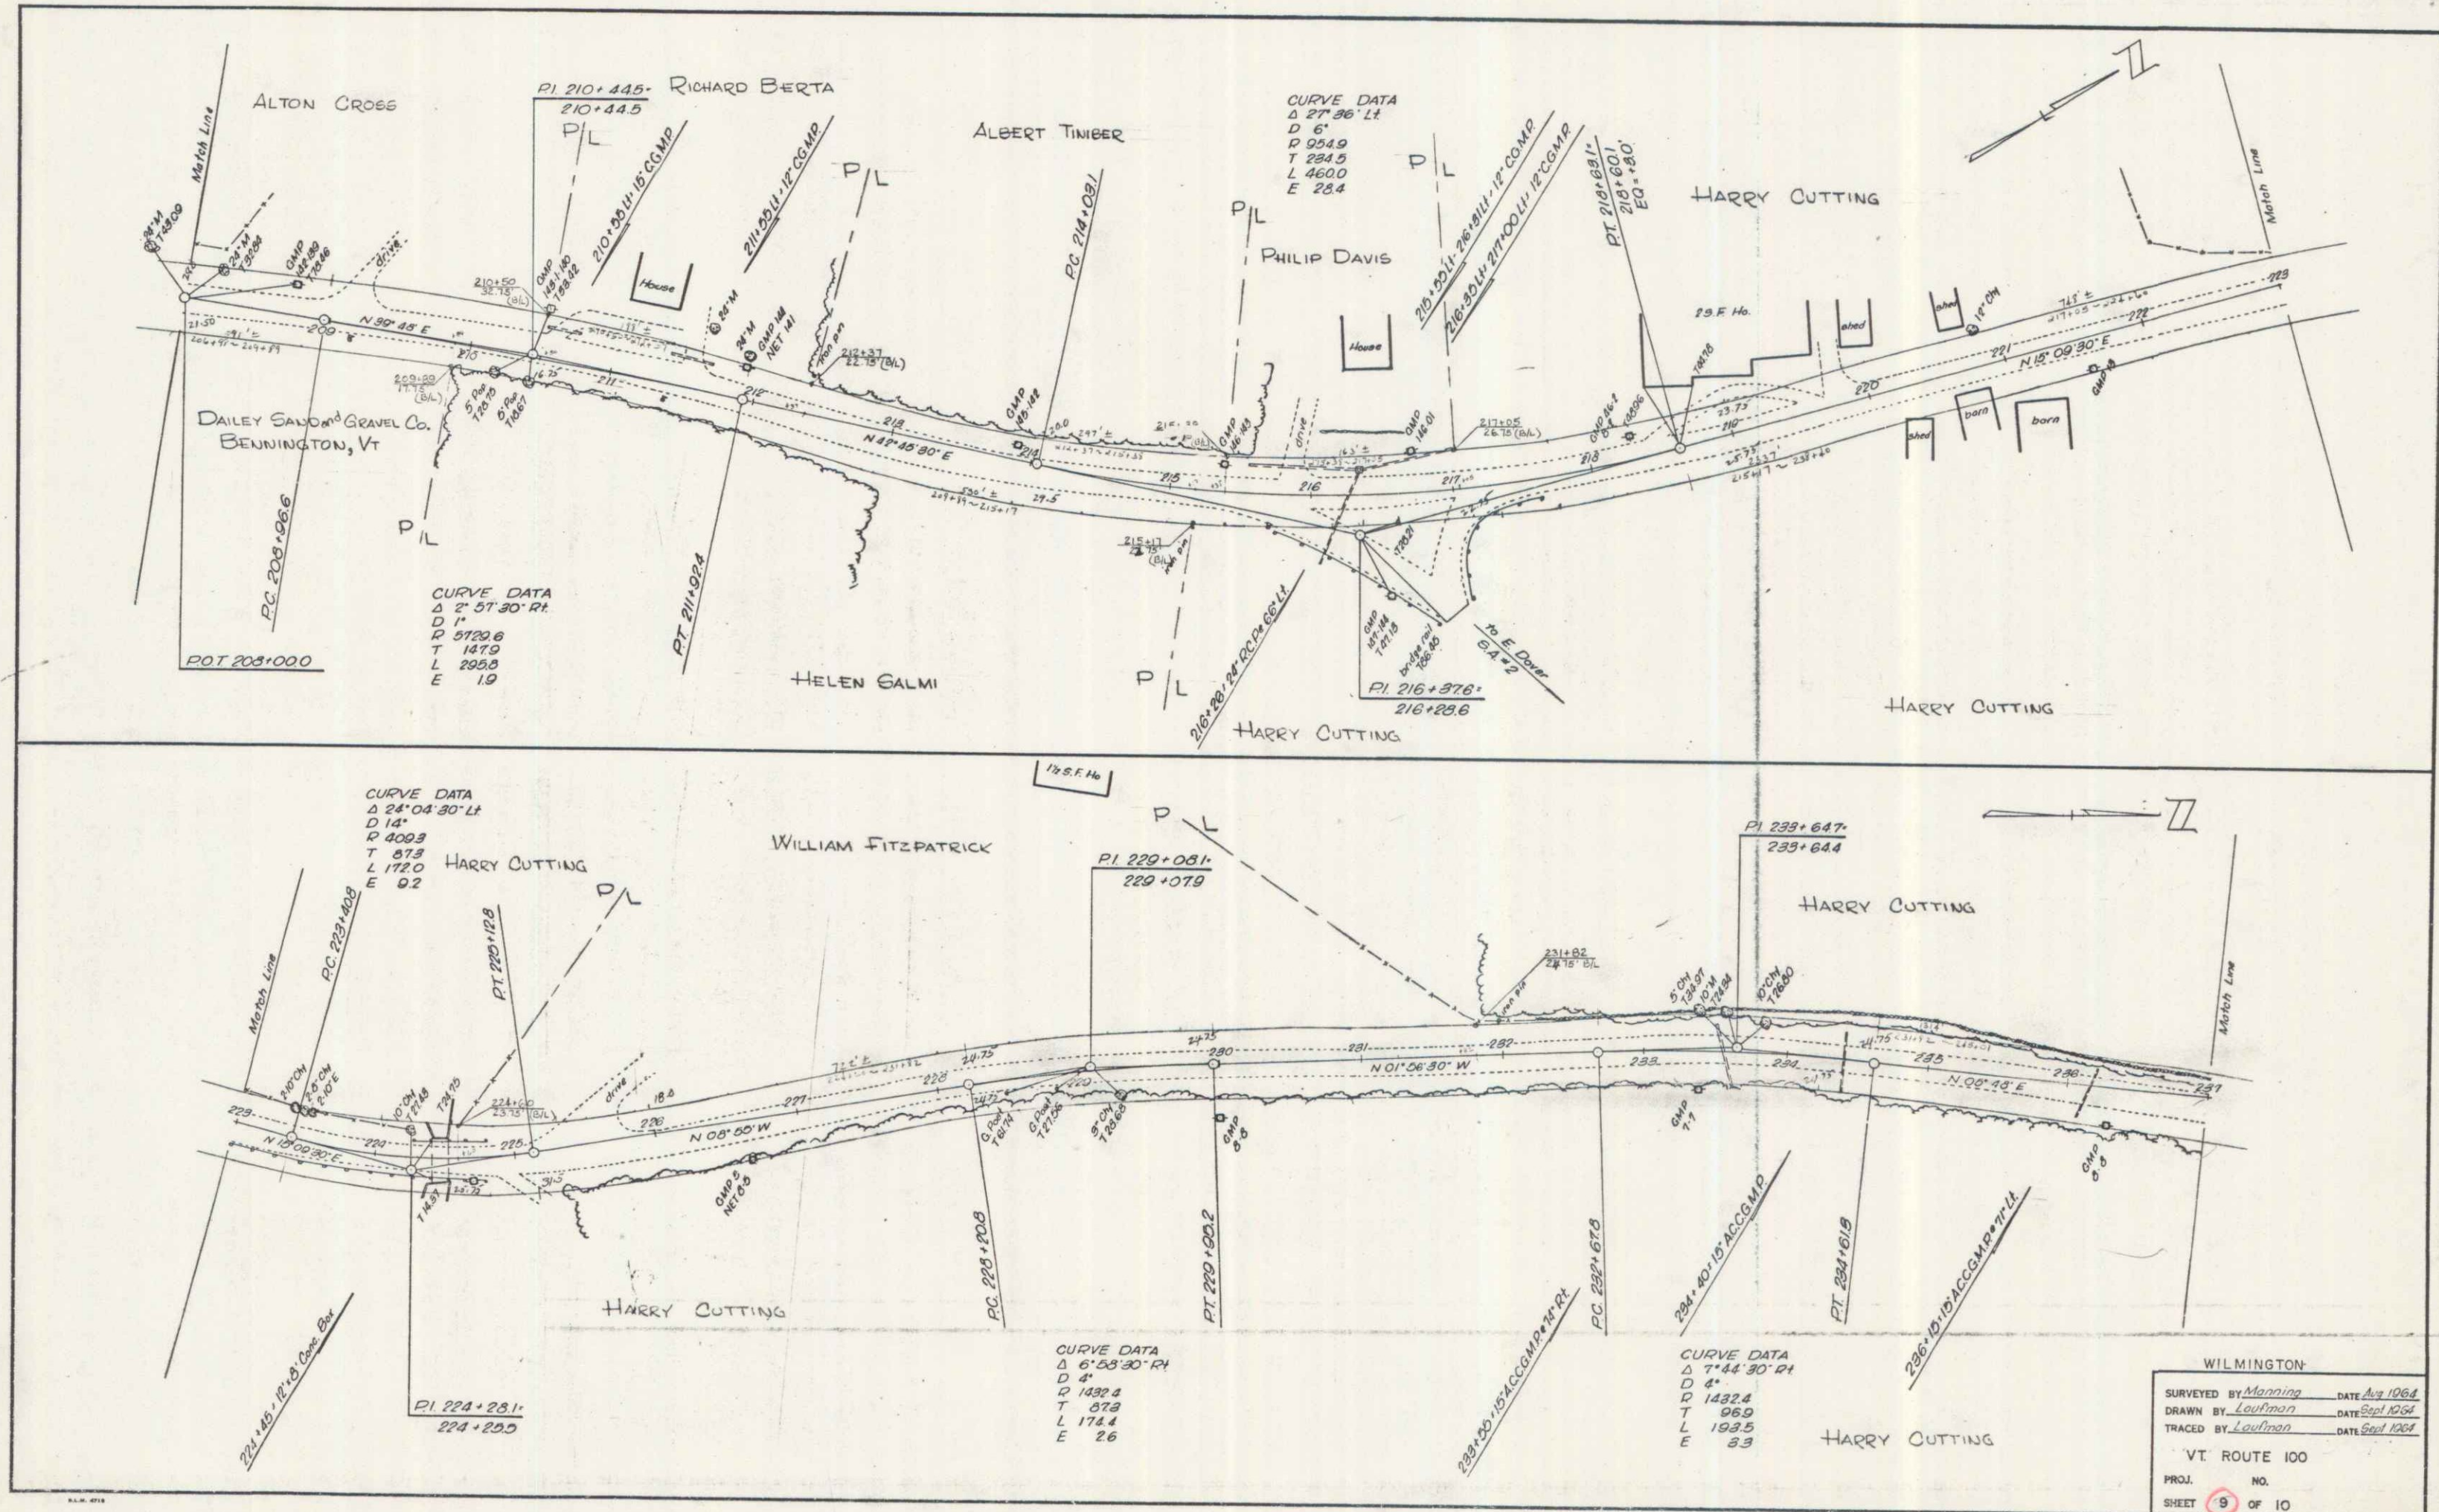

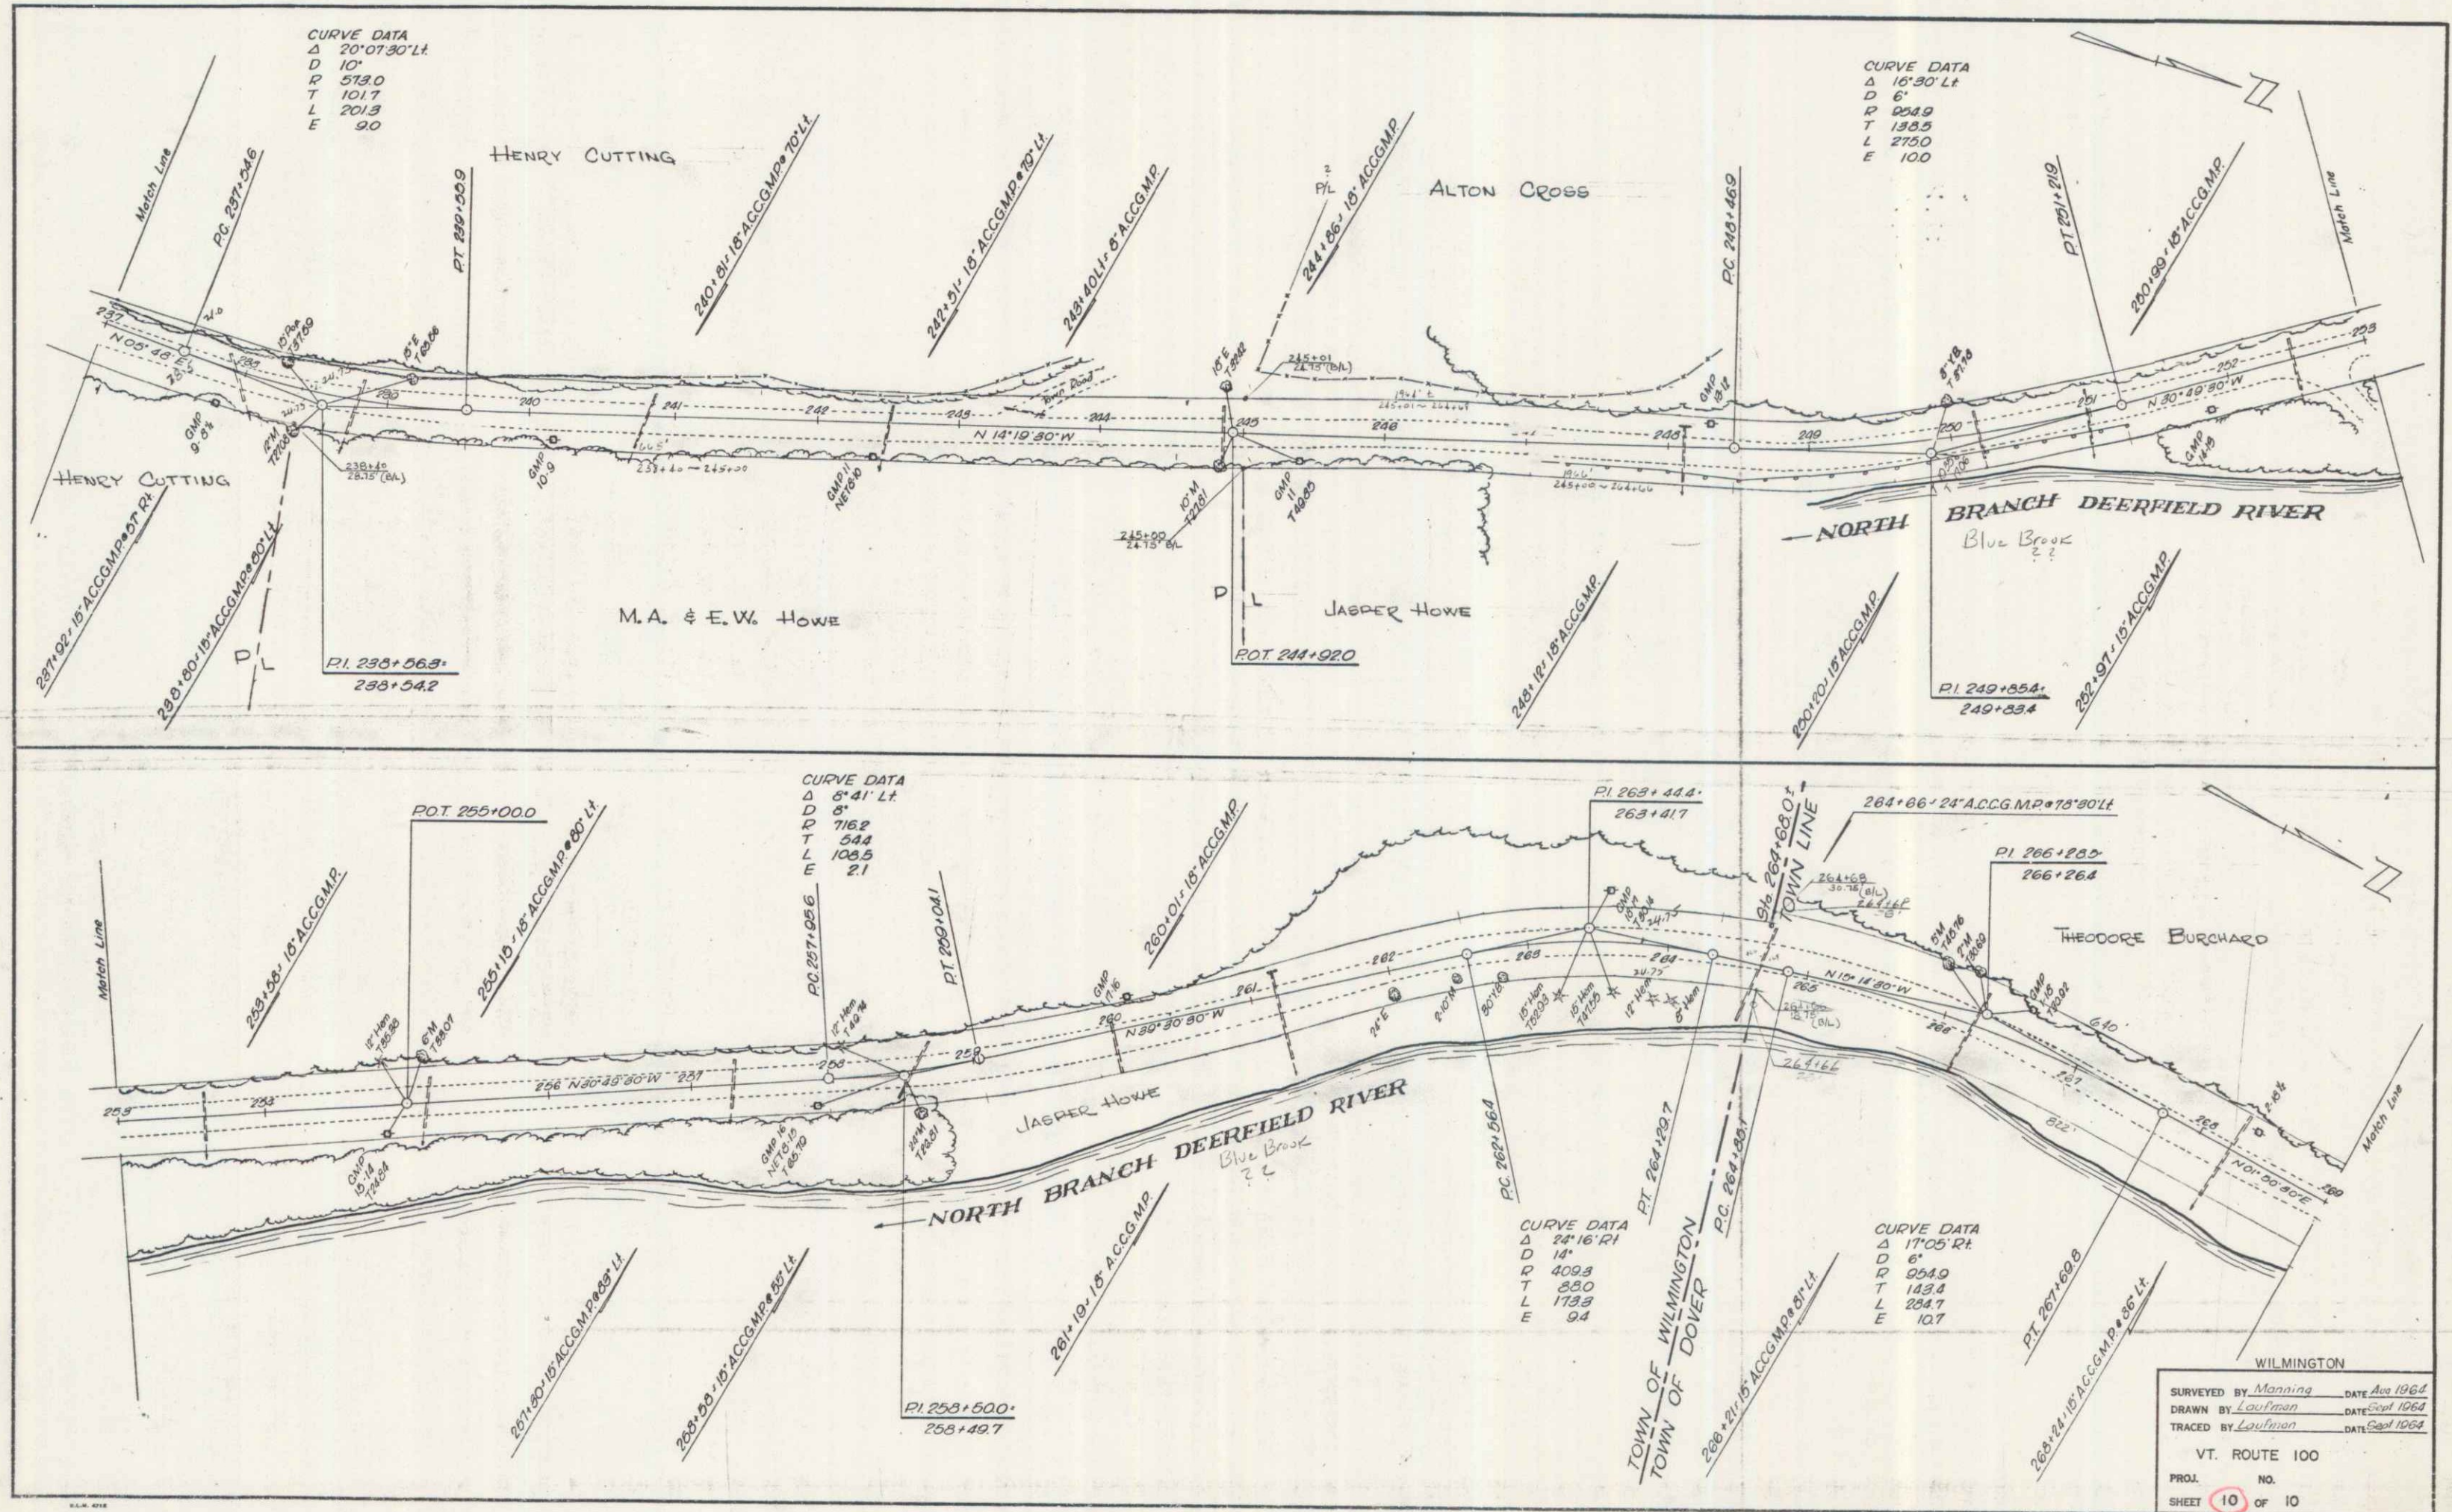

CURVE DATA  
 Δ 20°07'30" Lt  
 D 10'  
 R 513.0  
 T 101.7  
 L 201.3  
 E 20

CURVE DATA  
 Δ 16°30' Lt  
 D 6'  
 R 208.9  
 T 133.5  
 L 275.0  
 E 100

CURVE DATA  
 Δ 5°41' Lt  
 D 5'  
 R 716.9  
 T 54.4  
 L 100.5  
 E 2.1

CURVE DATA  
 Δ 24°16' Rt  
 D 14'  
 R 402.3  
 T 80.0  
 L 173.3  
 E 9.4

CURVE DATA  
 Δ 17°05' Rt  
 D 6'  
 R 254.0  
 T 143.4  
 L 254.7  
 E 10.7

WILMINGTON  
 SURVEYED BY Manning DATE Aug 1964  
 DRAWN BY Loudman DATE Sept 1964  
 TRACED BY Loudman DATE Sept 1964  
 VT. ROUTE 100  
 PROJ. NO.  
 SHEET 10 OF 10