

INDEX OF SHEETS

SHEET NO. 1	TITLE PAGE
2	TYPICAL CROSS-SECTION OF IMPROVEMENT
3	DETAILS OF CONSTRUCTION (Drinking Tables)
3A	TYPICAL CROSS-SECTION OF IMPROVEMENT
3B	DETAILS OF CONSTRUCTION (Drinking Tables)
4-35	PLAN AND PROFILE SHEETS
35	STANDARD STRUCTURE SHEET
40	"
41	"
42	"
43	"
44	CROSS-SECTIONS

**STATE OF VERMONT
STATE HIGHWAY DEPARTMENT**

**PLAN AND PROFILE OF PROPOSED
STATE HIGHWAY**

FEDERAL AID PROJECT


TOWNS OF WATERBURY - STOWE
WATERBURY - MORRISVILLE ROAD.
 FROM 366 FEET SOUTH OF RAILROAD OVER
 PASS IN WATERBURY NORTH 9.816 MILES TO A
 POINT 346 FEET NORTH OF THE END OF THE
 STATE HIGHWAY SYSTEM IN STOWE VILLAGE.

FILE NO.	DATE	BY	FOR	BY	DATE
9	VT.	AMB	1/22	1	1/24



LENGTH OF CONTRACT

TYPE	GOVERNMENT PARTICIPATION		LOCAL GOVERNMENT PARTICIPATION		TOTAL	
	FEET	MILES	FEET	MILES	FEET	MILES
CONCRETE	508389	9.628	656.9	0.124	514958	9.752
GRAVEL			335.5	0.064	335.5	0.064
TOTAL	508389	9.628	992.4	0.188	518333	9.816

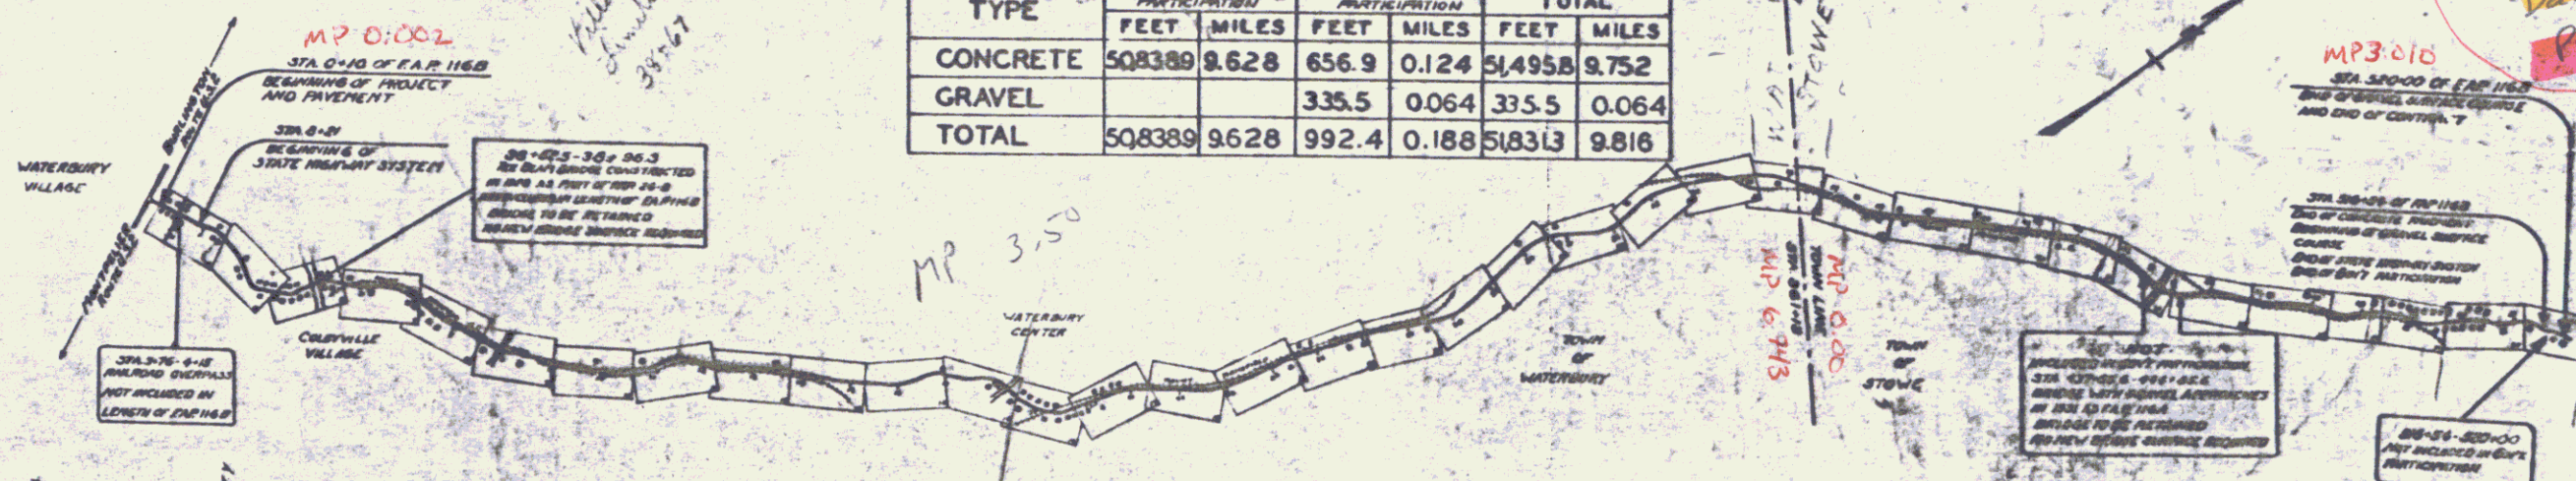

- COUNTY LINE
- TOWN LINE
- FENCE LINE
- STONE WALL
- UNFENCED
- GUARD RAIL
- TRAVELED
- RAILROAD
- RETAINING
- CENTER LINE
- SURVEY LINE
- CULVERT
- DROP INLET
- TROLLEY RAIL
- POWER POLE
- TELEPHONE
- TREE
- HEDGE

- CURVE DATA**
- DEFLECTION ANGLE Δ
 - DEGREE OF CURVE D
 - RADIUS OF CURVE R
 - TANGENT DISTANCE T
 - LENGTH OF CURVE L
 - EXTERNAL DISTANCE E
 - POINT OF INTERSECTION P. I.
 - POINT OF CURVE P. C.
 - POINT OF TANGENT P. T.
 - POINT ON TANGENT P.O.T.

SCALES
 TITLE PAGE 1" = 2000'
 LAYOUT PLAN 1" = 50'
 PROFILE 1" = 10'
 SECTIONS 1" = 5'

RIGHT-OF-WAY DIVISION
 TOWN FILE
 PERPETUAL
 Town of _____
 (To Be Returned To R.O.W. Division)

CORRECT APRIL 16, 1932
 ENGINEER
 SERIES F. NO. 1558 FILED
 SHEET 1 OF 122 10

Route: VT 100
 Date: 4/15/1932
 Pin: 01R125

*These plans are subject to such
 conditions as may be required by the
 Commissioner of Highway or the
 County of Public Use*

Waterbury