
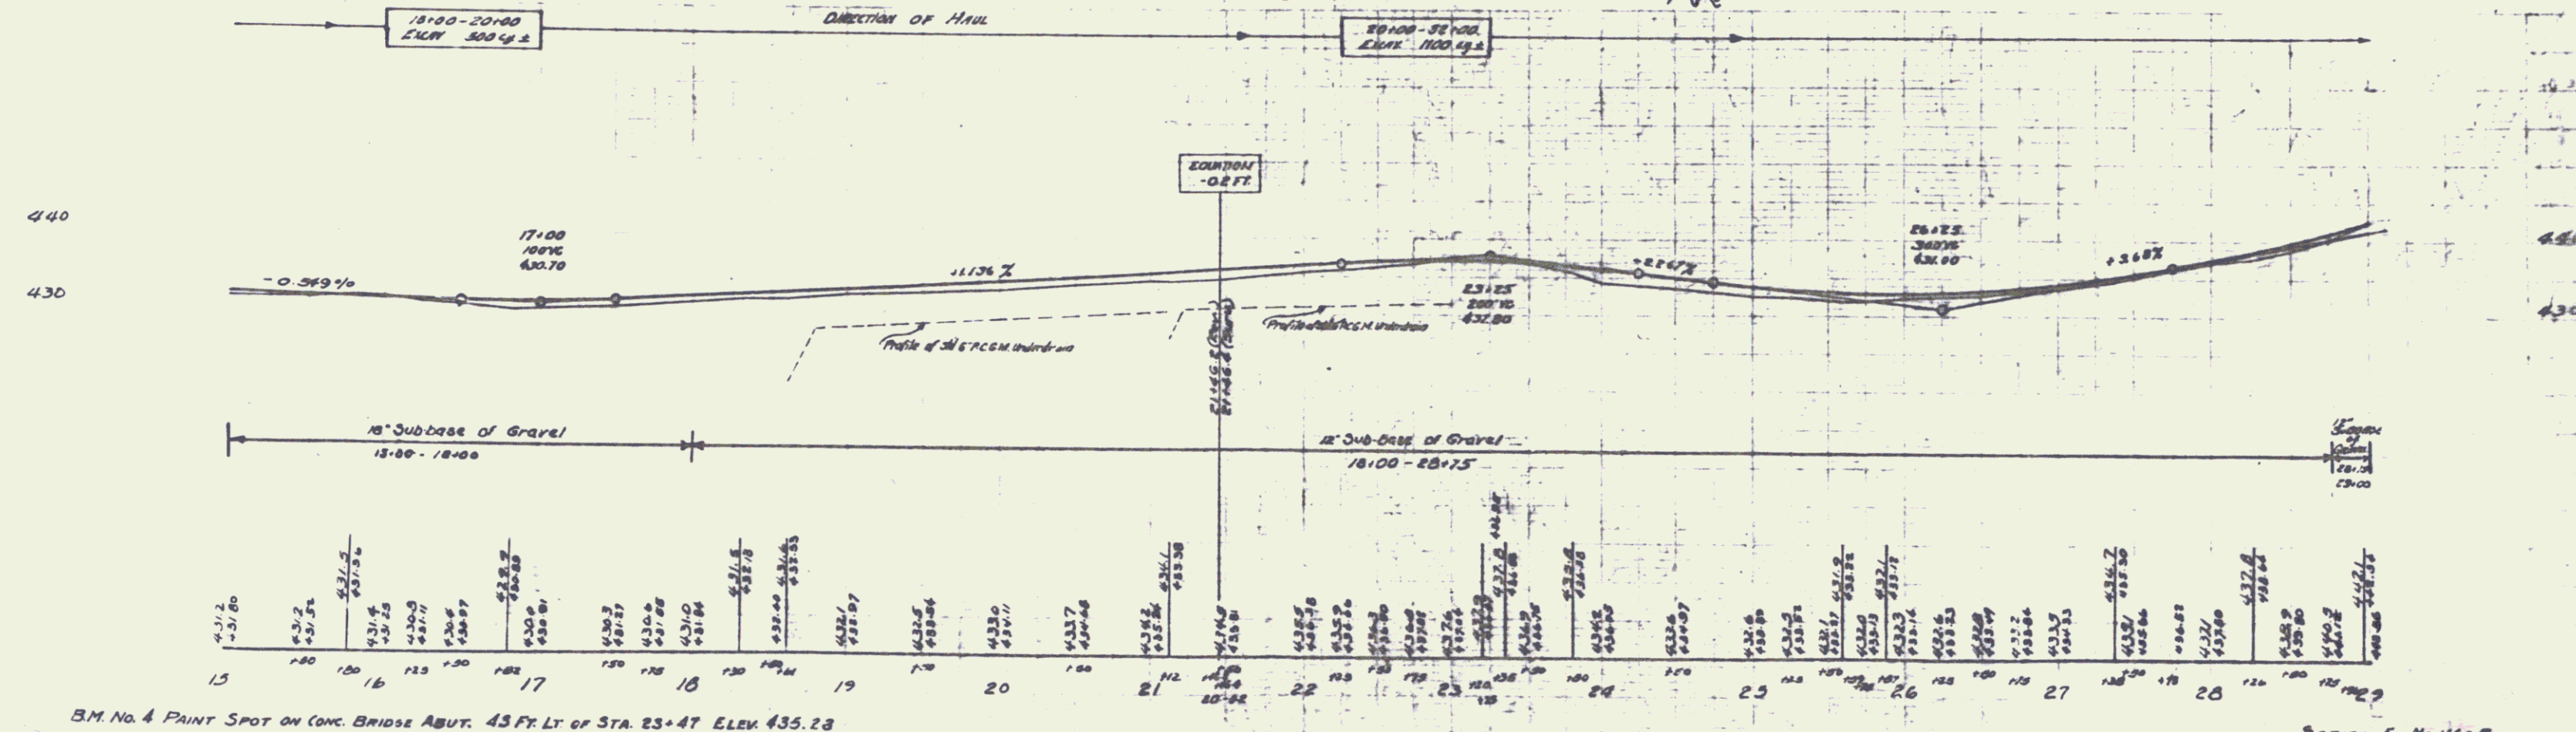


POOR ORIGINAL COPY

Parcel	Kind of Data of Instrument	Date of	Grantee	Recorder	Remarks
A	G.C.D.	4-19-22	E.A. Jewett	J.H.H.	See plat 10-17-22
A	G.C.D.	2-17-24	John H. Keeffe	"	See plat 11-27-24

FED. ROAD STATE FED. AID FISCAL SHEET
 DIST. NO. PROJ. NO. YEAR NO. SHEET
 8 11 26-2 7058 3 125

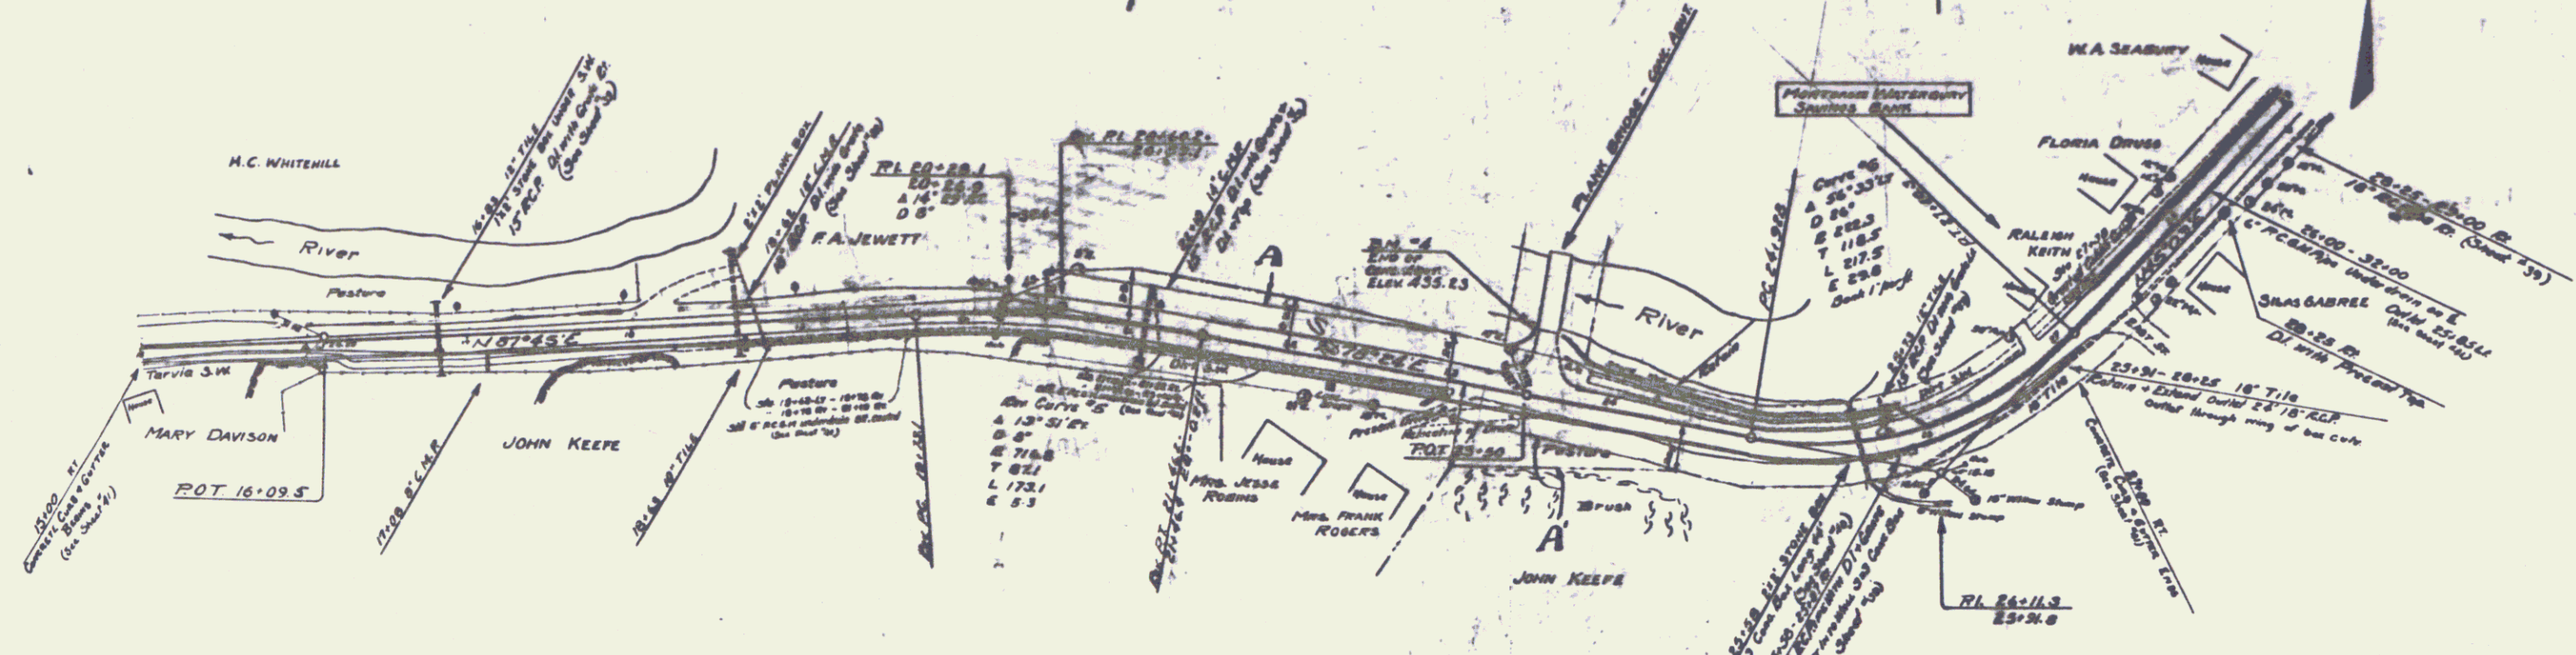

SERIES F No. 16-B
 SHEET 3 OF 122 SHEETS
 3