
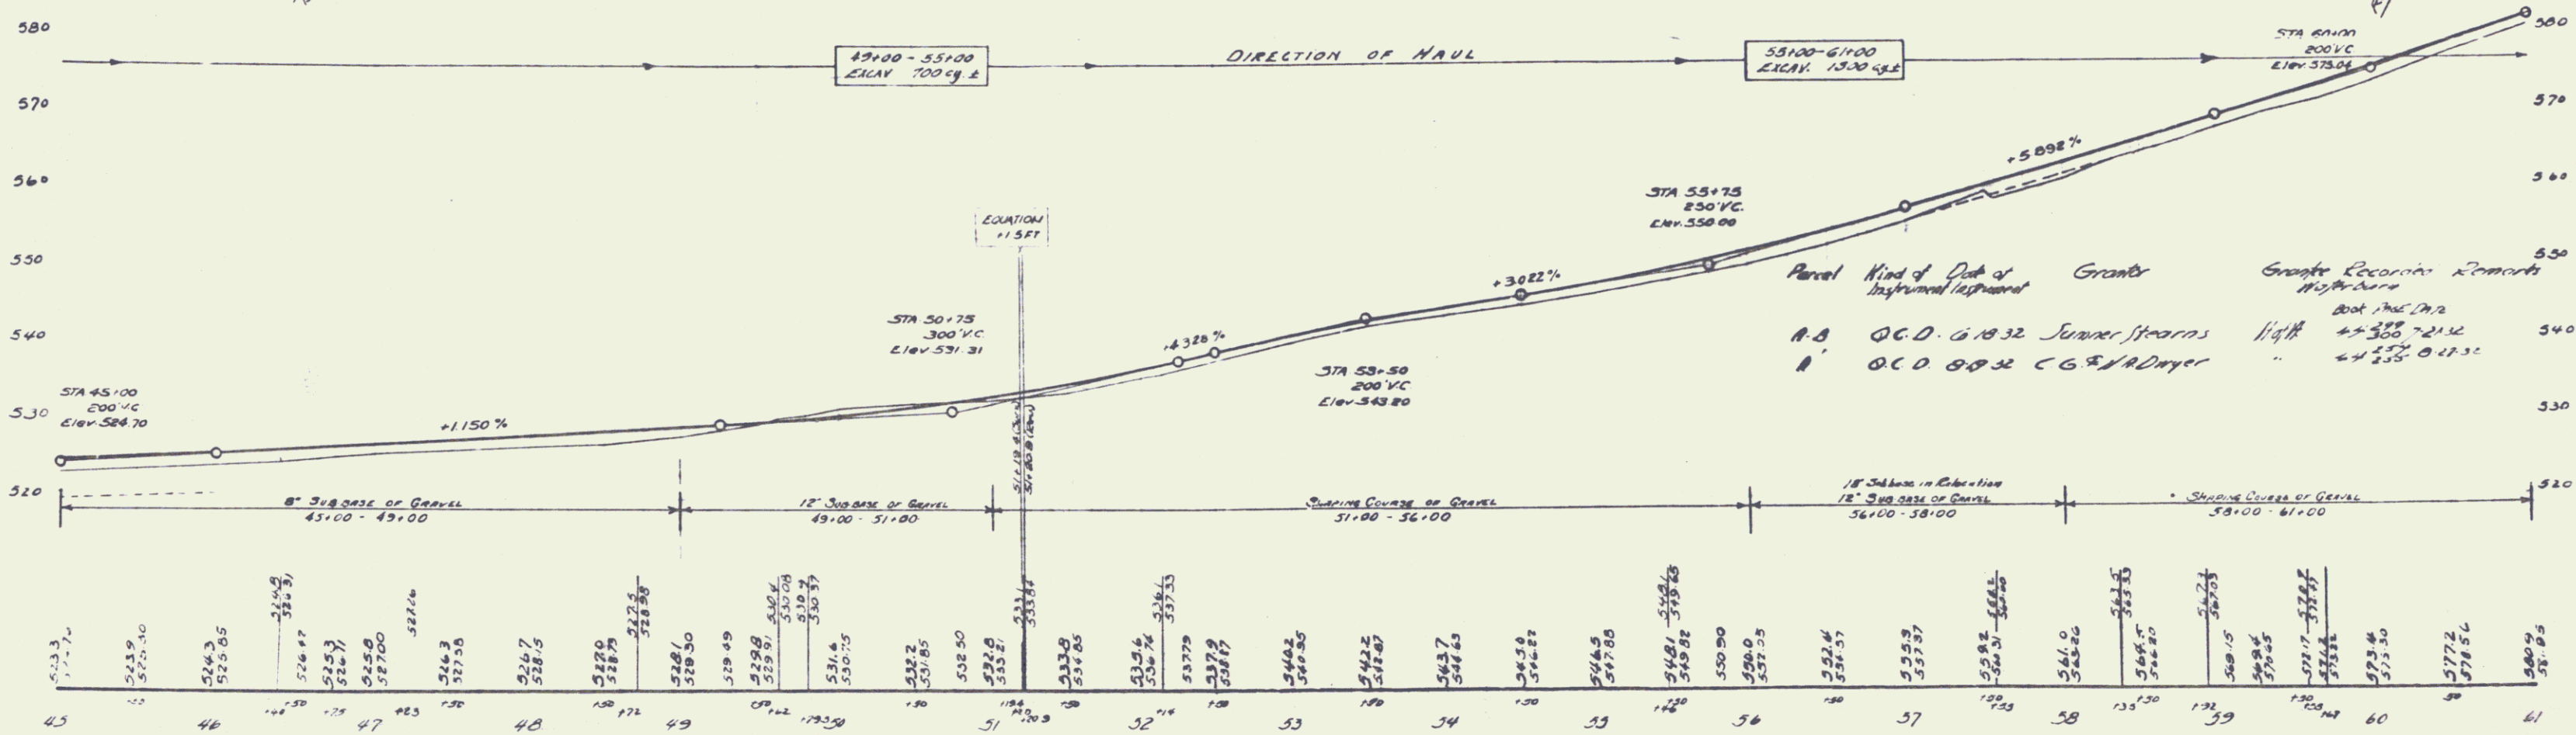


POOR ORIGINAL COPY

FILE NO. 116-B 1932 7 122

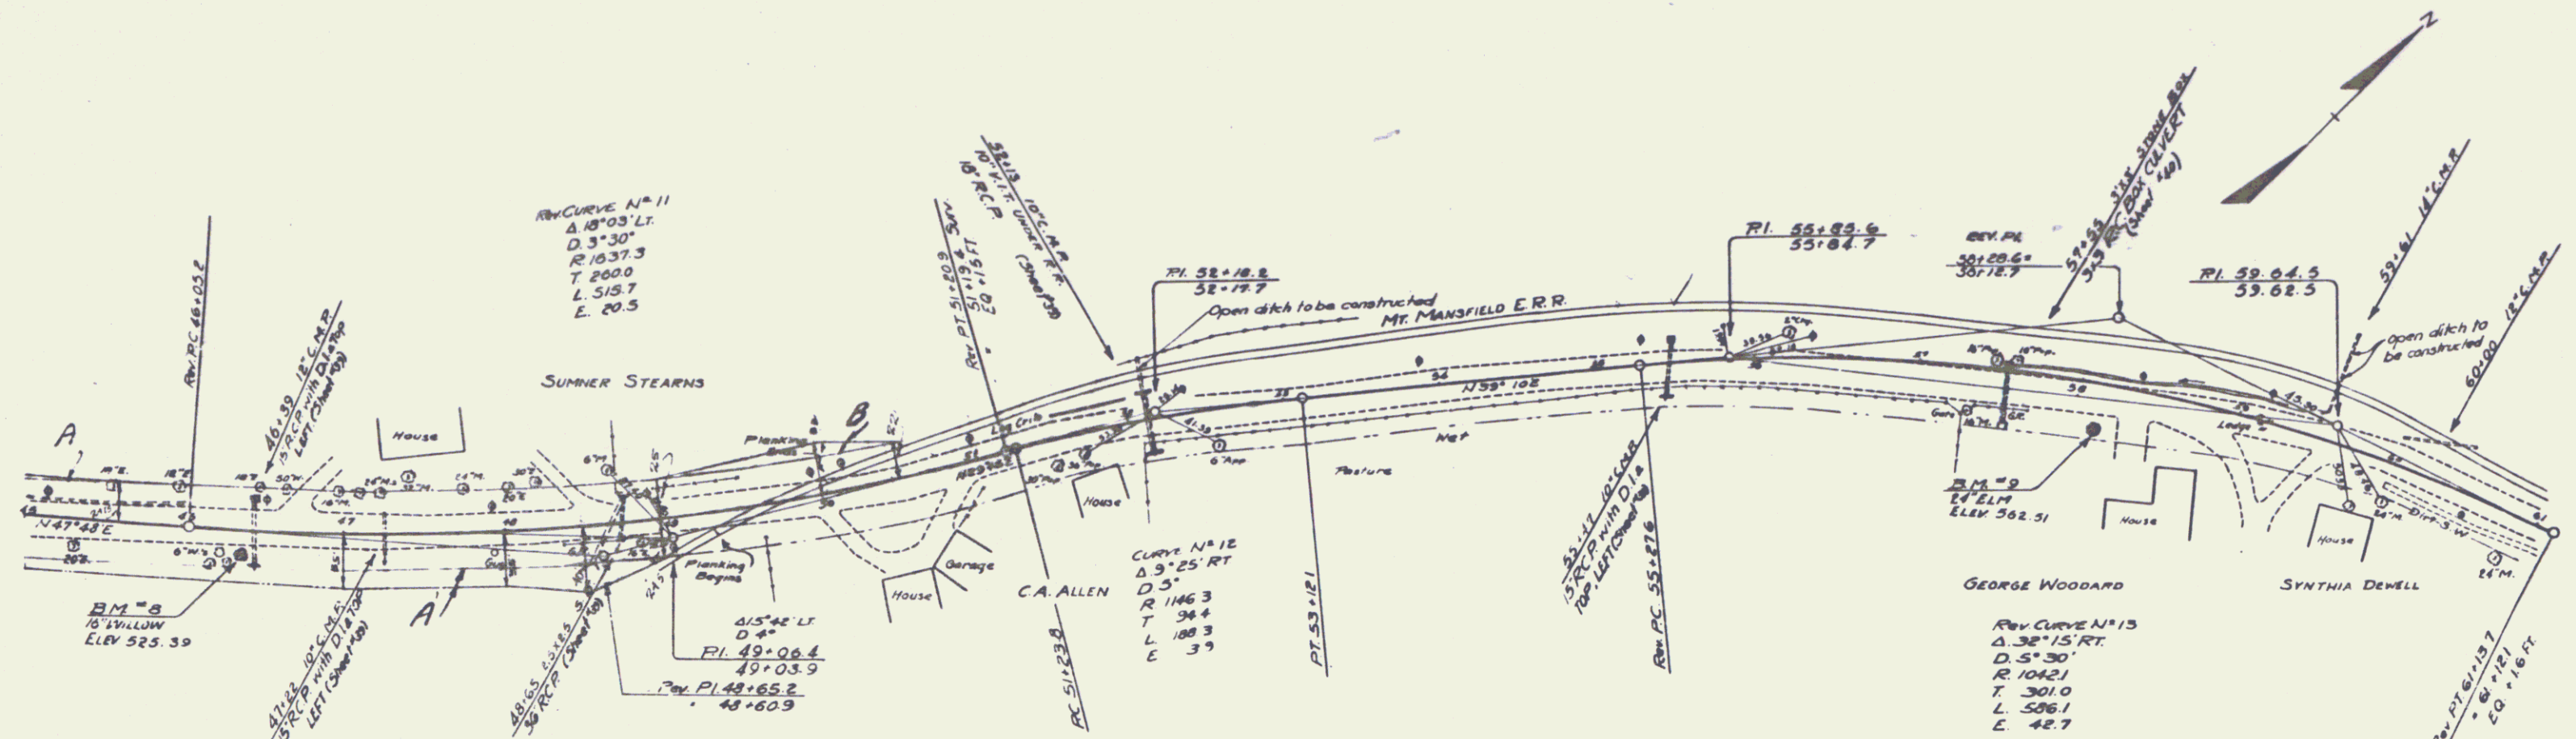

B.M. No. 8 SPIKE IN ROOT OF 16" WILLOW 14' RT. OF STA. 46+30 ELEV. 525.39  
 B.M. No. 9 SPIKE IN ROOT OF 24' ELM 15' RT. OF STA. 38+12 ELEV. 562.51

Parcel Map of Data of Grantor  
 A-B O.C.D. 6/10/32 Sumner Stearns  
 A' O.C.D. 8/8/32 C.G.S./R. Dwyer

SERIES F No. 116-B  
 SHEET 7 OF 122 SHEETS