

PLAN
 DATE: 11/1/51
 DRAWN BY: [unclear]
 CHECKED BY: [unclear]
 SCALE: 1" = 40'

PROFILE
 DATE: 11/1/51
 DRAWN BY: [unclear]
 CHECKED BY: [unclear]
 SCALE: 1" = 10'

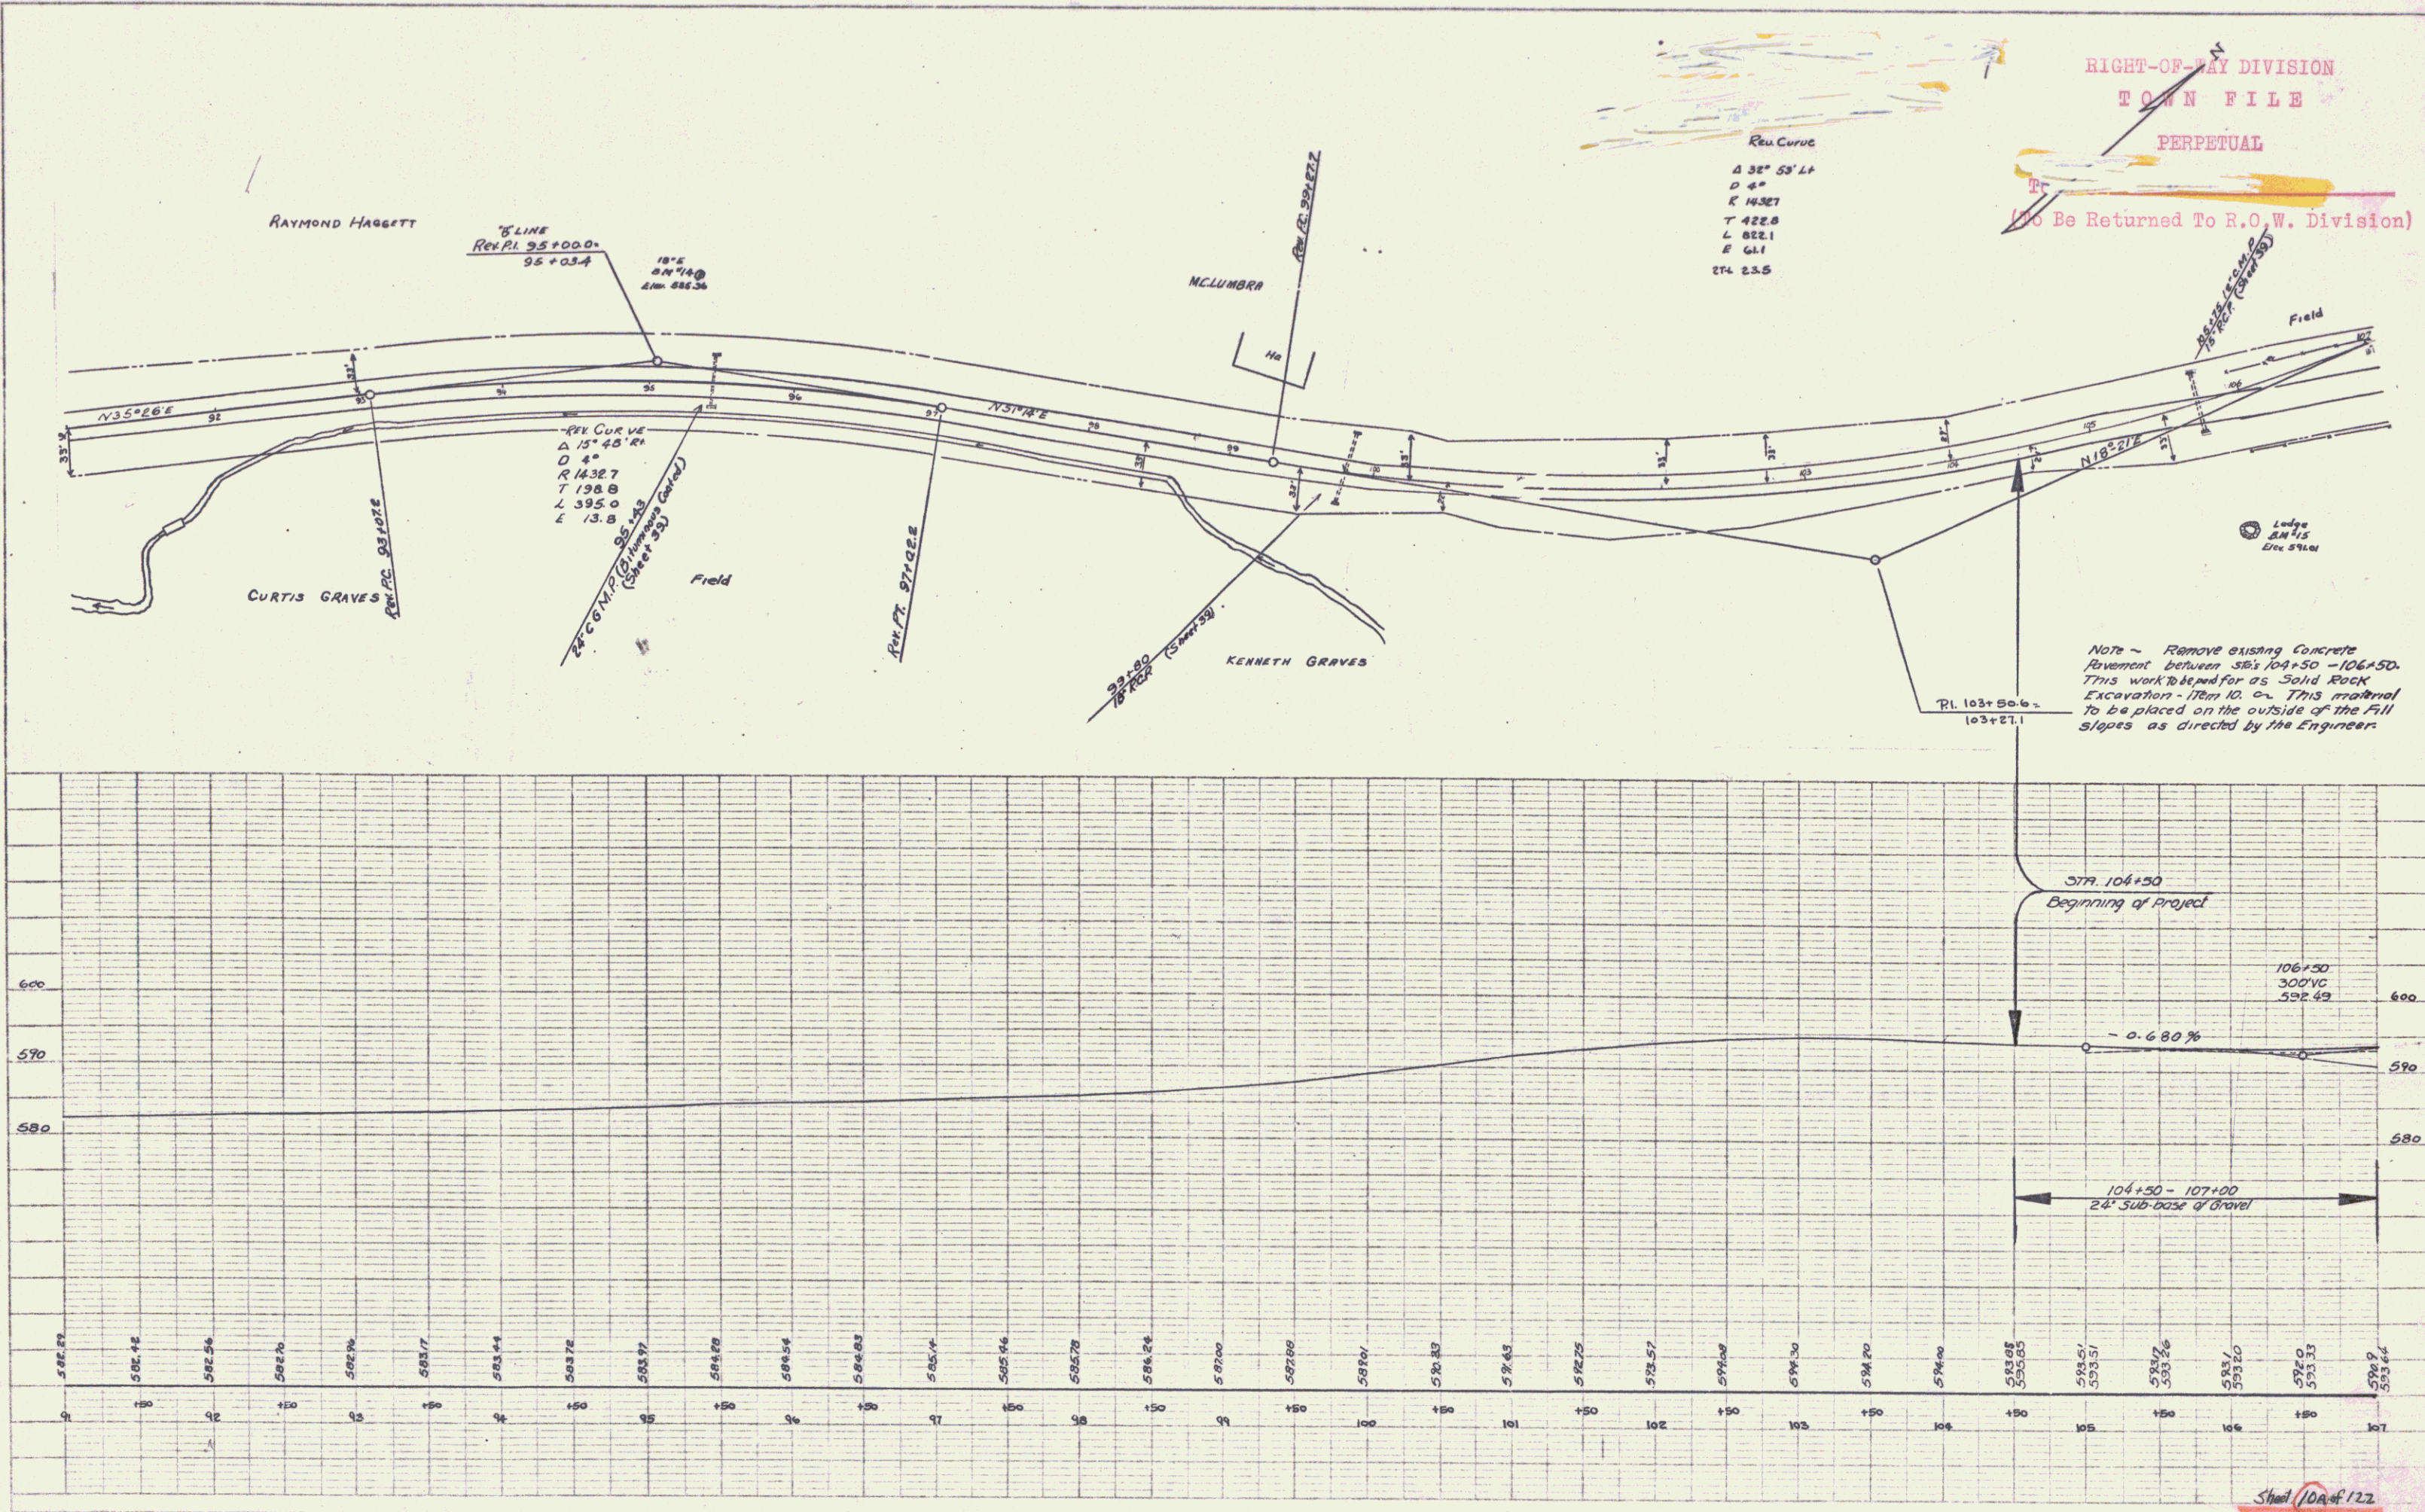


PLATE 1 - PLAN AND PROFILE OF ROAD
 HAYDEN ENGINEERING CO., INC.
 112 E. 10th Street, Denver, Colorado