


Parcel Kind of Date of Instrument

Parcel	Kind of Instrument	Date	Grantor	Grantee	Recorded	Notary
A	Q.C.D.	6-29-32	Frank A. Colson	Clarence Moody	4911	504
A	Q.C.D.	3-2-33	Anna Watts	Anna Watts	4911	7-21-32
A	Q.C.D.	7-22-32	D.C. & W.A. Hayes	Dean C. Hayes	4911	7-23-32

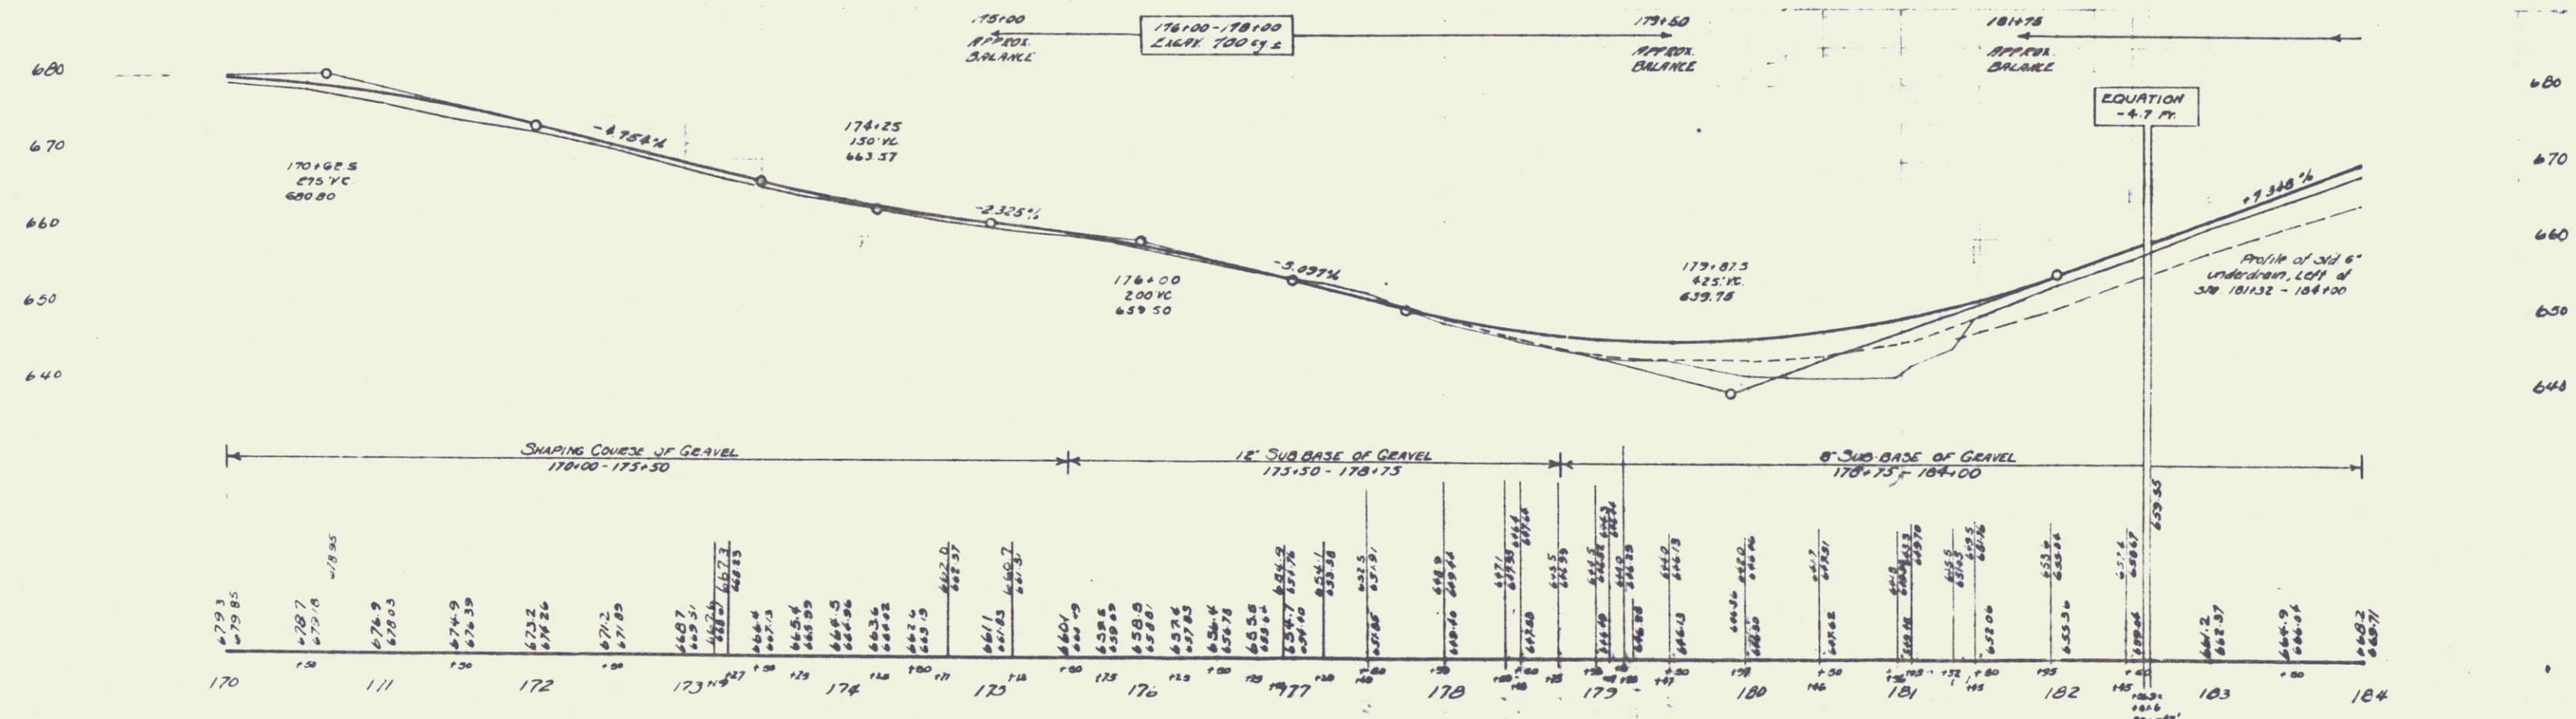

Station	Elevation	Notes
170	679.85	
171	679.7	
172	678.9	
173	678.2	
174	677.5	
175	676.8	
176	676.1	
177	675.4	
178	674.7	
179	674.0	
180	673.3	
181	672.6	
182	671.9	
183	671.2	
184	670.5	

BM 24 -- U.S.G.S. B.M. - Lease - 20' Rr Sta 177+51 - E1 654 82